

PLAN	BY	DATE
SURVEYED	PENNIMAN	55
ADJUSTED	FROST	56
TRACED	W. L. OTHERS	58

\* BITUMINOUS CONCRETE CURB, ITEM 555  
STA 2220+00 TO STA 2222+00

CLEARING AND TRIMMING, ITEM 601  
STA 2219+00 TO STA 2220+00 S.B.

\* THREE CABLE GUARD RAIL WITH STEEL POSTS, ITEM 543  
NORTHBOUND  
STA 2220+00 TO STA 2221+68 LT  
SOUTHBOUND  
STA 2219+00 TO STA 2220+00 M.L.


CHANNEL EXCAVATION, ITEM 106  
STA 2220+00 TO STA 2221+10 RT NB  
M.P. 50

STONE FILL FOR SLOPE PROTECTION, ITEM 522  
STA 2220+00 TO STA 2221+10 RT NB

GRANITE SLOPE EDGINGS, ITEM 556-A  
STA 2220+26 TO 2220+75 NB RT.


PROPERTY LINE FENCE W/STEEL POSTS  
2216+47-2220+00 S.B. LT.

RAMP C  
TO STA 5+69 RT  
RAMP B  
STA 0+00 TO STA 2+40 RT

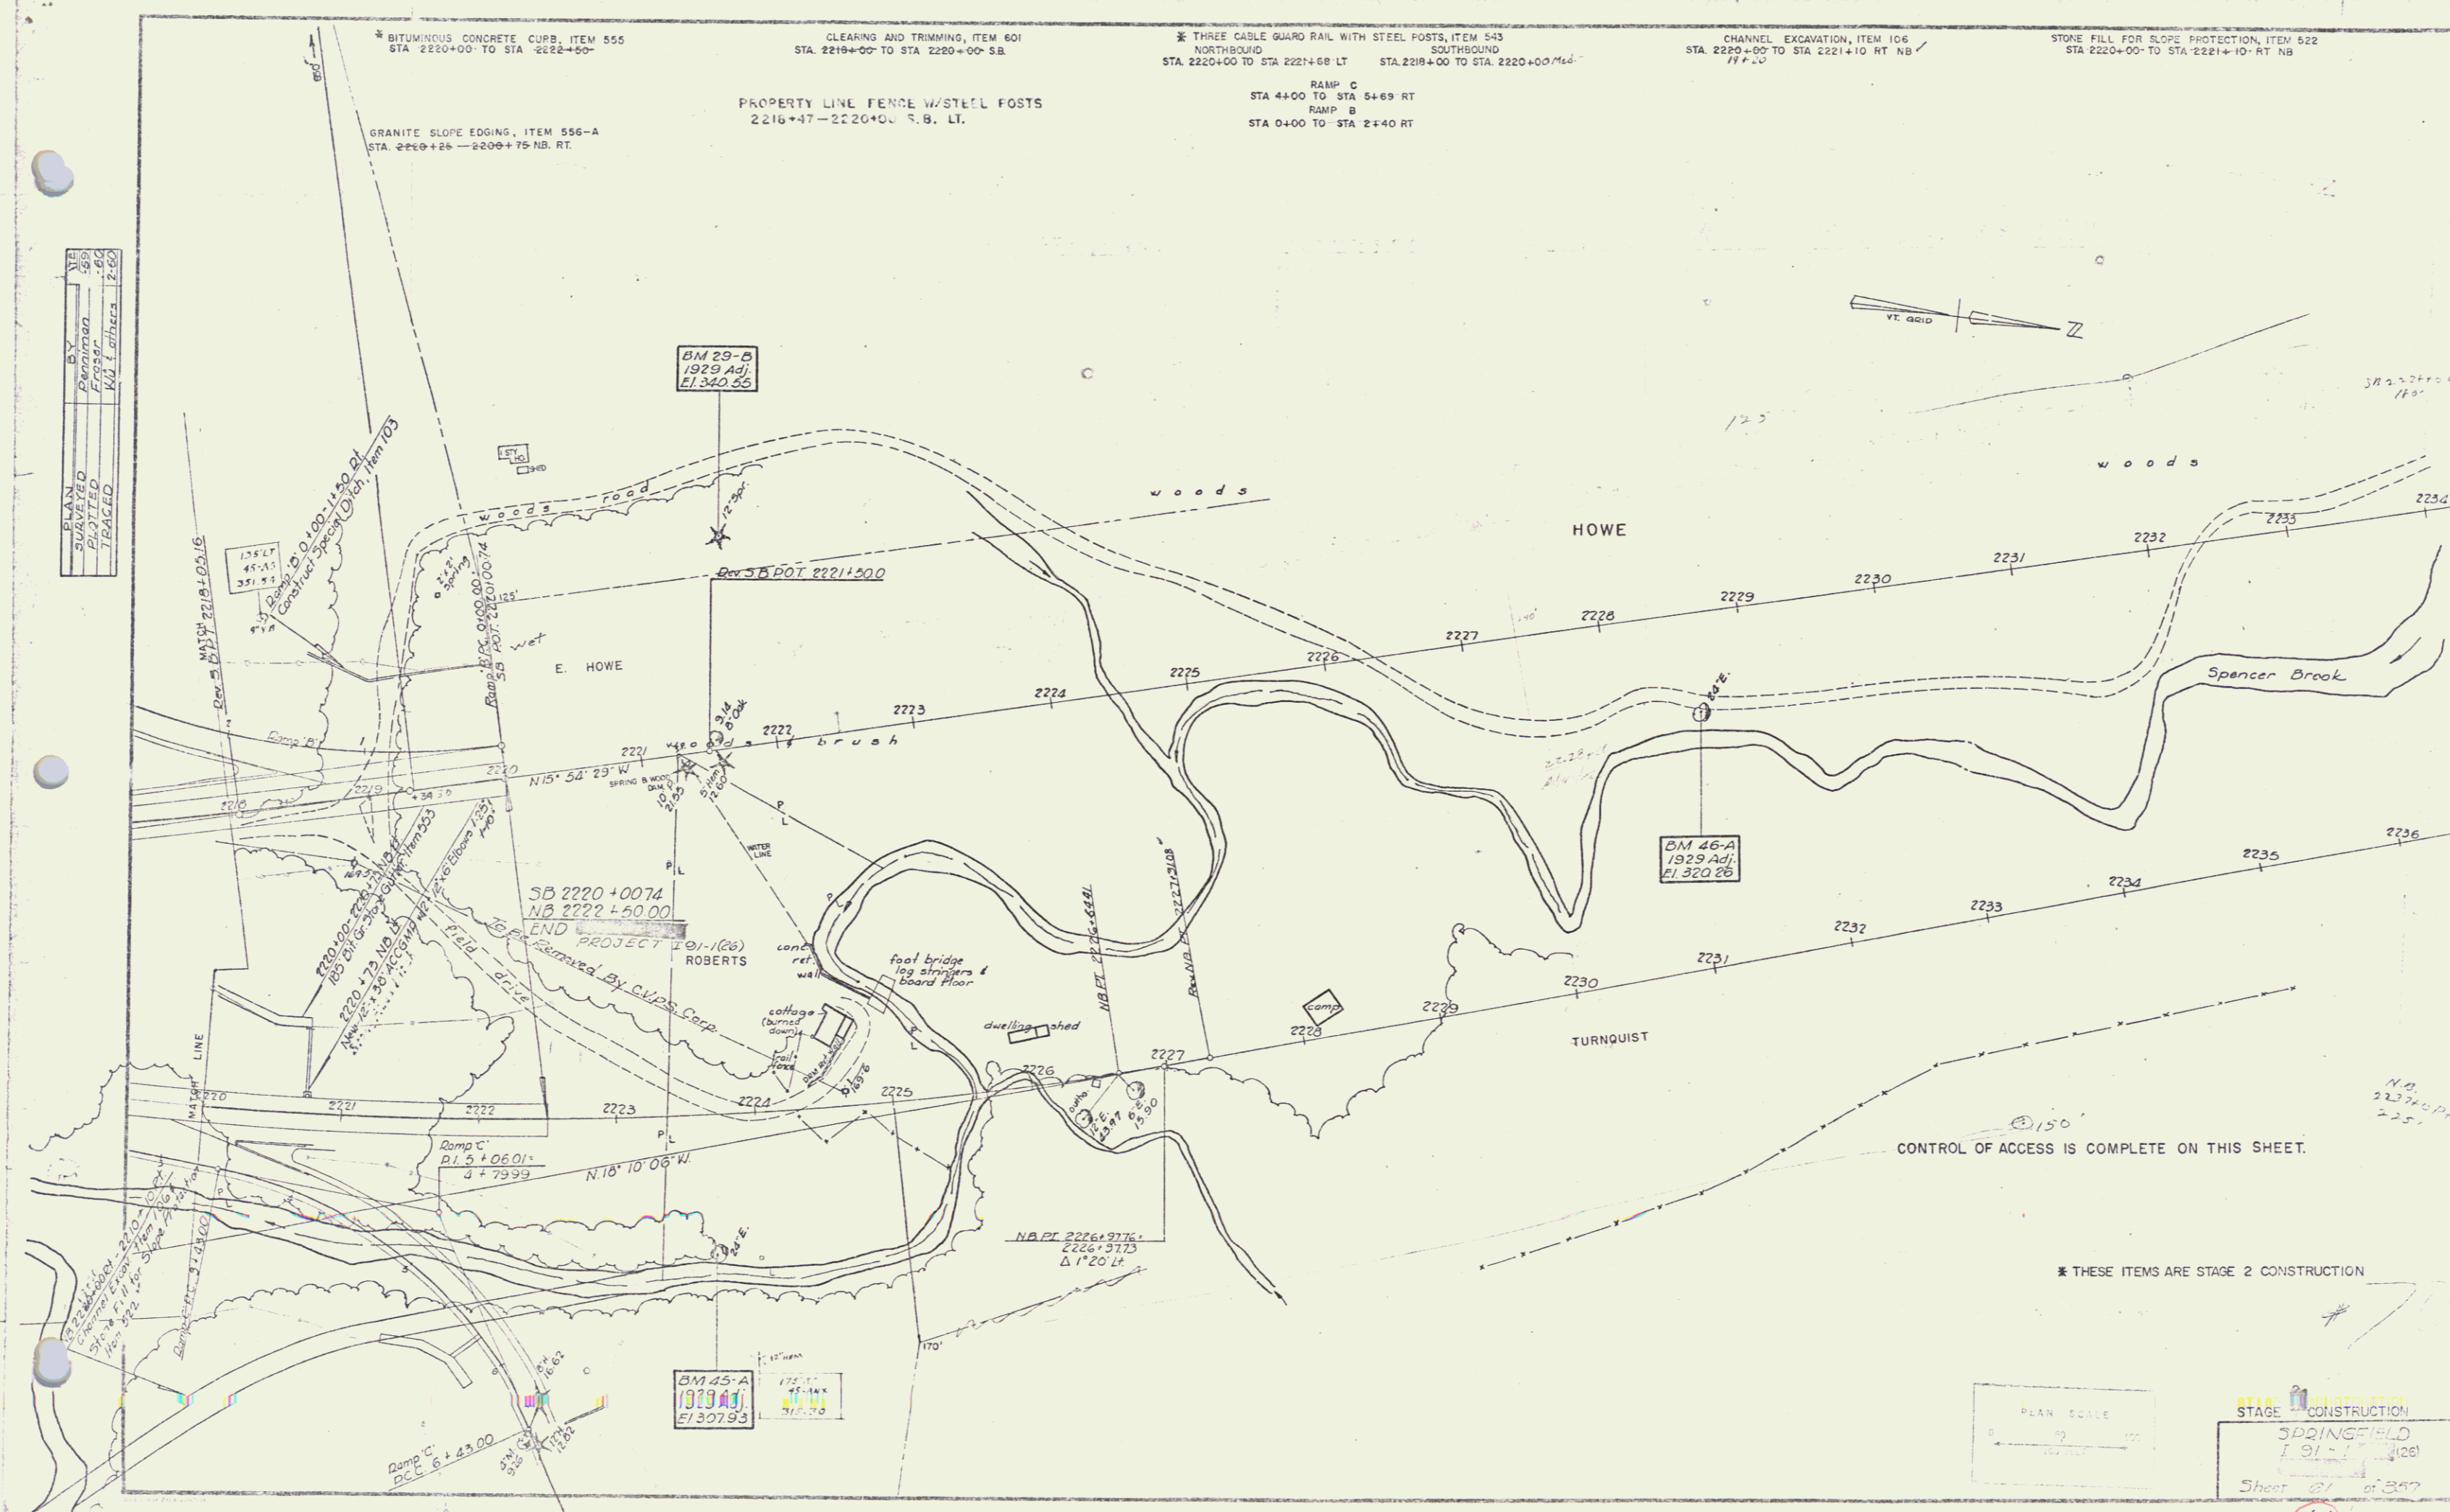

CONTROL OF ACCESS IS COMPLETE ON THIS SHEET.

\* THESE ITEMS ARE STAGE 2 CONSTRUCTION

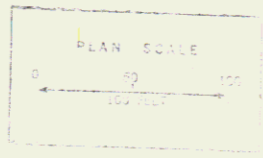

STAGE 2 CONSTRUCTION  
SPRINGFIELD  
I 91-1 (126)  
Sheet 61 of 357

Sheet 61