


PLAN  
 SUBMITTED BY  
 PREPARED BY  
 PLOTTED BY  
 CHECKED BY

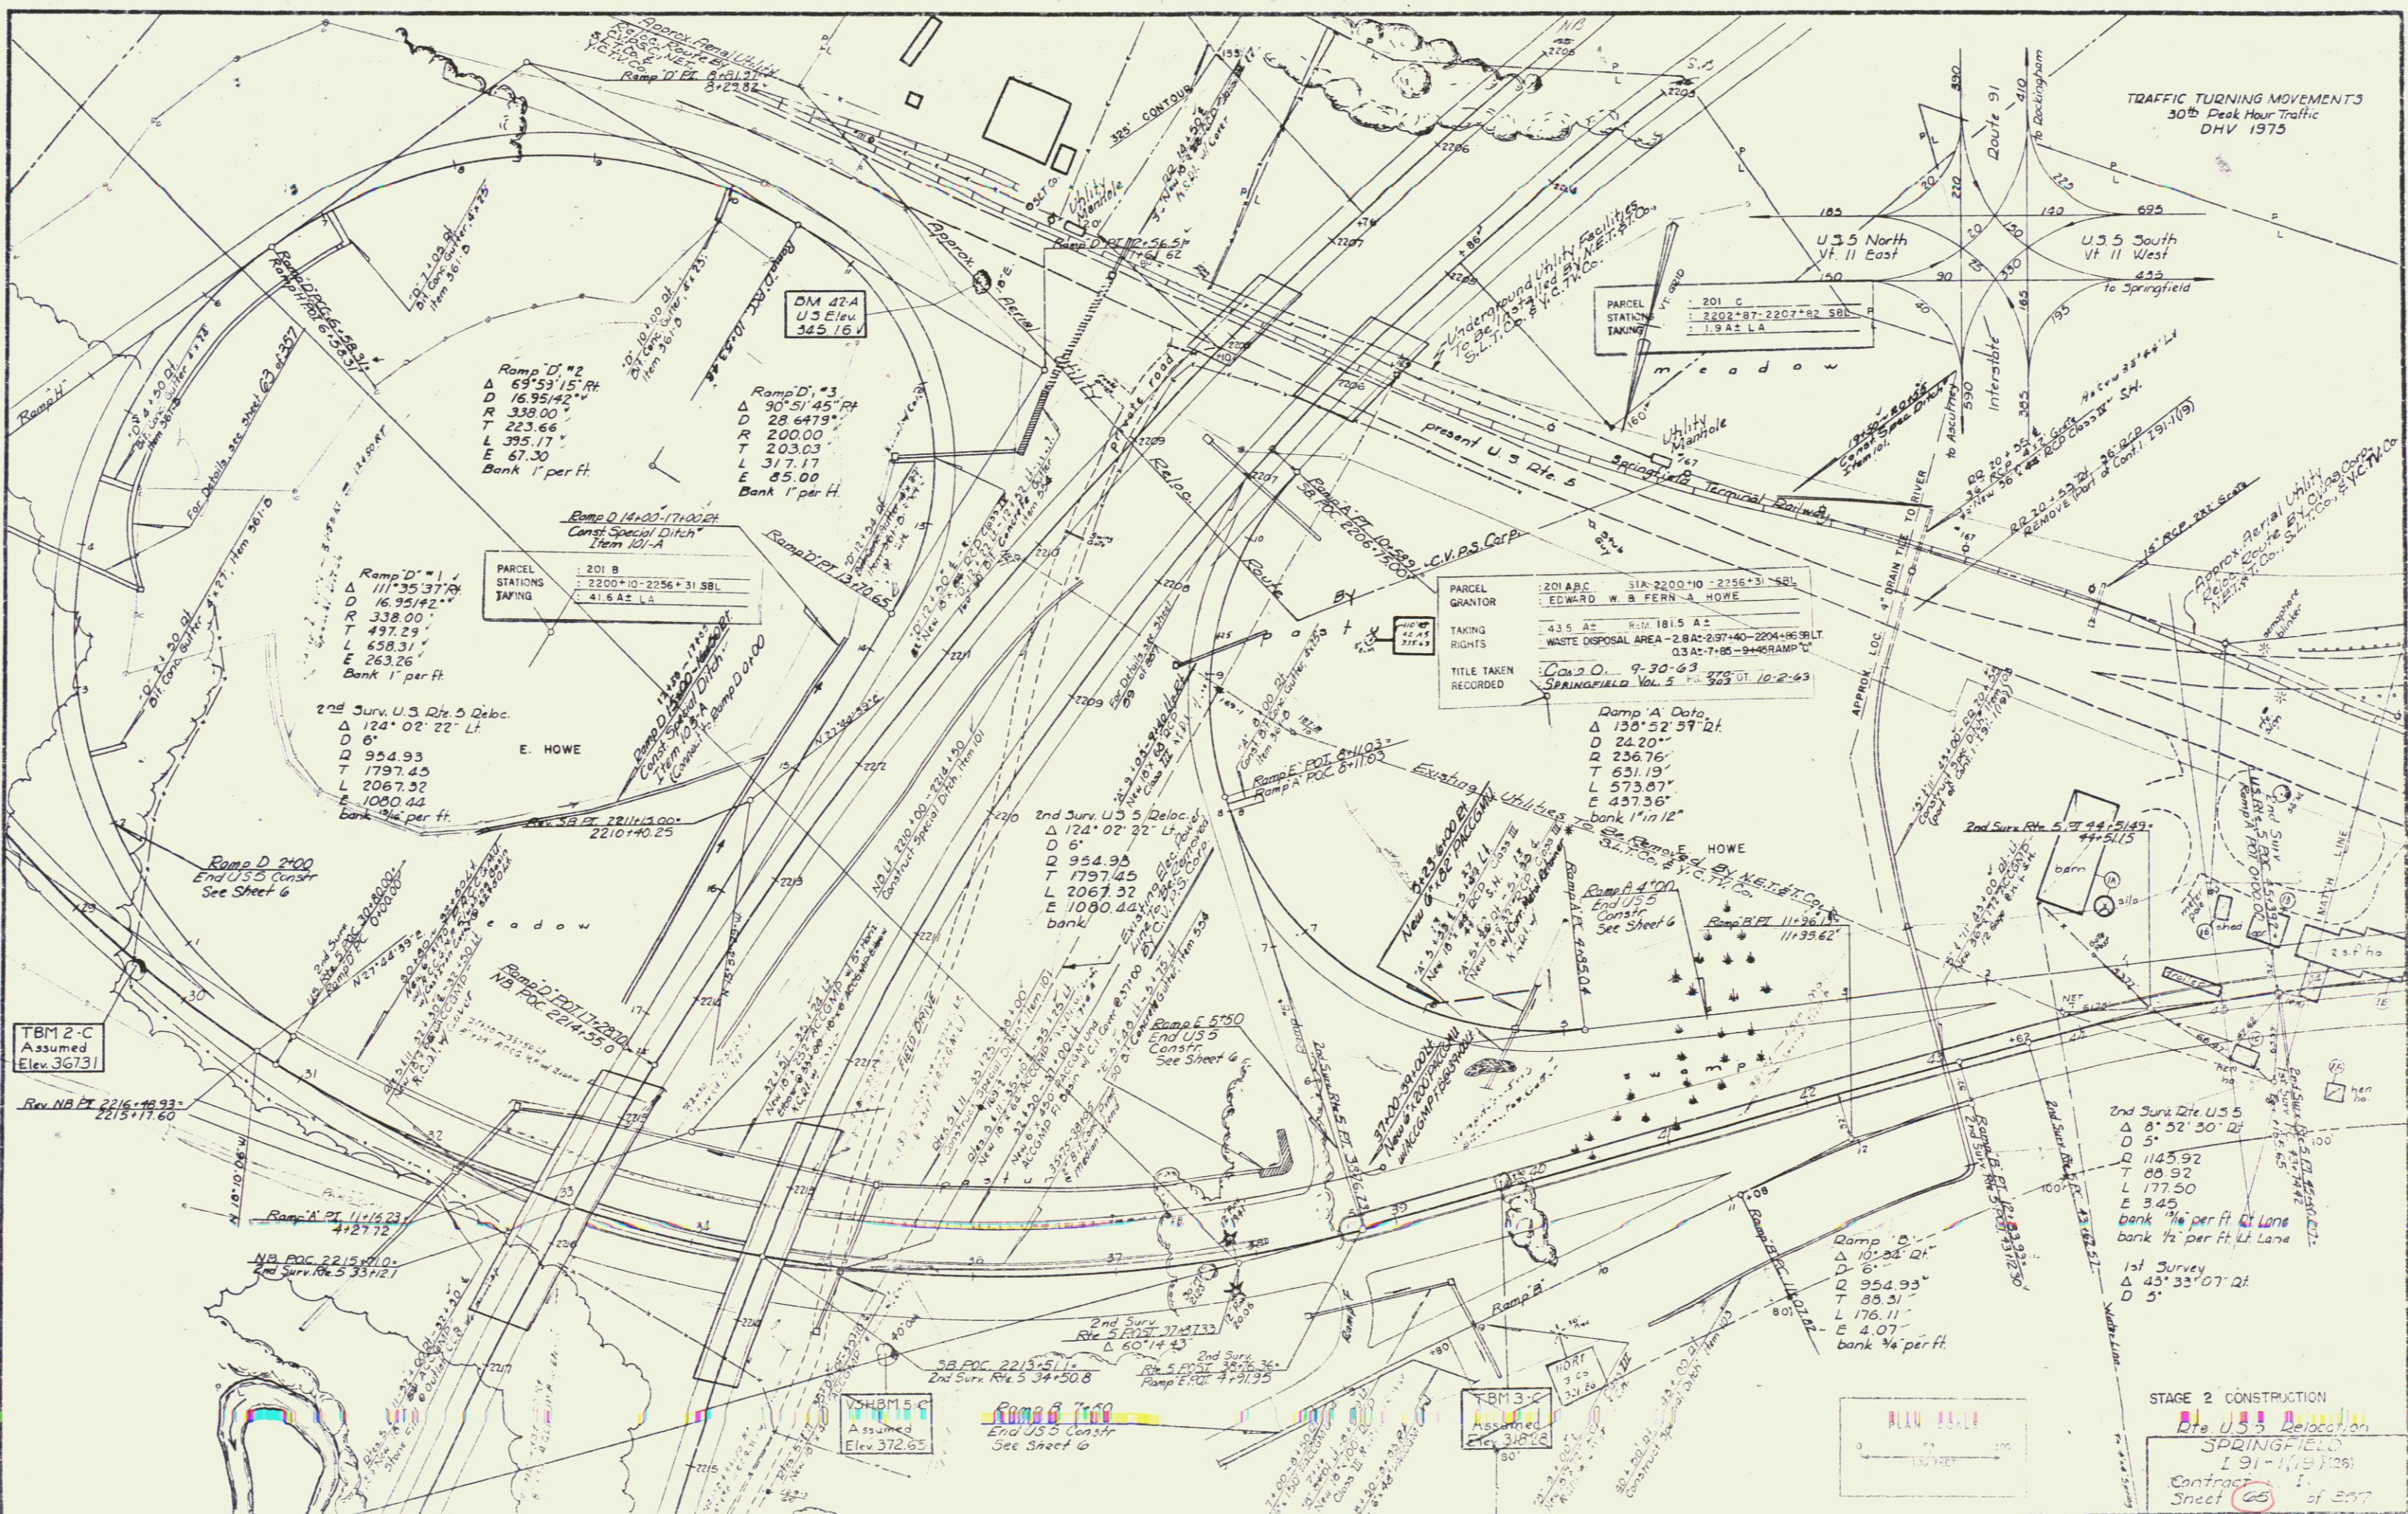

STAGE 2 CONSTRUCTION  
 U.S. 5 Relocation  
 SPRINGFIELD  
 191-115 Mass  
 Contract  
 Sheet 65 of 207