

INDEX OF SHEETS

1	TITLE SHEET
2	ALIGNMENT DATA SHEET
3-4	TYPICAL SHEETS, MAINLINE
5	QUANTITY SHEET, STAGE 2 CONSTRUCTION
6-8	DRAINAGE SHEETS
9-16	EARTHWORK AND GRADE
17-38	PLAN AND PROFILE SHEETS, MAINLINE
39	BLANK
40	BLANK
41	A-61 SOLID ROCK EXCAVATION
42	B-1 BANKING TABLES
43	B-5 TYPICAL SLOPE GRADING
44	BLANK
45	B-15 ENTRANCE AND EXIT TERMINALS
46	B-17 DETAIL OF U-TURN
47	C-1 CURBS
48	D-2 UNDERDRAIN AND HEADWALLS
49	D-3 GUTTERS
50	D-4 ELBOWS, FLUSHING BASINS, & METAL END SECTIONS
51	BLANK
52	BLANK
53	D-8 DROP INLETS
54	D-10 DROP INLET TOPS AND COVERS
55	D-11 DETAIL OF GRATES AND COVERS
56	D-13 CONCRETE CATCH BASINS
57	D-16 PRECAST REINFORCED CONCRETE CURB DROP INLET
58	E-1 BARRICADES, SIGNS AND LIGHTS (ROADWAY)
59	E-5A SIGN POST FOOTINGS
60	E-11 INTERSTATE ROUTE MARKERS
61	E-12 US ROUTE MARKERS
62	E-13 STATE ROUTE MARKERS
63	E-14 REGULATORY SIGNS
64	E-17 GUIDE SIGNS
65	E-19 STANDARD SIGN
66-70	BLANK
71	E-20 DELINEATORS AND MILEPOSTS
72	E-31 CONSTRUCTION IDENTIFICATION SIGNS
73	G-1 STANDARD STEEL BEAM GUARD RAIL
74	G-3 THREE CABLE GUARD RAIL WITH STEEL POSTS
75	J-1 PROJECT AND BOUNDARY MARKERS
76	J-4 FIELD OFFICE
77	TRAFFIC SIGN, SYMBOL SHEET
78	TRAFFIC SIGN, LOCATION SHEET
79	TRAFFIC SIGNS, DESIGN AND CONSTRUCTION DETAILS
80-83	BLANK
84-88	SOUTHBOUND CROSS-SECTIONS
183-282	NORTHBOUND CROSS-SECTIONS

STATE OF VERMONT
DEPARTMENT OF HIGHWAYS

PROPOSED IMPROVEMENT



TOWN OF SPRINGFIELD
COUNTY OF WINDSOR
INTERSTATE ROUTE 91
BELLOWS FALLS-WHITE RIVER JCT. ROAD

P.A. # 99R047

BEGINNING AT A POINT APPROXIMATELY 2540 MILES
NORTHERLY OF THE WINDHAM - WINDSOR COUNTY
LINE AND EXTENDING NORTHERLY 3.081 MILES.
LENGTH OF ROADWAY 16,266.87 FEET = 3.081 MILES
LENGTH OF CONTRACT 16,266.87 FEET = 3.081 MILES


TRAFFIC DATA

1966	ADT	5 320
1966	ADT	10 410
1966	D.V.V.	4.45
	D	81%
	T	1%
	V	40MPH

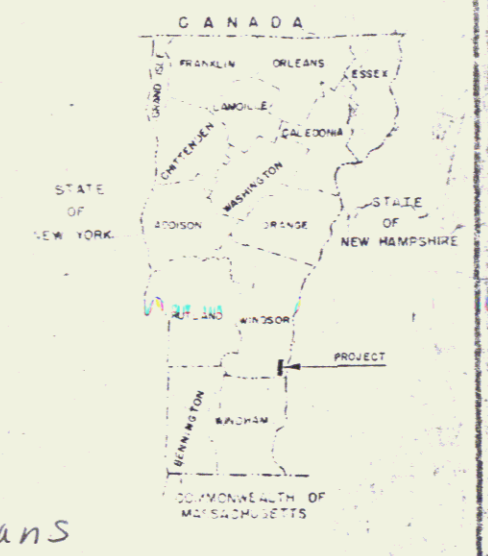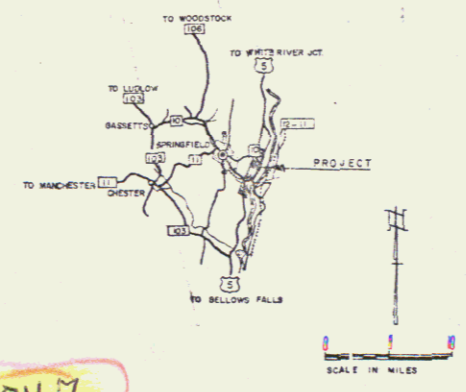

RIGHT-OF-WAY
and Construction Plans

DE
2/1/62

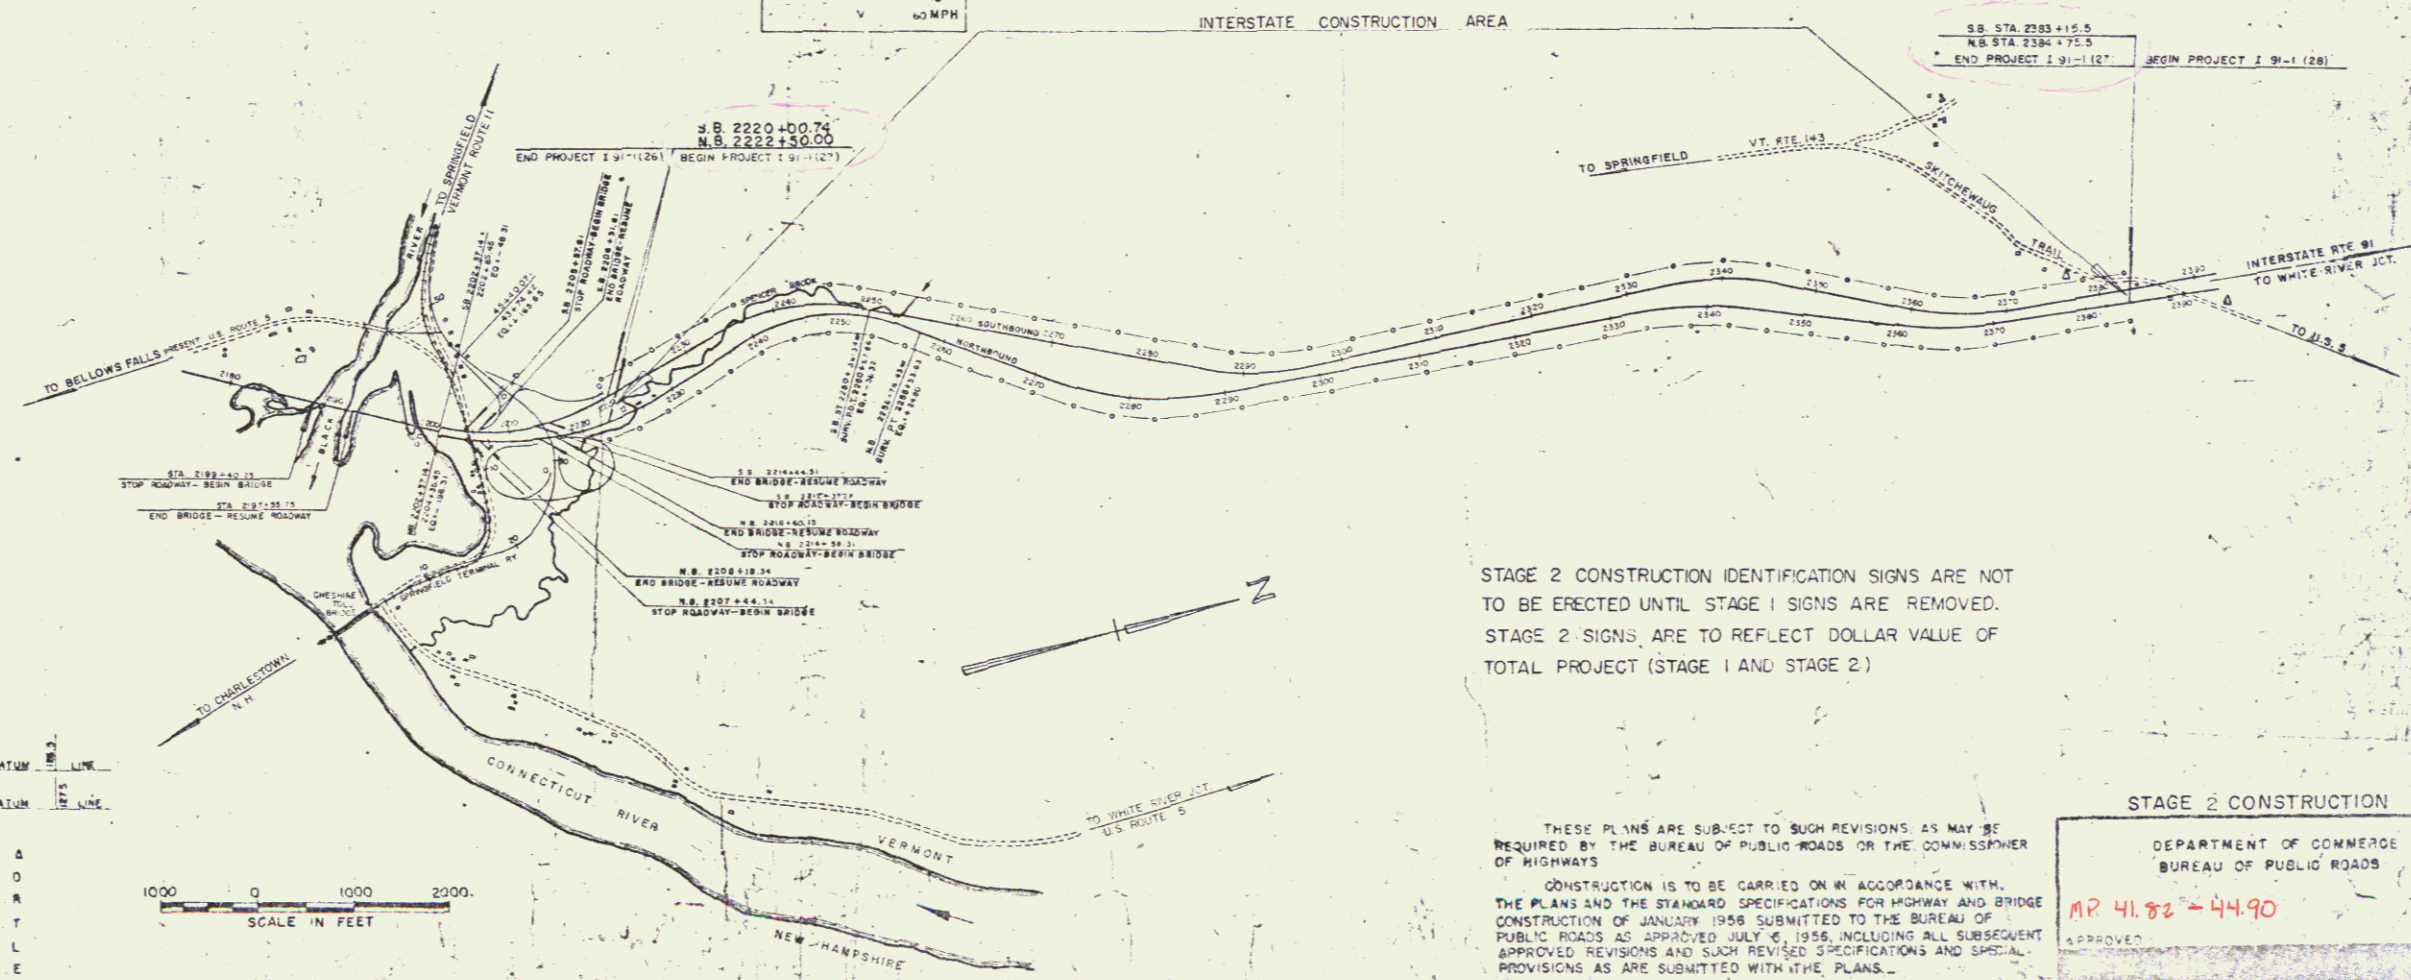

STAGE 2 CONSTRUCTION IDENTIFICATION SIGNS ARE NOT
TO BE ERECTED UNTIL STAGE 1 SIGNS ARE REMOVED.
STAGE 2 SIGNS ARE TO REFLECT DOLLAR VALUE OF
TOTAL PROJECT (STAGE 1 AND STAGE 2)

THESE PLANS ARE SUBJECT TO SUCH REVISIONS AS MAY BE
REQUIRED BY THE BUREAU OF PUBLIC ROADS OR THE COMMISSIONER
OF HIGHWAYS
CONSTRUCTION IS TO BE CARRIED ON IN ACCORDANCE WITH
THE PLANS AND THE STANDARD SPECIFICATIONS FOR HIGHWAY AND BRIDGE
CONSTRUCTION OF JANUARY 1956 SUBMITTED TO THE BUREAU OF
PUBLIC ROADS AS APPROVED JULY 6, 1956, INCLUDING ALL SUBSEQUENT
APPROVED REVISIONS AND SUCH REVISED SPECIFICATIONS AND SPECIAL
PROVISIONS AS ARE SUBMITTED WITH THE PLANS.

STAGE 2 CONSTRUCTION

DEPARTMENT OF COMMERCE
BUREAU OF PUBLIC ROADS

APPROVED
M.P. 41.82 - 44.90

DIVISION ENGINEER

PROJECT 1 NO. 91- (287)

SHEET 1 OF 282 SHEETS

CONVENTIONAL SIGNS

COUNTY LINE	---
TOWN LINE	---
FENCE LINE	---
STONE WALL	---
UNFENCED PROPERTY	---
GUARD RAIL	---
TRAVELED WAY	---
RAILROAD	---
RETAINING WALL	---
CENTER LINE	---
SUBMIT LINE	---
CONVERT	---
TRAILER POLE	---
POWER POLE	---
TELEPHONE POLE	---
TREES	---
WEDGE	---
CONTROL OF ACCESS	---

GROUND ELEVATION DATUM

GRADE ELEVATION DATUM

CURVE DATA

DEFLECTION OF ANGLE	Δ
DEGREE OF CURVE	D
RADIUS OF CURVE	R
TANGENT DISTANCE	T
LENGTH OF CURVE	L
EXTERNAL DISTANCE	E
POINT OF INTERSECTION	PI
POINT OF CURVE	PC
POINT OF TANGENT	PT
POINT ON TANGENT	POT
POINT ON SUB-TANGENT	POST

APPROVED <i>R.H. [Signature]</i> DATE 8/22/62	APPROVED <i>E.H. [Signature]</i> DATE 11/1/62	APPROVED <i>L.M. [Signature]</i> DATE 3/14/62	APPROVED <i>F.S. [Signature]</i> DATE 3-20-62	APPROVED <i>R.M. [Signature]</i> DATE 3/14/62	APPROVED <i>A.S. [Signature]</i> DATE 3/14/62
--	--	--	--	--	--