

|          |         |    |
|----------|---------|----|
| PLAN     | BY      | 40 |
| Surveyed | Planned | 40 |
| Plotted  | Erased  | 40 |
| Traced   | K/O     | 40 |

\* THESE ITEMS STAGE 2 CONSTRUCTION


\* 3 Cable Guard Rail w/ Steel Posts  
 S.B. 2234+00 - 2237+60 S.F.  
 S.B. 2234+00 - 2250+00 L.F.  
 N.B. 2236+00 - 2237+60 L.F.  
 N.B. 2244+95 - 2252+00 L.F.

Hemlock Construct Special Ditch  
 N.B. 2236+00 - 2237+50 R.F.

\* Bituminous Concrete Curb  
 Item 603  
 S.B. 2234+00 - 2237+60 L.F.  
 S.B. 2234+00 - 2234+25 L.F.

Clearing and Trimming  
 Item 601  
 2234+00 - 2247+15 S.B.

NOTE: CONTROL OF ACCESS IS COMPLETE ON THIS SHEET

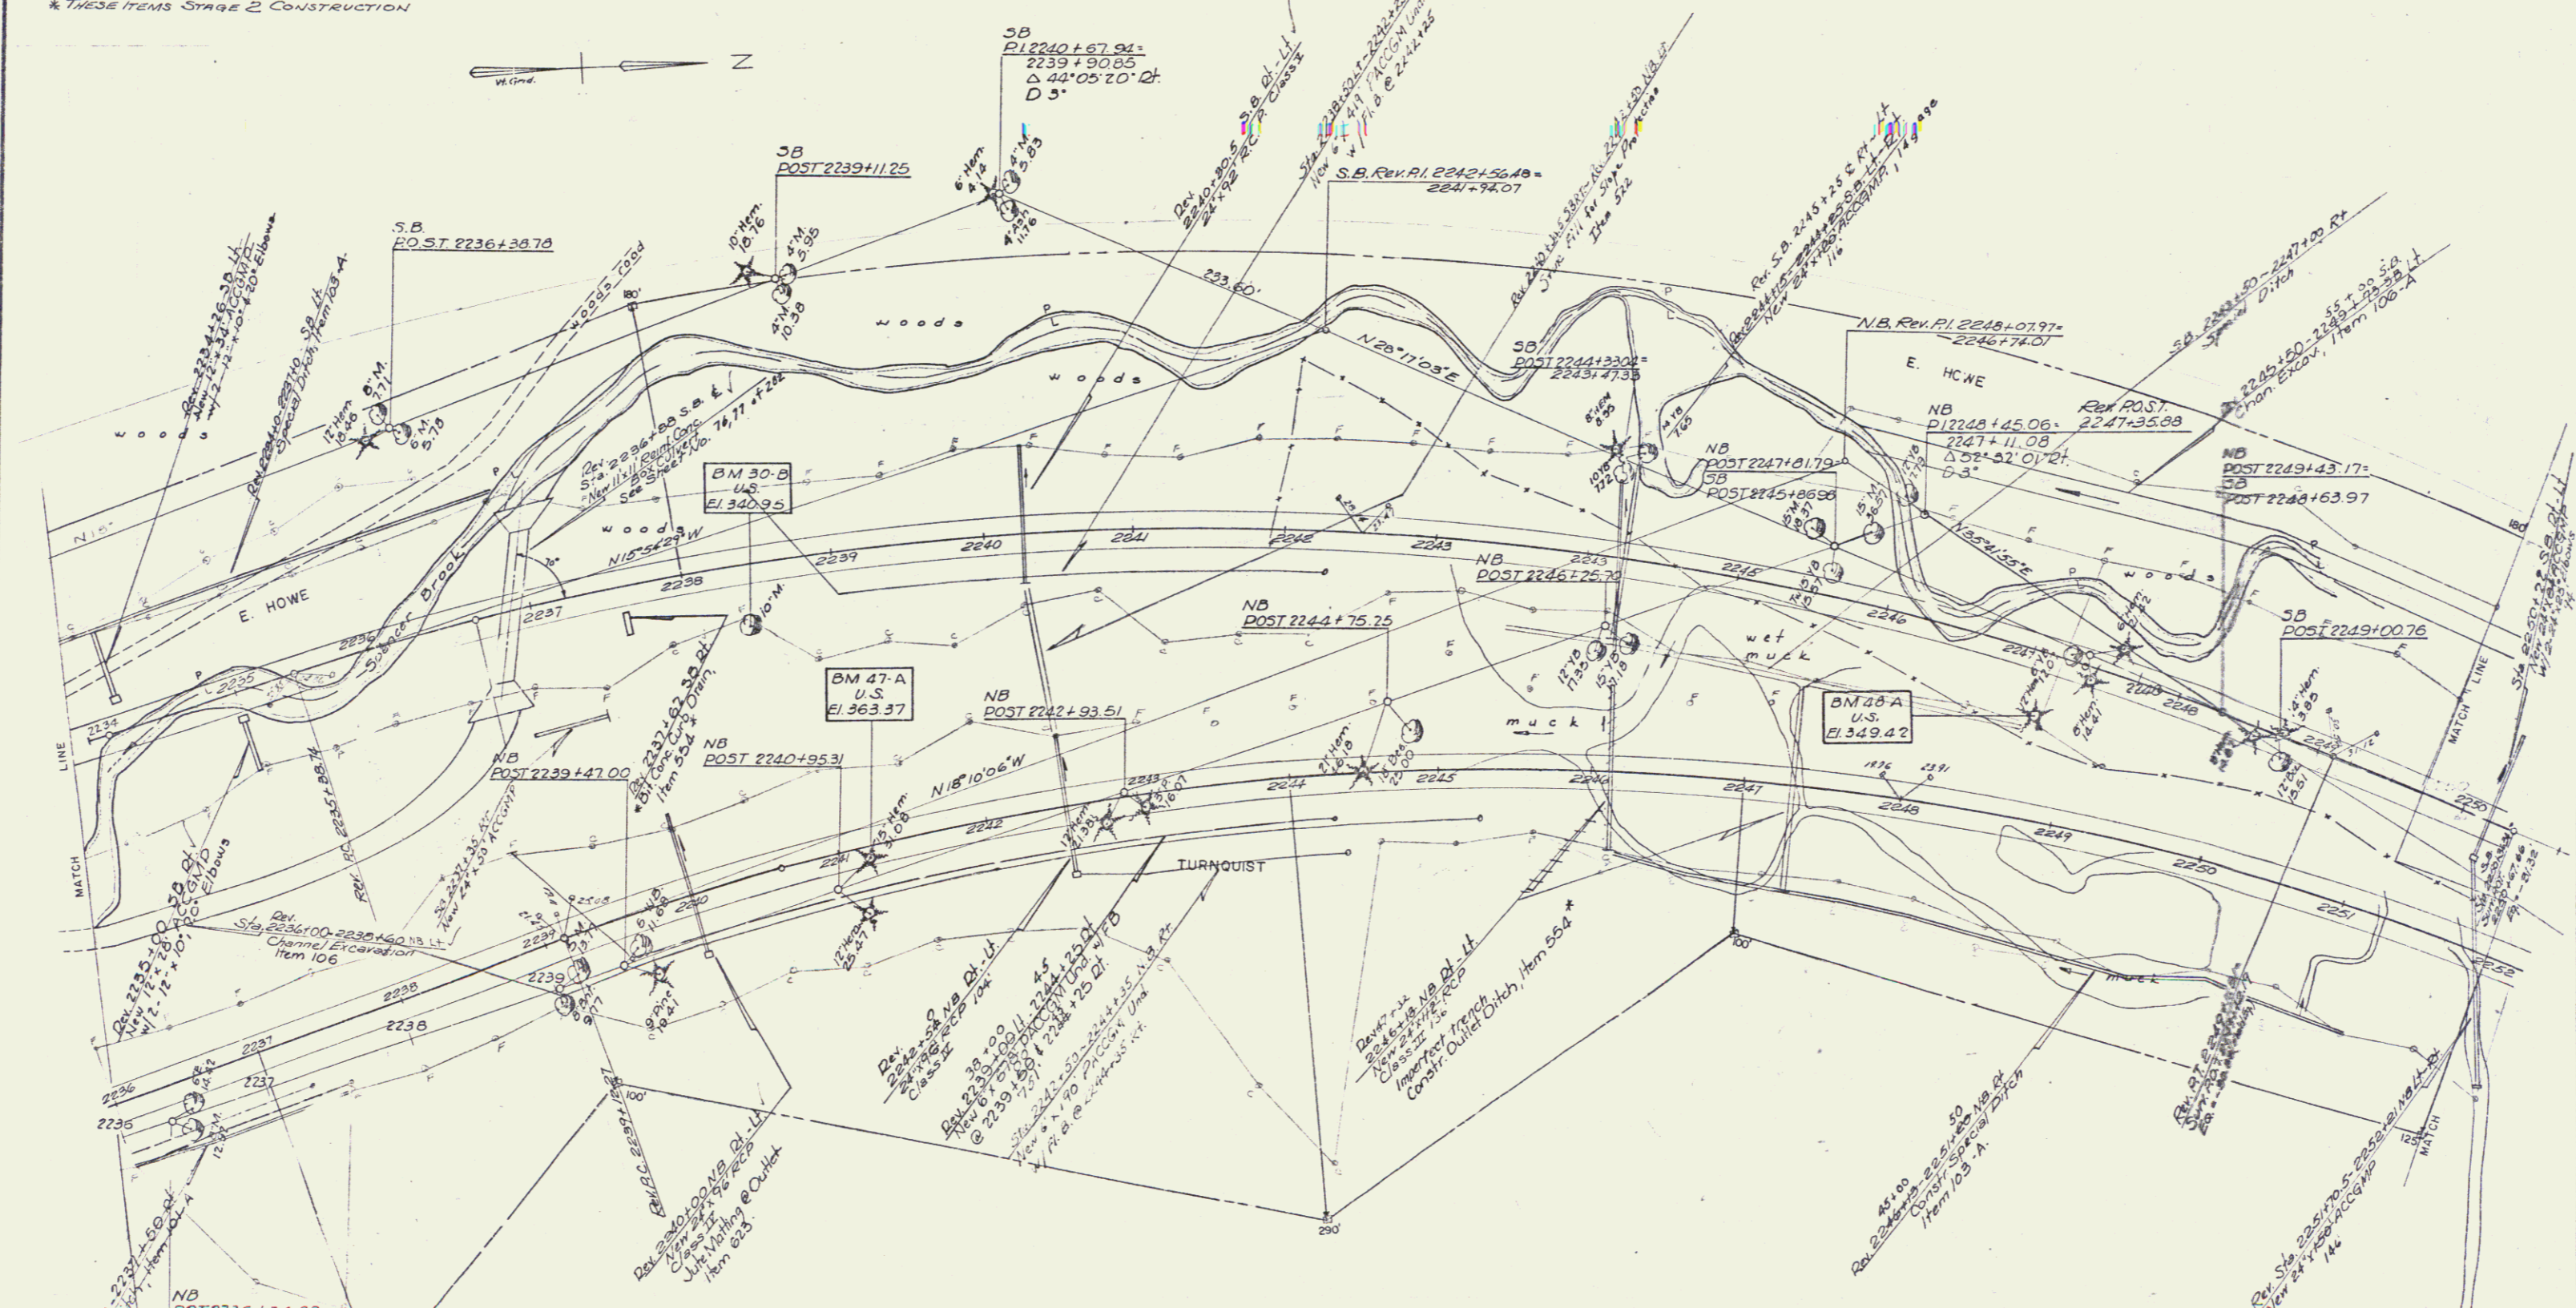


Det. NB 2236+00 - 2237+50 L.F.  
 Construct Special Ditch  
 Item 106

S.B. Rev. #2  
 $\Delta$  41° 11' 32" RT  
 D 3"  
 R 1909.56  
 T 717.74  
 L 1373.07  
 E 130.39  
 Bank 7/8' ft

Spiral Curve Data  
 $\Delta$  41° 11' 32" RT  
 Dc 3"  
 R 1909.06  
 Ls 250.00  
 Ts 2234+13.27  
 Sc 2236+63.27  
 Cs 2247+86.34  
 St 2250+136.31

N.B. Rev. #2  
 $\Delta$  53° 52' 01" RT  
 D 3° 15'  
 R 1762.95  
 T 895.70  
 L 1837.44  
 E 214.19  
 Bank 1/2' ft

Spiral Curve Data  
 $\Delta$  53° 52' 01" RT  
 Dc 3° 15'  
 R 1762.95  
 Ls 300.00  
 Ts 2237+61.23  
 Sc 2240+61.23  
 Cs 2254+186.1  
 St 2257+186.1

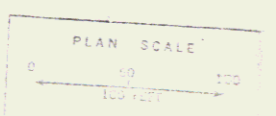

STAGE 1 CONSTRUCTION  
 SPRINGFIELD  
 I 9-1(19)  
 Sheet 19 of 232 Sheets  
 C-1011 No. 2