


- \* THREE CABLE GUARD RAIL w/ STEEL POSTS  
 30' L. 2295+00-2300+44  
 NB R/L 2300+16-2304+16  
 2300+16-2304+16
- \* BITUMINOUS CONCRETE CURB  
 ITEM 555  
 NB 2300+16-2304+16 DI.  
 31' 60"
- \* TREATED TIMBER CURB  
 ITEM 505  
 SB 2299+00-2308+44 L.  
 31' 60"
- CLEARING & TRIMMING  
 ITEM 601  
 2301+10-2312+00 SB.  
 2305+00-2306+00 NB KT
- DRILLING & BLASTING  
 ITEM 66  
 SB 2300+50-2302+50  
 SB 2305+50-2306+50  
 SB 2308+50-2312+00  
 NB 2303+50-2314+00  
 65
- PROPERTY LINE FENCE w/ STEEL POSTS  
 SB L. 2297+00-2312+00

\* These items Stage 2 construction.  
**NOTE:**  
 CONTROL of ACCESS is COMPLETE on THIS SHEET.

PLAN	BY	DATE
STAKE	BY	DATE
CONTRACT	BY	DATE
TERRACE	BY	DATE

PARCEL: 211  
 GRANITOR: HENRY L. & VIOLA L. FERGUSON  
 TAKING: 20.0 A ± LA REM. 200.0 A ±  
 RIGHTS: DRAINAGE: 2302+00, 2308+83  
 2311+50, 2316+00, ± SB, LT.  
 WATER PIPE LINE RIGHTS  
 LOSS OF ACCESS - 2303+00-2304+32 NB, EAST OF TAKE (107.2 A ±)  
 TITLE TAKEN: Copy of 9-30-63  
 RECORDED: SPRINGFIELD, Vol. 5 PG. 338 DT. 10-2-63

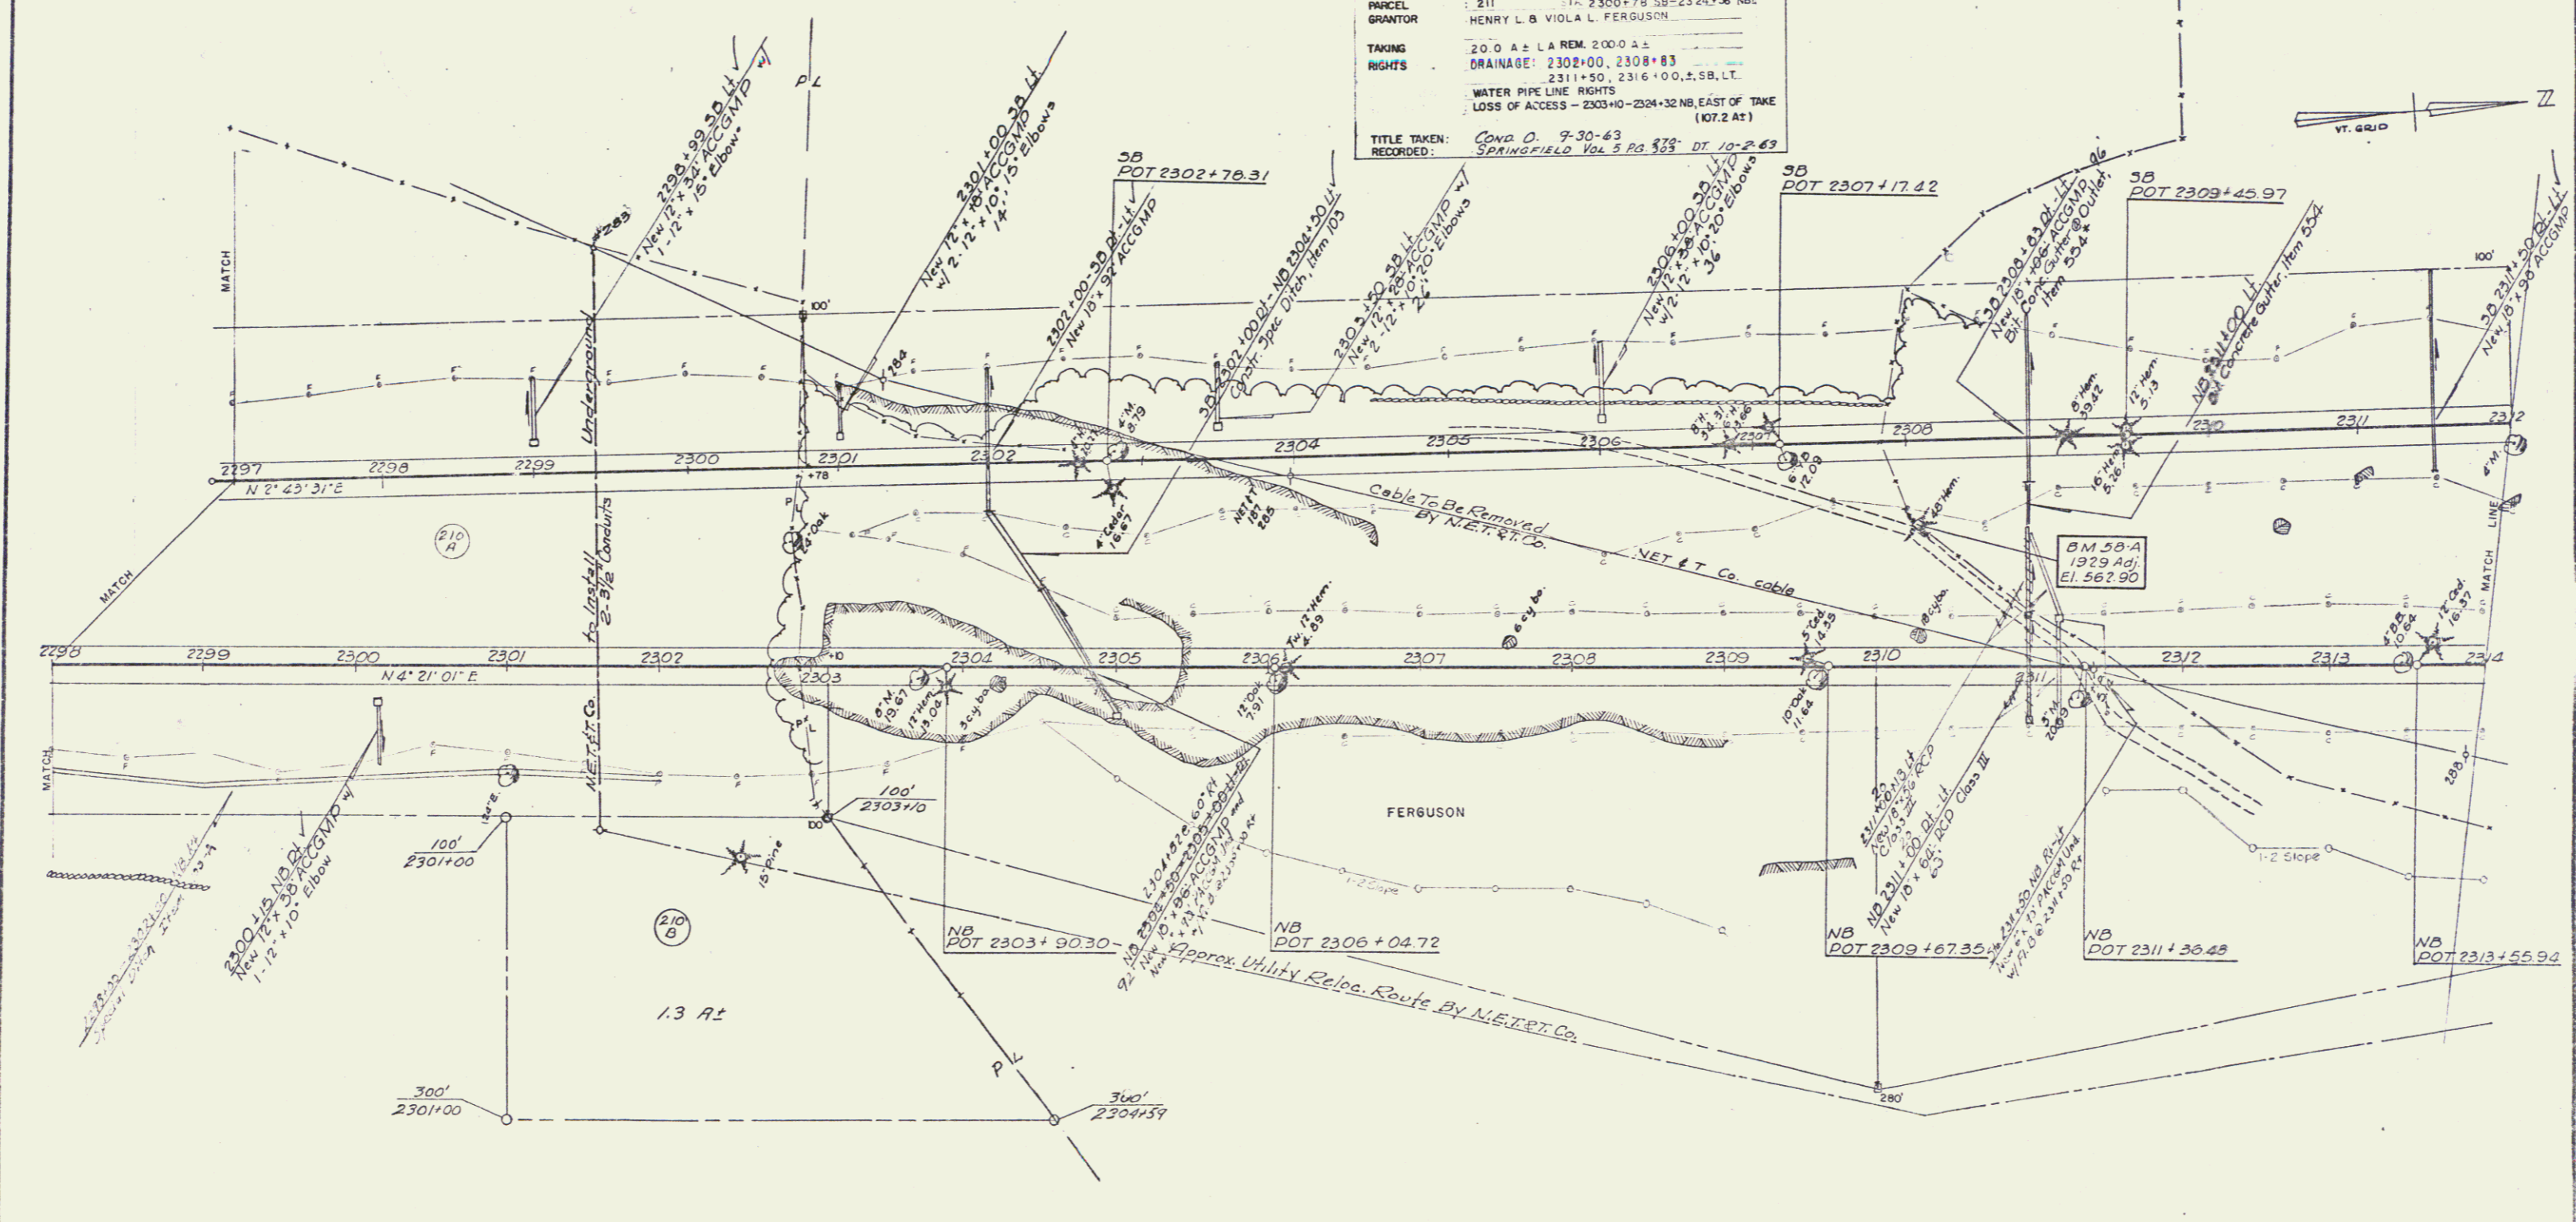

PLAN FILED  
 STAGE I CONSTRUCTION  
 SPRINGFIELD  
 I 91-1(19)  
 Sheet 27 of 232