

PLAN	DATE
Revised	10-23
Final	11-10
As-Built	5-10


* Three Cable Guard Rail w/ Steel Posts
SB 2354+46 - 2355+66 R/L
3' x 62' 6" x 5

* STAGE 2 ITEMS


Clearing and Trimming
Item 601
2344+00 - 2358+25 S.B.

Drilling and Blasting
Item 114
SB 2358+00 - 2359+00
NB 2347+50 - 2352+50
NB 2353+00 - 2361+00

NOTE: CONTROL OF ACCESS IS COMPLETE ON THIS SHEET

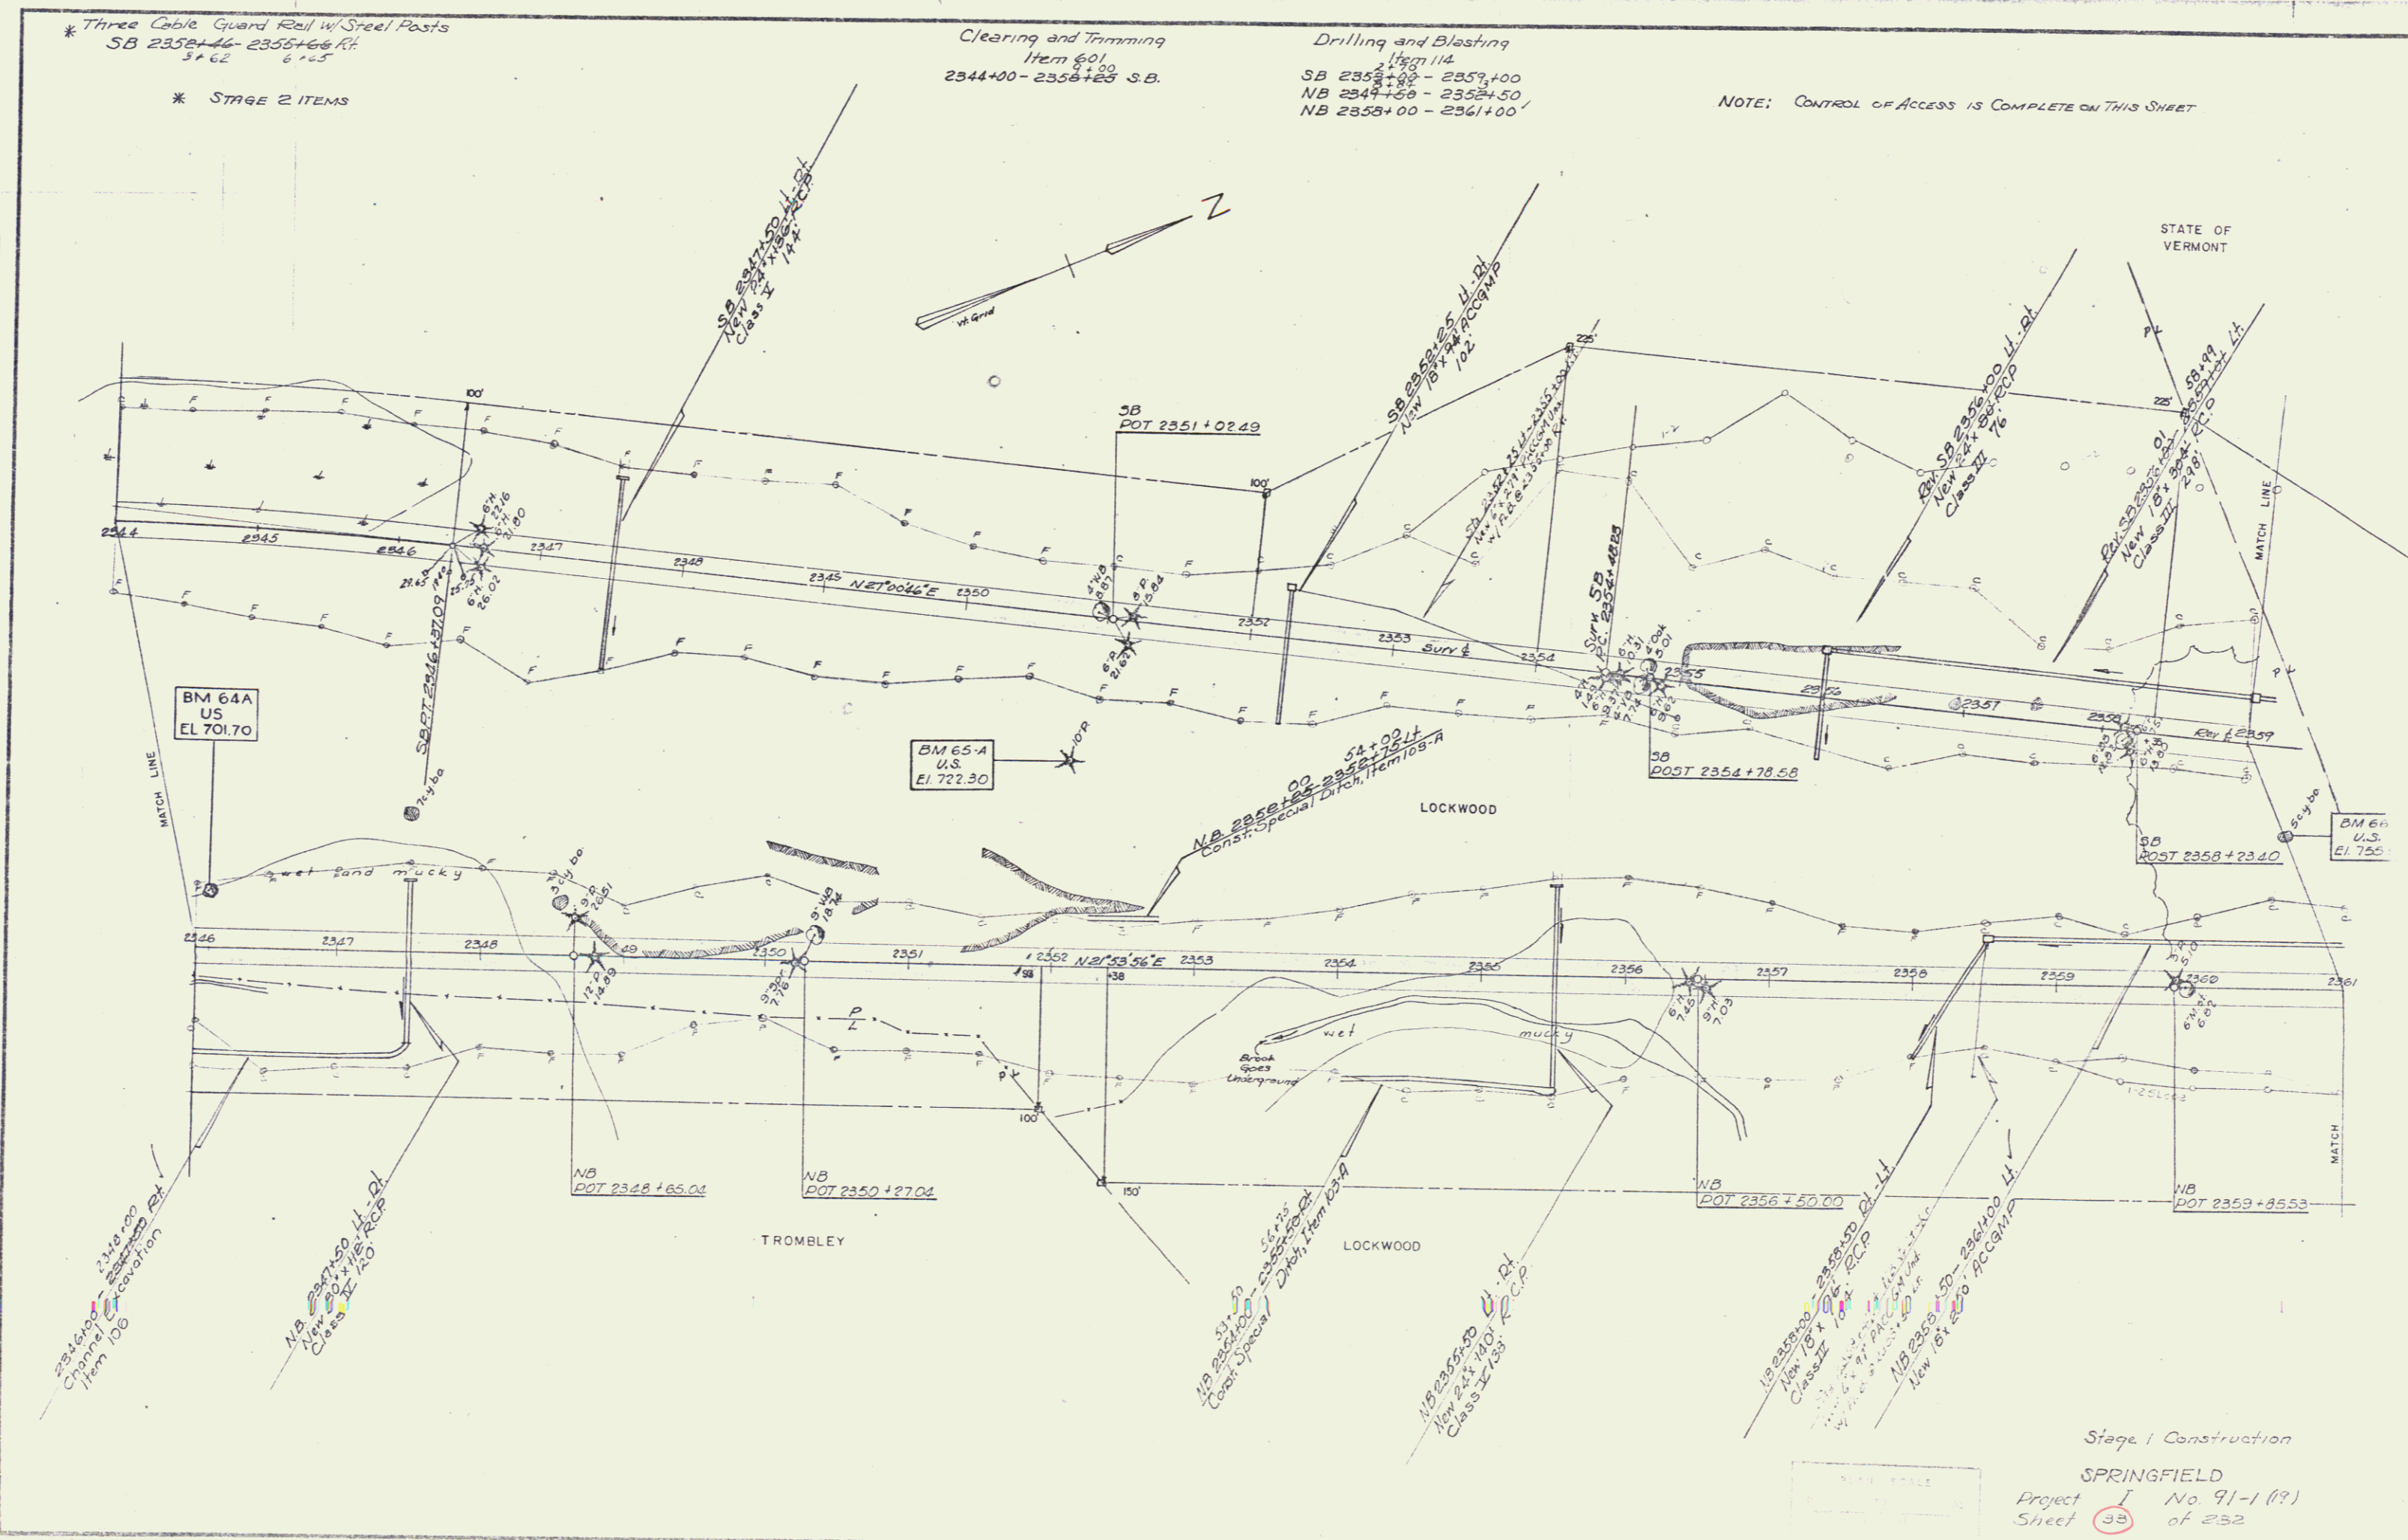

STATE OF VERMONT

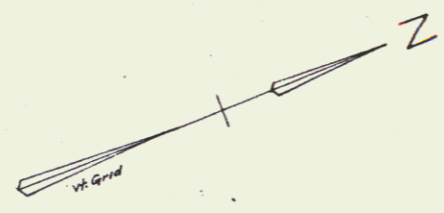

BM 64A
U.S.
EL 701.70

BM 65-A
U.S.
EL 722.30

BM 64
U.S.
EL 755

Stage 1 Construction
SPRINGFIELD
Project No. 91-1 (R?)
Sheet 93 of 232