

BLANK	BY	DATE
Checked	Miller	11-20-60
Traced	W.	


- * BITUMINOUS CONCRETE CURB
ITEM 255
SD 2367+50 - 2372+75 LI
NB 2370+25 - 2373+50 LI
SB 2276+30 - 2384+75 LI
- * THREE CABLE GUARD RAIL
w/ STEEL POSTS
SD 2367+50 - 2373+75 LI
SD 2376+00 - 2384+75 LI
NB 2369+00 - 2372+75 LI
NB 2378+50 - 2382+75 LI
- * STANDARD STEEL BEAM GUARD RAIL
w/ STEEL POSTS
* These items, Stage 2 construction

NOTE: -
CONTROL OF ACCESS IS COMPLETE ON THIS SHEET.

Termini of Project
Cut 456 c.y.
Rock 345 c.y.

215 STA
OLIVER E. B RUTH S. WOODRUFF
TAKING NONE
RIGHTS SLOPE RIGHTS 1500 SQ FT ±
TITLE TAKEN WD 11-27-63
RECORDED SPRINGFIELD 5 340 LT 1-9-64

216 A, B, C STA
LEON H BARRY EST
TAKING 20.00 ±
RIGHTS DRAINAGE: 2370+75, 2372+60, 2378+65 SB LT
TITLE TAKEN WD 10-10-63
RECORDED SPRINGFIELD 5 322 10-31-63

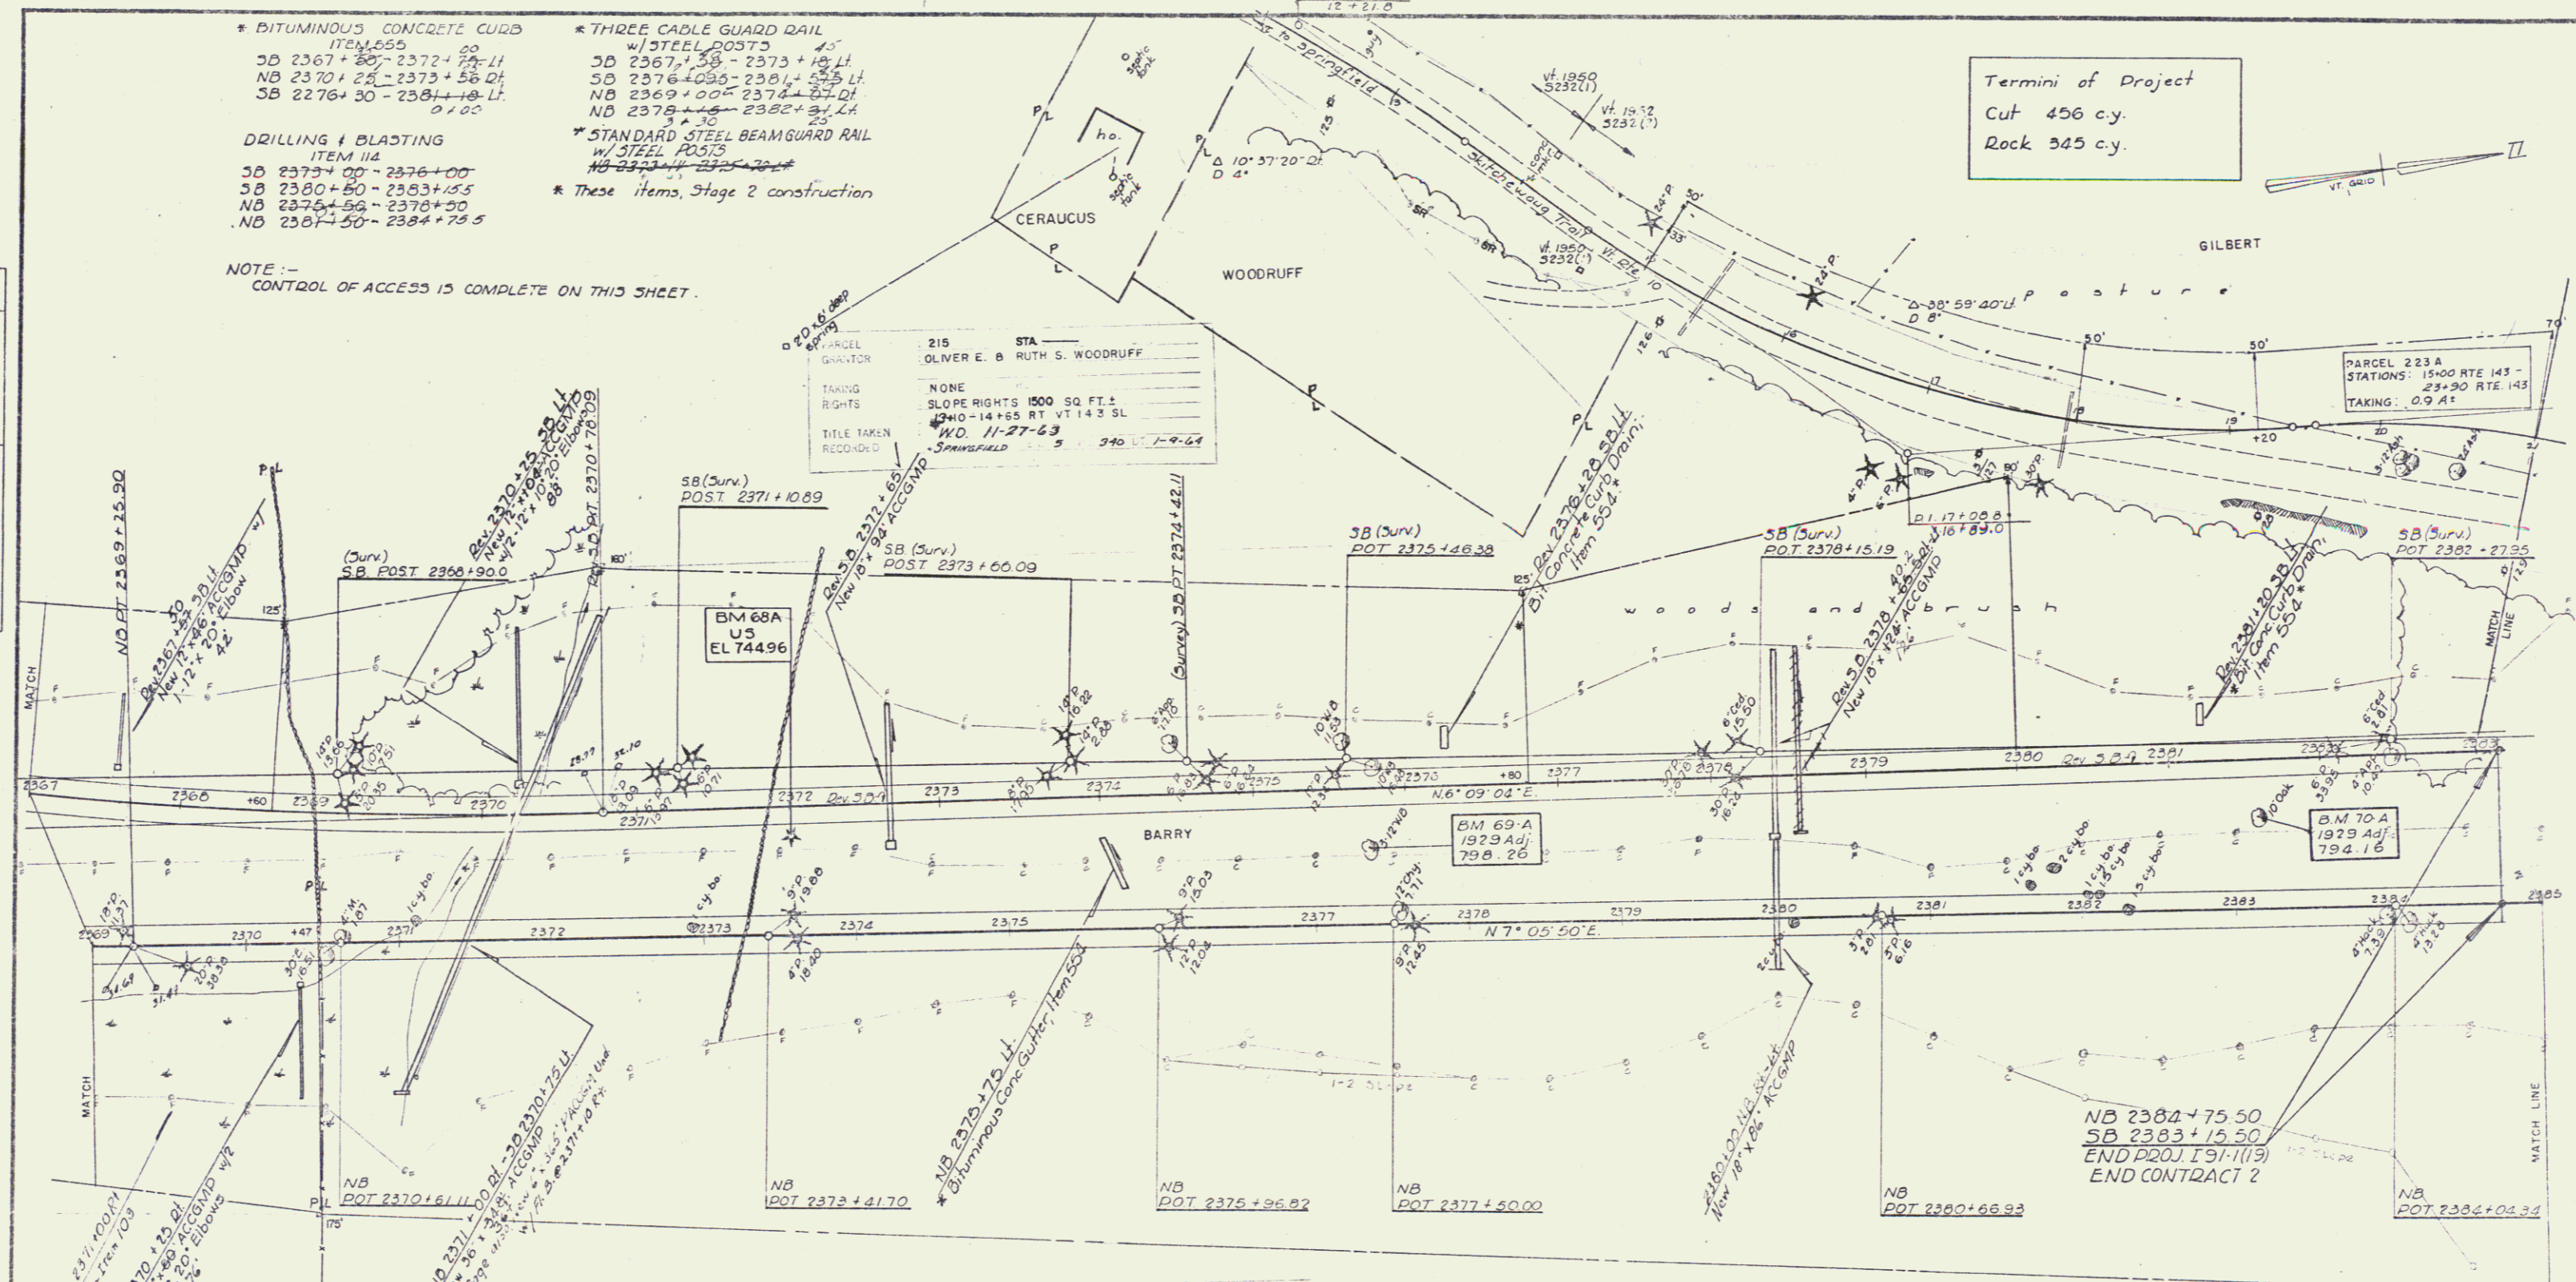

NB 2384+75.50
SB 2383+15.50
END PROJ 191-1(19)
END CONTRACT 2

STAGE I CONSTRUCTION
SPRINGFIELD
Project I No 91-1 (19)
Sheet 37 of 222