


DRILLING & BLASTING of SOLID ROCK
ITEM 113
Rev SB 2415+00 - 2415+50'

PROPERTY LINE FENCE * THREE CABLE GUARD RAIL
ITEM 503
Rev SP 2415+00 - 2431+00 LT ✓
NB 2417+00 - 2427+14 RT ✓ Rev SB 2424+14 - 2430+19 H ✓

DRILLING & BLASTING of SOLID ROCK SUBGRADE
ITEM 114, Mod
NB 2417+00 - 2423+00 ✓
NB 2432+50 - 2433+00 ✓
Rev SB 2415+50 - 2422+50 ✓
Rev SB 2425+50 - 2426+50 ✓
SB 2428+50 - 2428+50 ✓

Note:
Prior to the commencement of construction construct Property Line Fence with Steel Posts, 18m Spacing
SB 2415+00 - 2431+00 LT
NB 2417+00 - 2427+14 RT
* DENOTES STAGE 2 ITEMS
NOTE: CONTROL OF ACCESS IS COMPLETE ON THIS SHEET.

DESIGNED BY	SPRINGFIELD
CHECKED BY	SPRINGFIELD
PLOTTED BY	SPRINGFIELD
DATE	11/10/93
SCALE	AS SHOWN

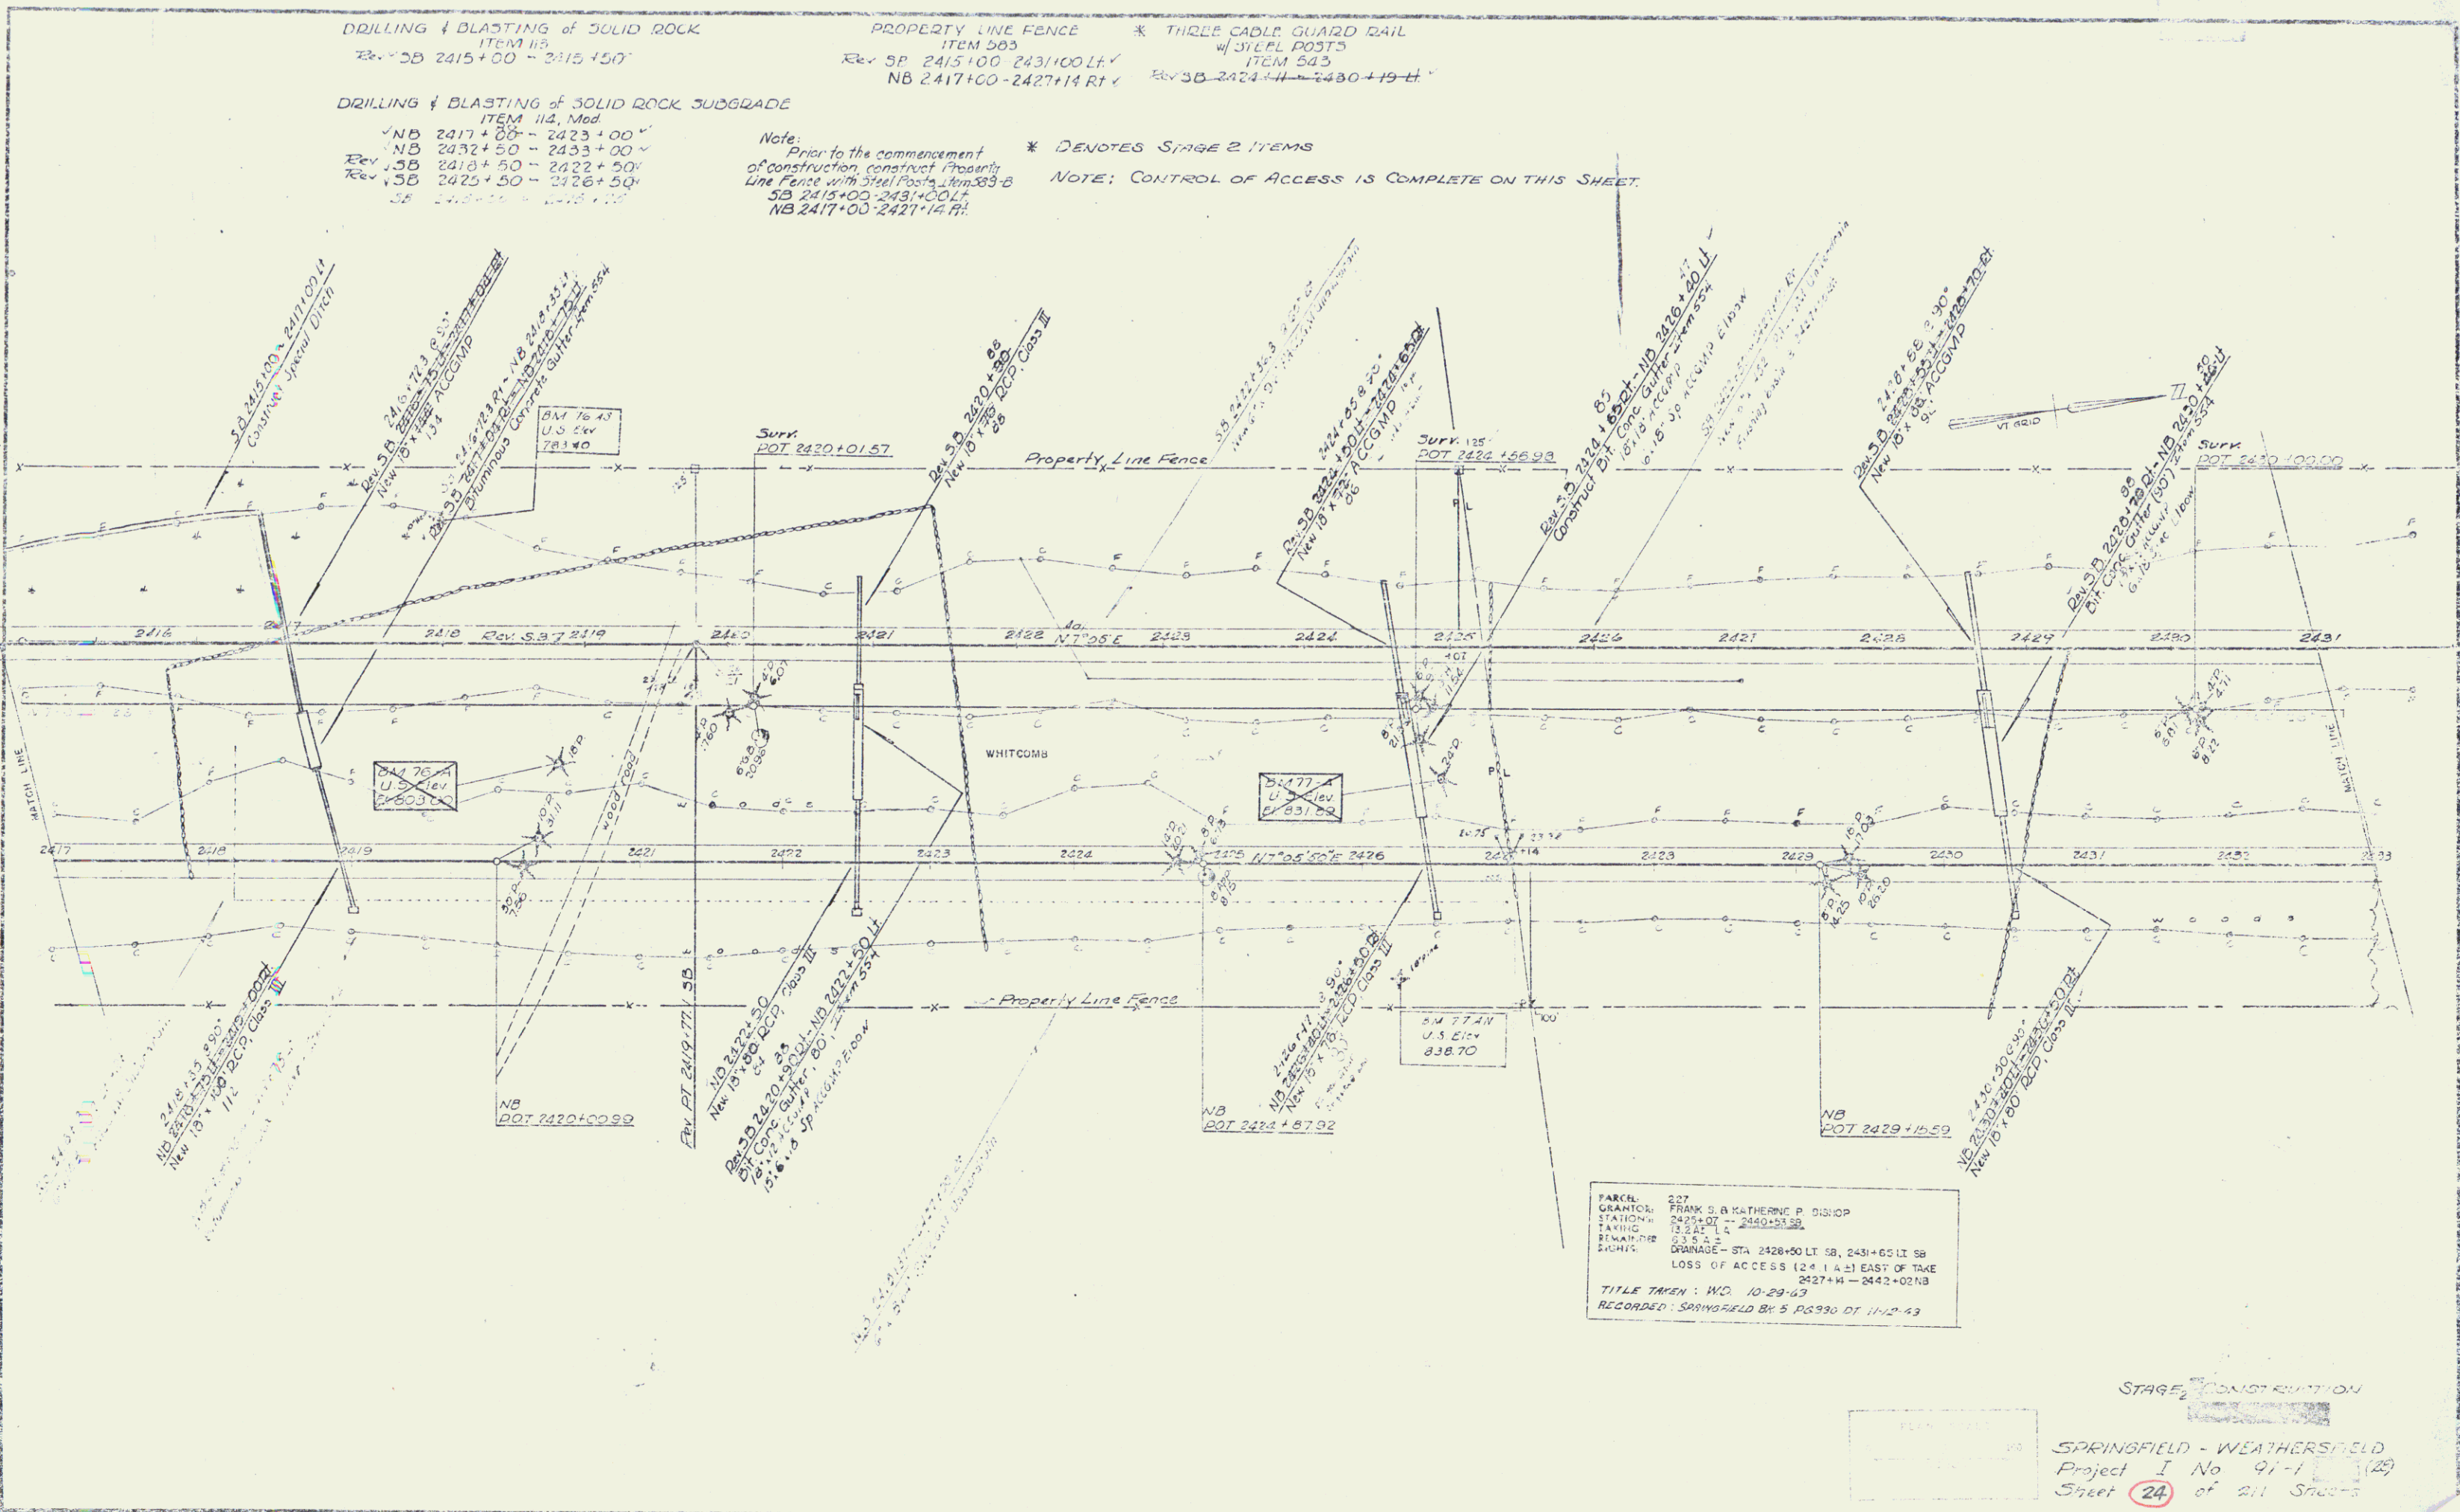

FARCEL: 227
GRANTOR: FRANK S. B. KATHERNE P. DISIOP
STATION: 2425+00 - 2430+50 SB
TAXIC: 13 221 L 2
REMARKS: 63 5 2
EACH: DRAINAGE - STA 2428+50 LT SB, 2431+60 LT SB
LOSS OF ACCESS (24 1 A 2) EAST OF TAGE
2427+14 - 2442+02 NB
TITLE TAKEN: W.D. 10-29-93
RECORDED: SPRINGFIELD Bk 5 P.590 DT 11-10-93

STAGE 2 CONSTRUCTION
SPRINGFIELD - WEATHERSFIELD
Project I No 91-1 (12)
Sheet 24 of 211 Sheets

24
Con
4