


DRILLING & BLASTING OF SOLID
ROCK SUBGRADE, ITEM 14.100
NB 2435+00 - 2436+50
NB 2443+00 - 2449+00
Rev. 50 2444+50 - 2447+00
2444+75

PROPERTY LINE FENCE
ITEM 503
Rev. 5B 2431+00 - 2447+00 LT
NB 2442+00 - 2449+00 RT

Note:
Prior to the commencement of construction
construct Property Line fence with Steel Posts, Item 503 B
NB 2442+00 - 2449+00 RT
5B 2431+00 - 2447+00 LT

NOTE: CONTROL OF ACCESS IS COMPLETE ON THIS SHEET

PLAN	BY	DATE
REVISED	BY	DATE
ISSUED	BY	DATE

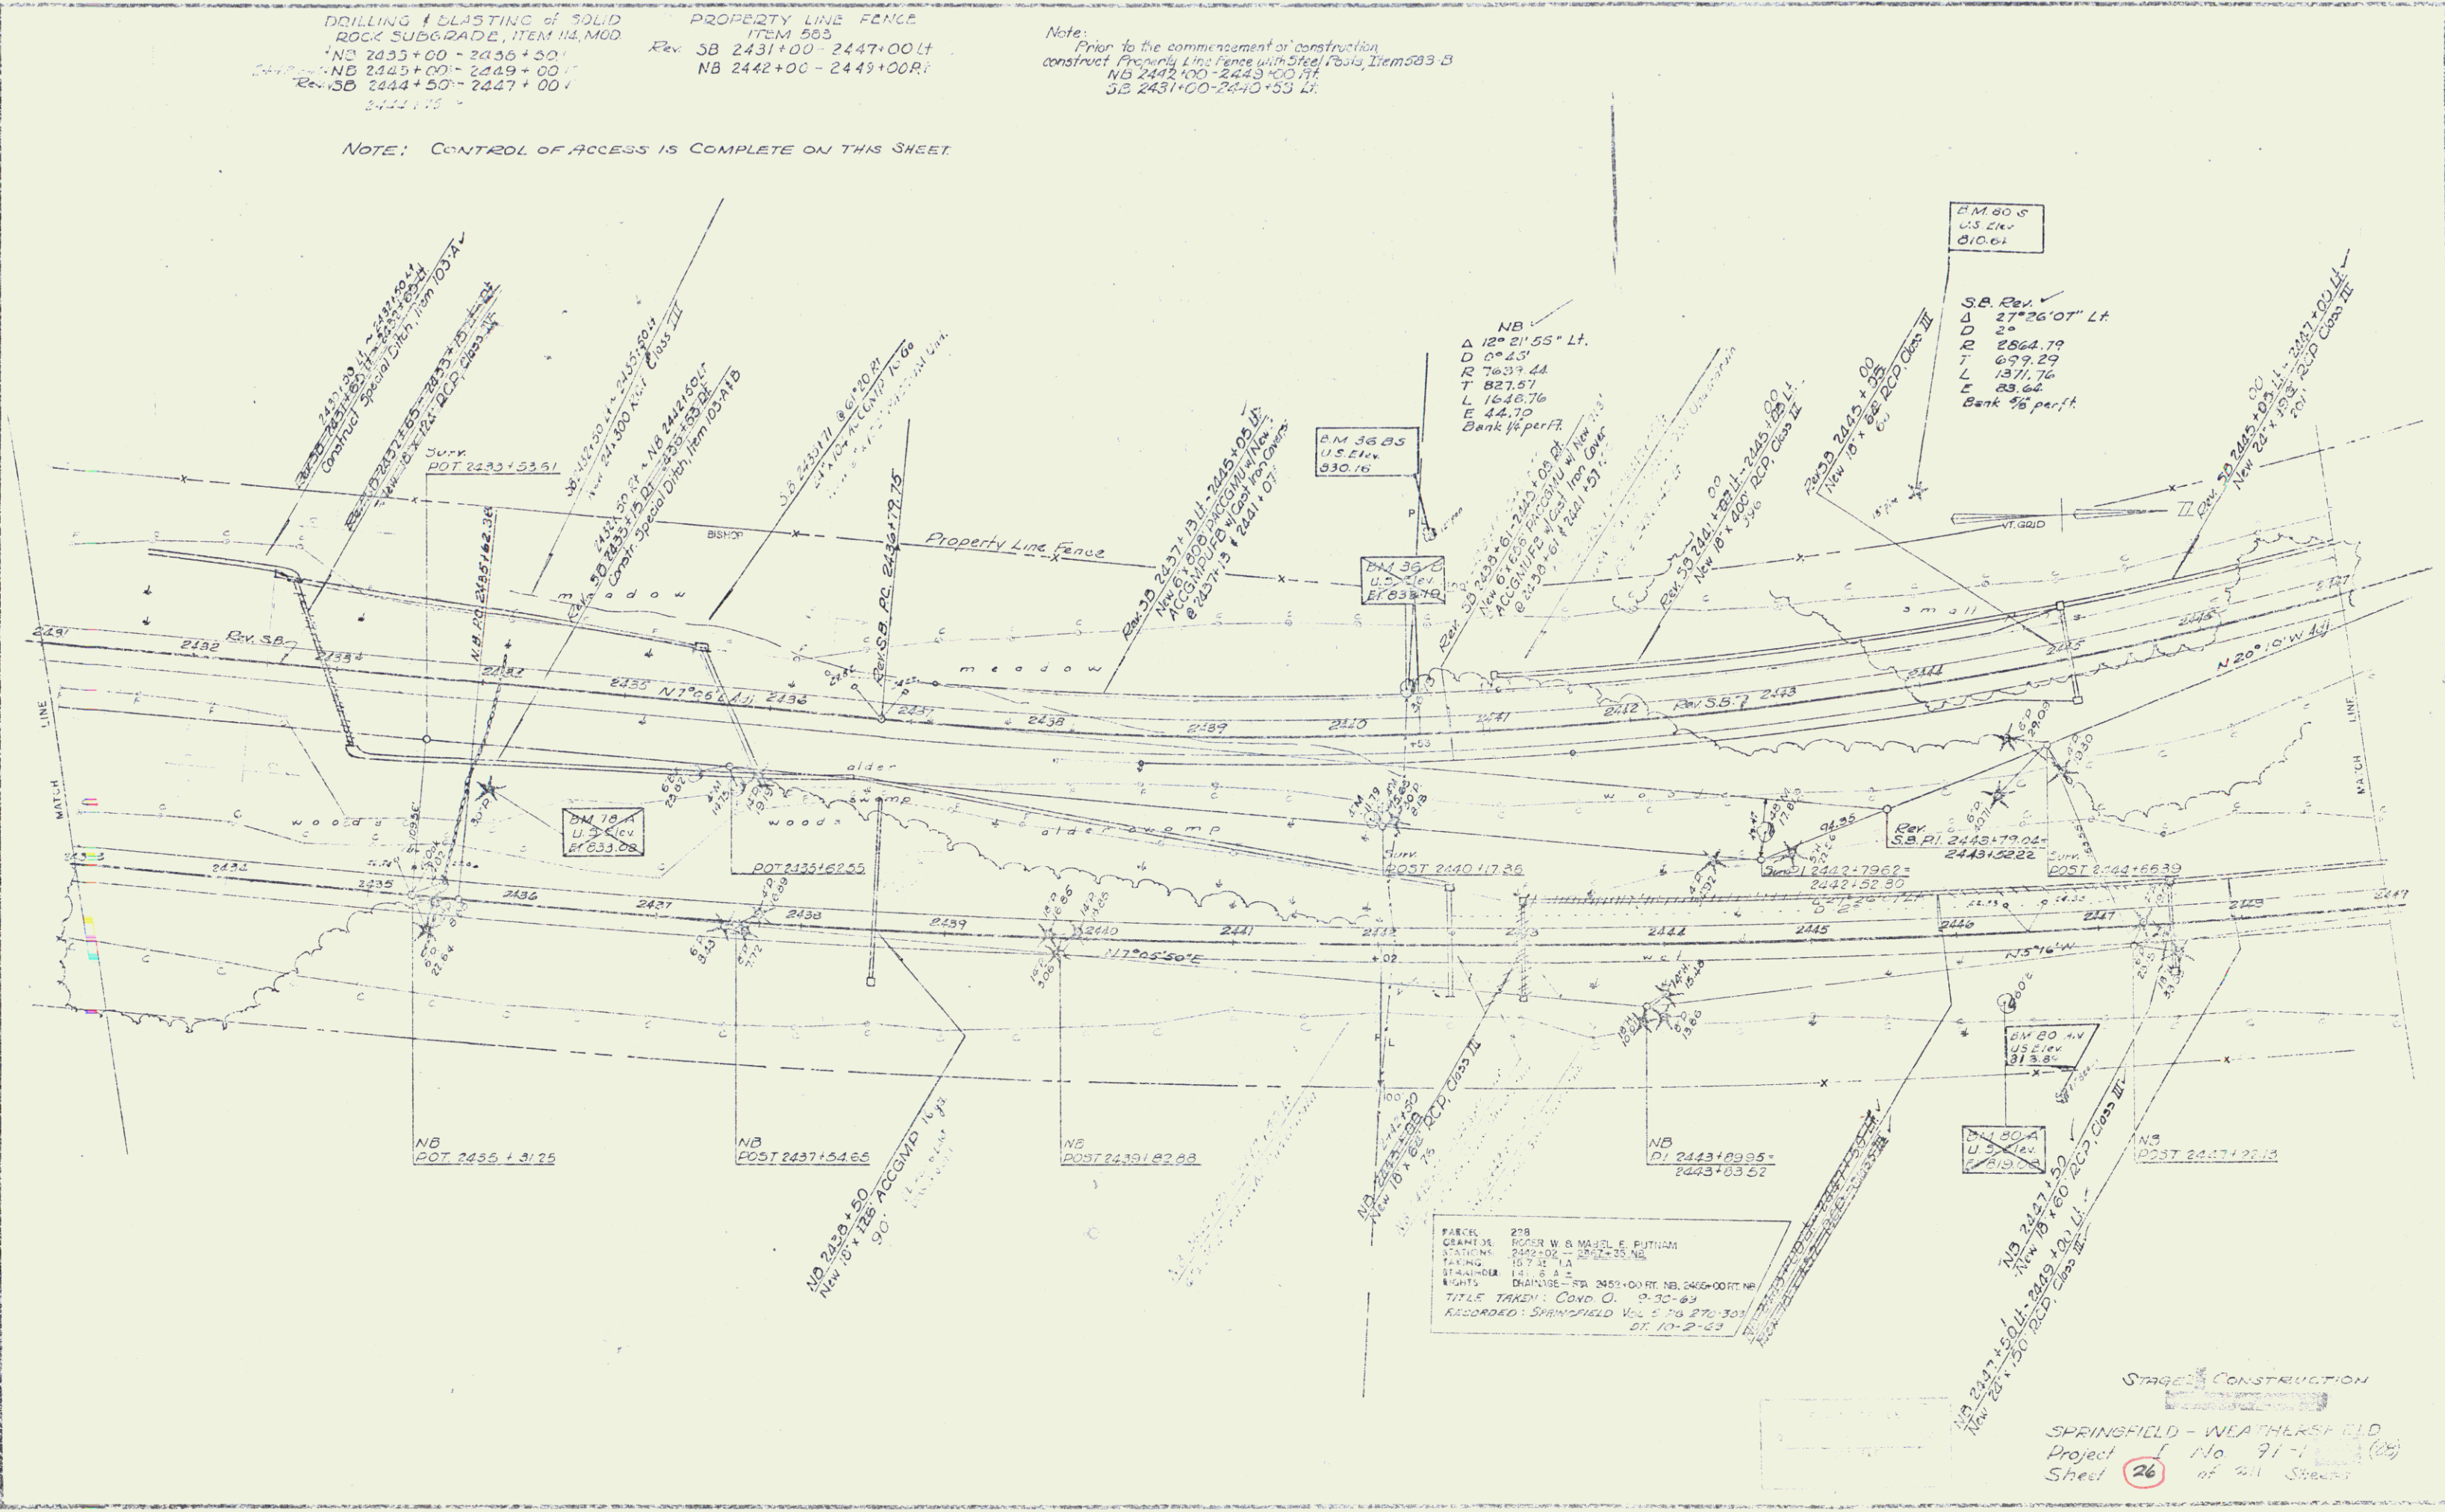

PARCEL 278
GRANT DE ROYER W & MARIE E PUTNAM
STATION: 2432+00 - 2442+50 NB
STATION: 15 7 31 1 A
RIGHTS: DRAINAGE: 24 2455+00 RT NB 2445+00 RT NB
TITLE TAKEN: COND O. 9-30-89
RECORDED: SPRINGFIELD Vol. 276 276-303
DT. 10-2-83

STAGE 2 CONSTRUCTION
SPRINGFIELD - WEATHERSFIELD
Project No. 91-1
Sheet 26 of 211 Sheets

Con
5