


PLAN	100
CONTRACT	100
DATE	100
BY	100
CHECKED	100
APPROVED	100

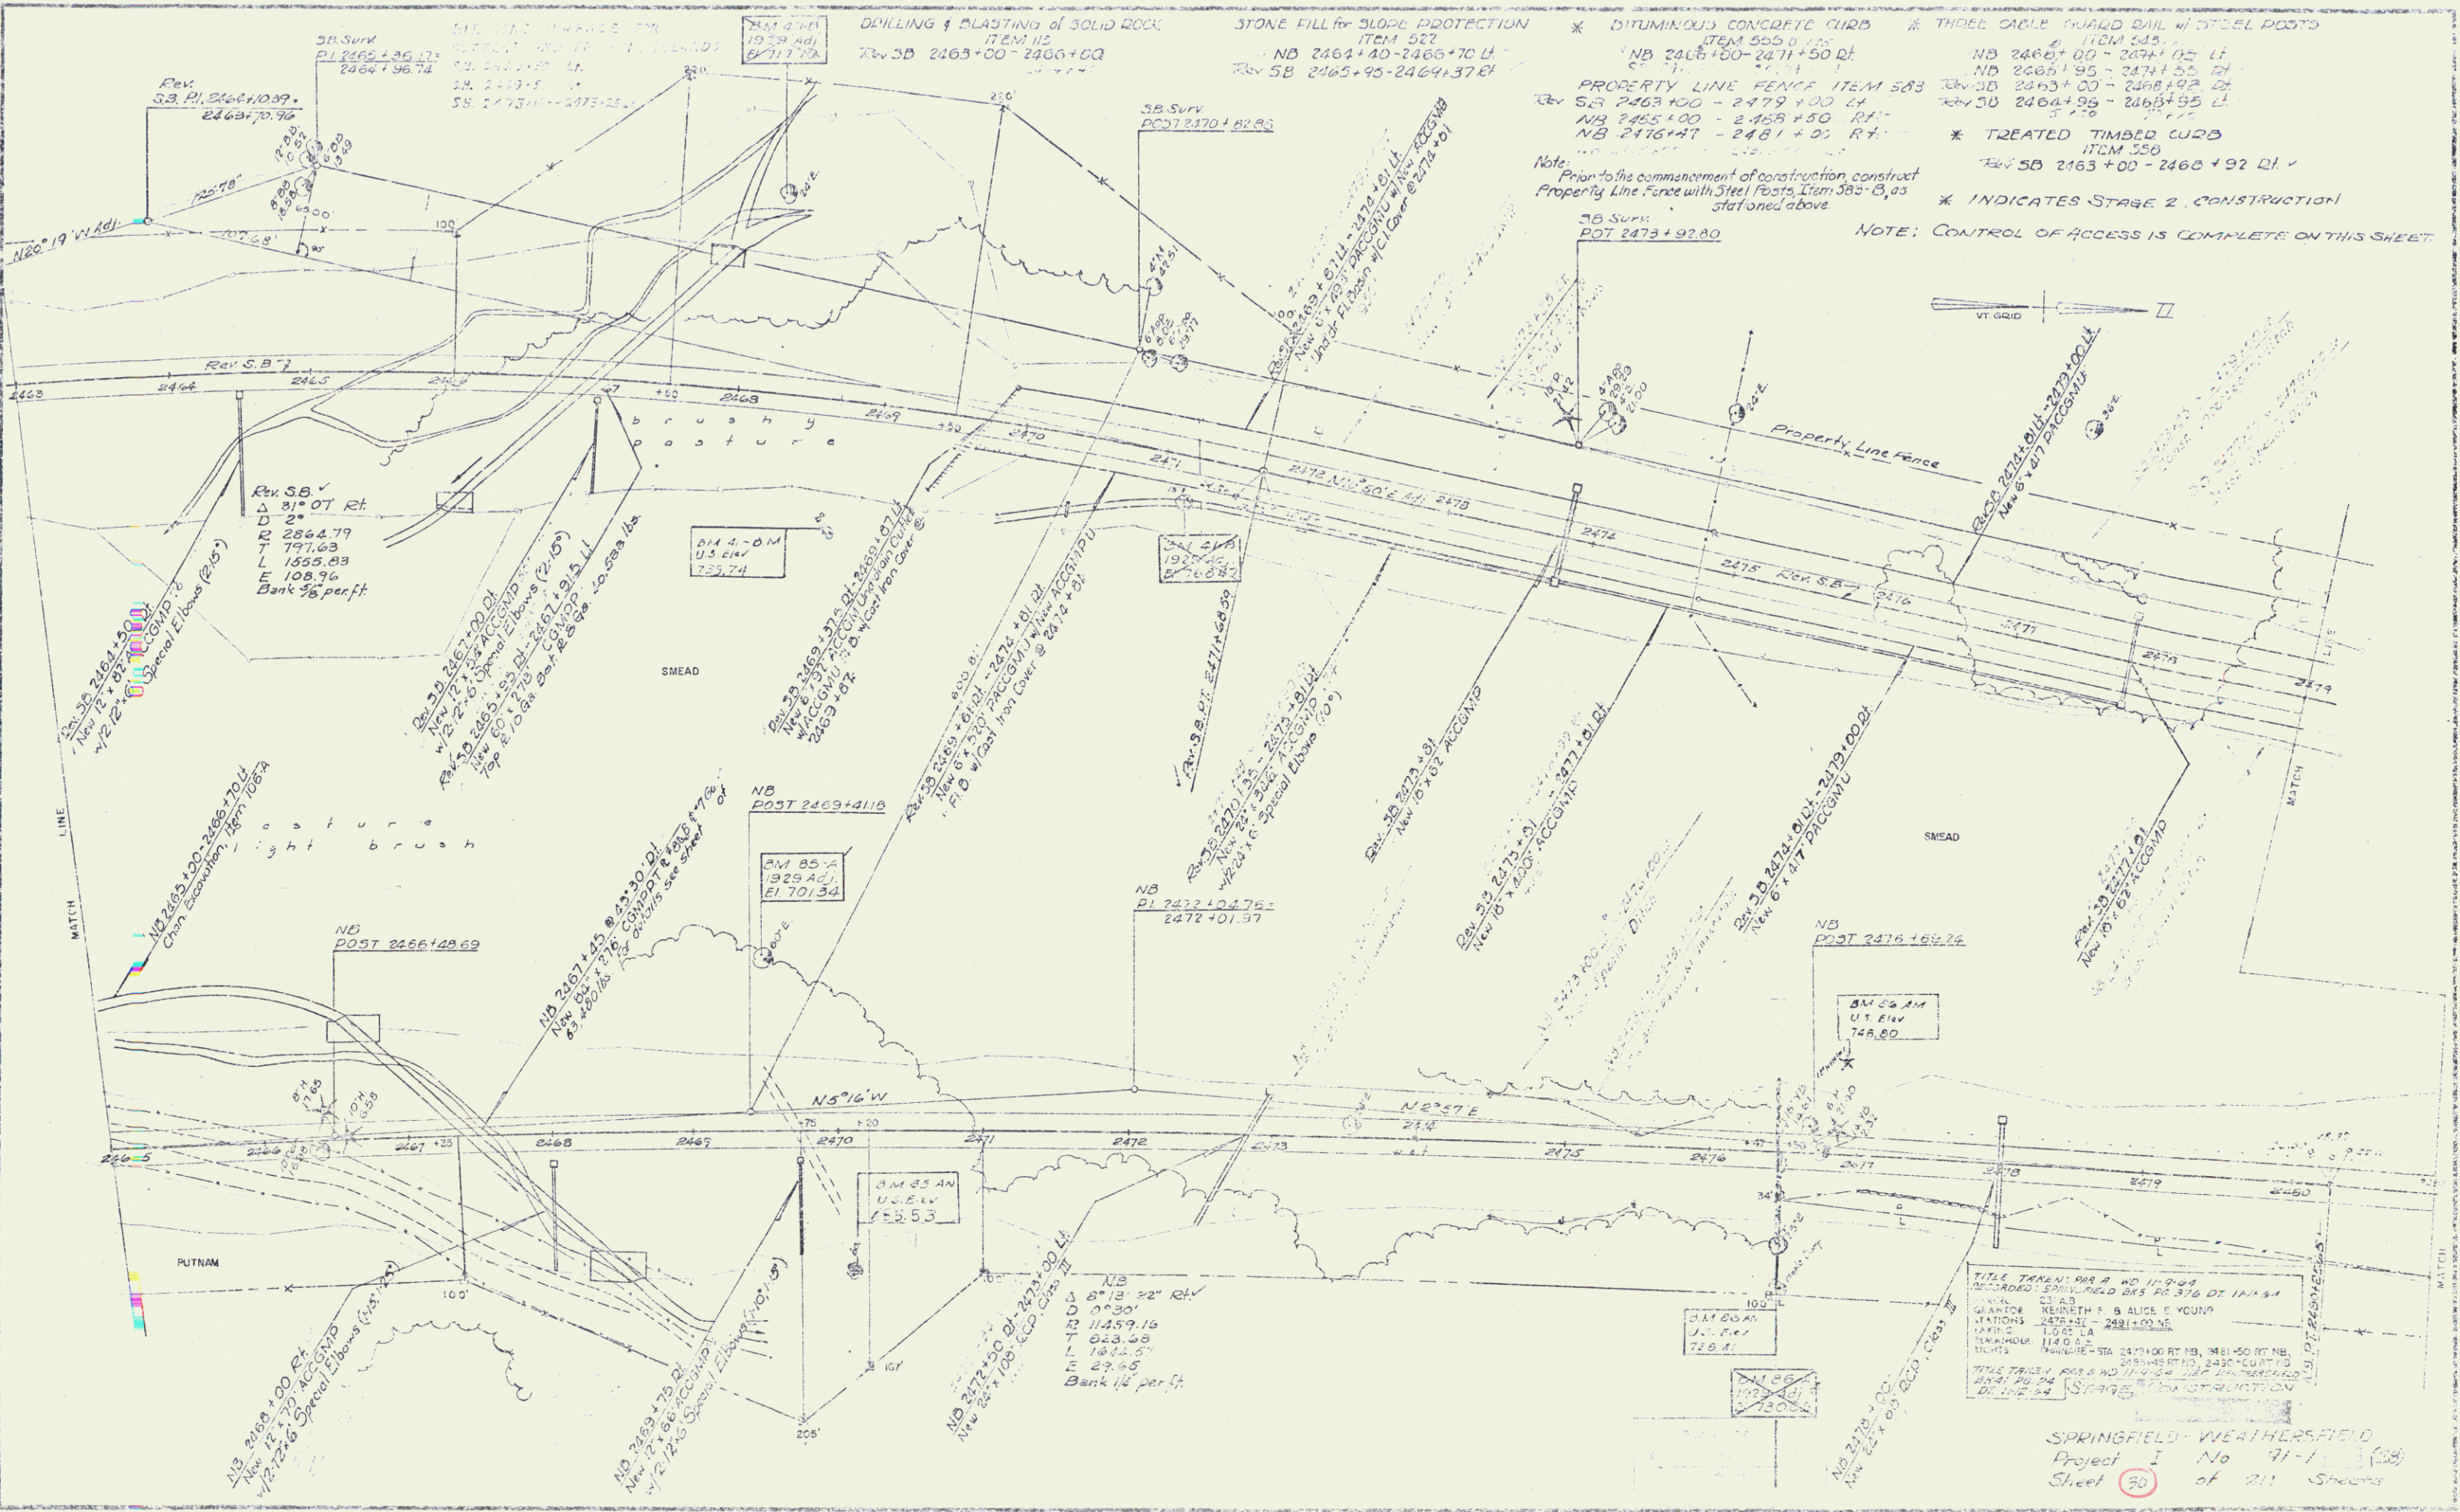

DRILLING & BLASTING OF SOLID ROCK
ITEM 522
Rev SB 2463+00 - 2466+00

STONE FILL for SLOPE PROTECTION
ITEM 522
NB 2464+40 - 2466+70 LI
Rev SB 2463+95 - 2464+37 RI

DITUMINOUS CONCRETE CURB
ITEM 525
NB 2465+00 - 2471+50 RI

THREE CABLE GUARD RAIL w/ STEEL POSTS
ITEM 525
NB 2465+00 - 2471+50 LI
Rev SB 2464+95 - 2465+95 LI

PROPERTY LINE FENCE ITEM 583
Rev SB 2463+00 - 2479+00 LI
NB 2465+00 - 2466+50 RI
NB 2476+47 - 2481+00 RI

TREATED TIMBER CURB
ITEM 526
Rev SB 2463+00 - 2466+92 RI

NOTE: CONTROL OF ACCESS IS COMPLETE ON THIS SHEET

TITLE TAKEN: 998 P. NO. 11-9-04
RECORDED: SPRINGFIELD DIST. REC. 376 DI 11/11/04
OWNER: CLAD
GRANTOR: REINETH F. & ALICE E. YOUNG
MATRONS: 247621 - 248120 35
LIVING: 1081 LA
TENANT: 1140 05
NOTES: PARCEL - STA 2471+00 RT NB, 2481+50 RT NB, 2480+00 RT NB, 2480+00 RT NB, 2480+00 RT NB
TITLE TAKE: FOR A NO. 11-9-04 11-9-04
DATE: 11-9-04
BY: [Signature]

SPRINGFIELD - WEATHERSFIELD
Project I No 91-1
Sheet 20 of 211 Sheets

Can
7