

DRILLING & BLASTING of SOLID ROCK
 SUBGRADE, REM 14, Med.
 NB 2513+00 - 2527+00
 Rev. 5B 2512+50 - 2527+00

* JUTE MATTING
 NB 2511+50 - 2511+03 LI

* THREE CABLE GUARD RAIL
 w/STEEL POSTS, ITEM 583
 NB 2512+00 - 2512+16 LI

PROPERTY LINE FENCE ITEM 583
 NB 2512+00 - 2523+10 RI

Note:
 Prior to the commencement of construction construct
 Property Line Fence with Steel Posts, Item 583-B,
 NB 2512+00 - 2512+22 RI


* DENOTES STAGE 2 ITEMS
 NOTE: CONTROL OF ACCESS IS COMPLETE ON THIS SHEET.

BIT, CONC. SURFACE FOR GUTTERS
 AND TRAFFIC ISLANDS
 S.B. 2511+00 LI
 N.H. 2515+00 LI
 S.E. 2520+00 - 2521+16 LI
 N.B. 2525+00 LI

Rev. N.B.
 Δ 28°05'29" Lt
 D 2"
 R 2862.79
 T 718.71
 L 1804.57
 E 88.29
 Bank 76 per ft

Rev. S.B.
 Δ 28°05'29" Lt
 D 2"
 R 2795.79
 T 698.19
 L 1868.29
 E 86.01
 Bank 76 per ft

DATE	BY	REVISION
1/16/64	W.H. B.	1.66
1/16/64	W.H. B.	1.66
1/16/64	W.H. B.	1.66

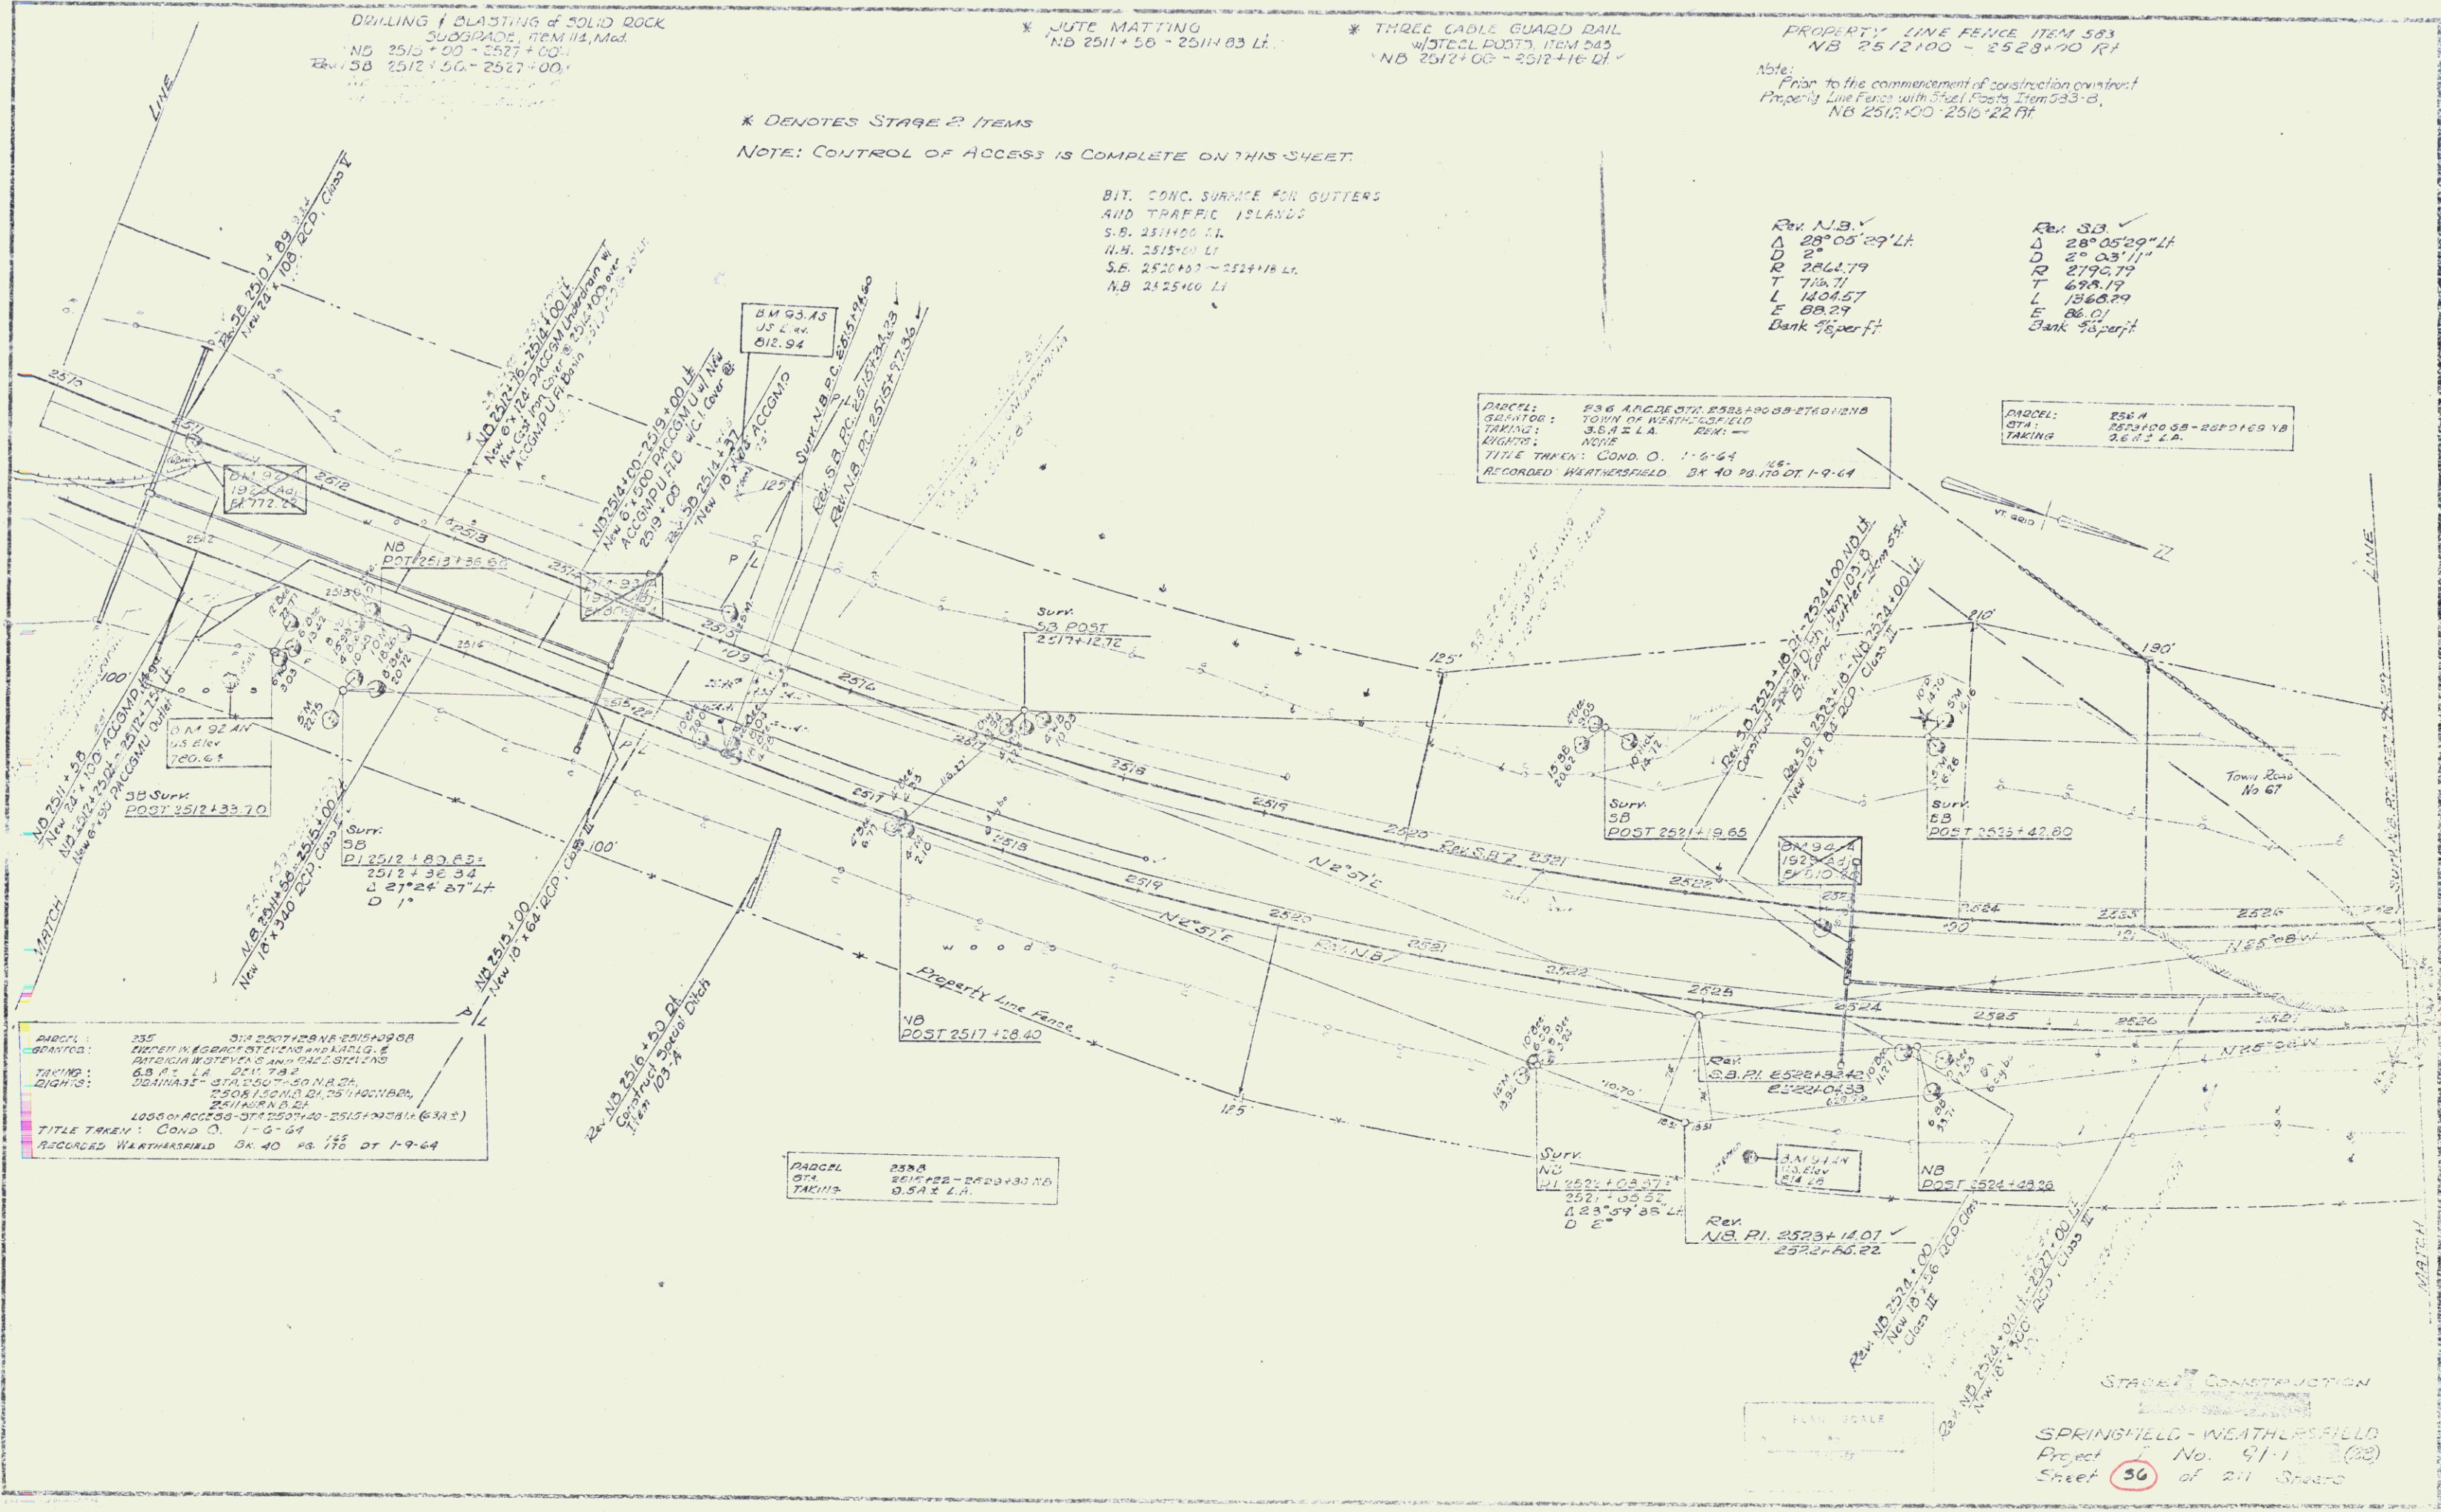

PARCEL: 256 ARCADE STA. 2524+00-2526+10 NB
 QUANTO: TOWN OF WEATHERSFIELD
 TAKING: 3.6% L.A. REV: --
 RIGHTS: NONE
 TITLE TAKEN: COND. O. 1-6-64
 RECORDED: WEATHERSFIELD BK 40 PG. 176 DT 1-9-64

PARCEL: 256 W
 STA: 2524+00-2526+10 NB
 TAKING: 3.6% L.A.

PARCEL: 255
 STA: 2512+00-2517+00 NB
 TAKING: 0.5% L.A.
 TITLE TAKEN: COND. O. 1-6-64
 RECORDED: WEATHERSFIELD BK 40 PG. 176 DT 1-9-64

PARCEL: 258A
 STA: 2517+00-2519+00 NB
 TAKING: 0.5% L.A.

Rev. N.B. P.I. 2523+14.01
 2522+60.22

STAGE 2 CONSTRUCTION
 SPRINGFIELD - WEATHERSFIELD
 Project No. 91-1-1 (22)
 Sheet 50 of 211 Sheets

Can