


PLAN	DATE	BY
REVISED		
DATE		
BY		
REVISIONS		
NO.	DESCRIPTION	DATE
1		
2		
3		

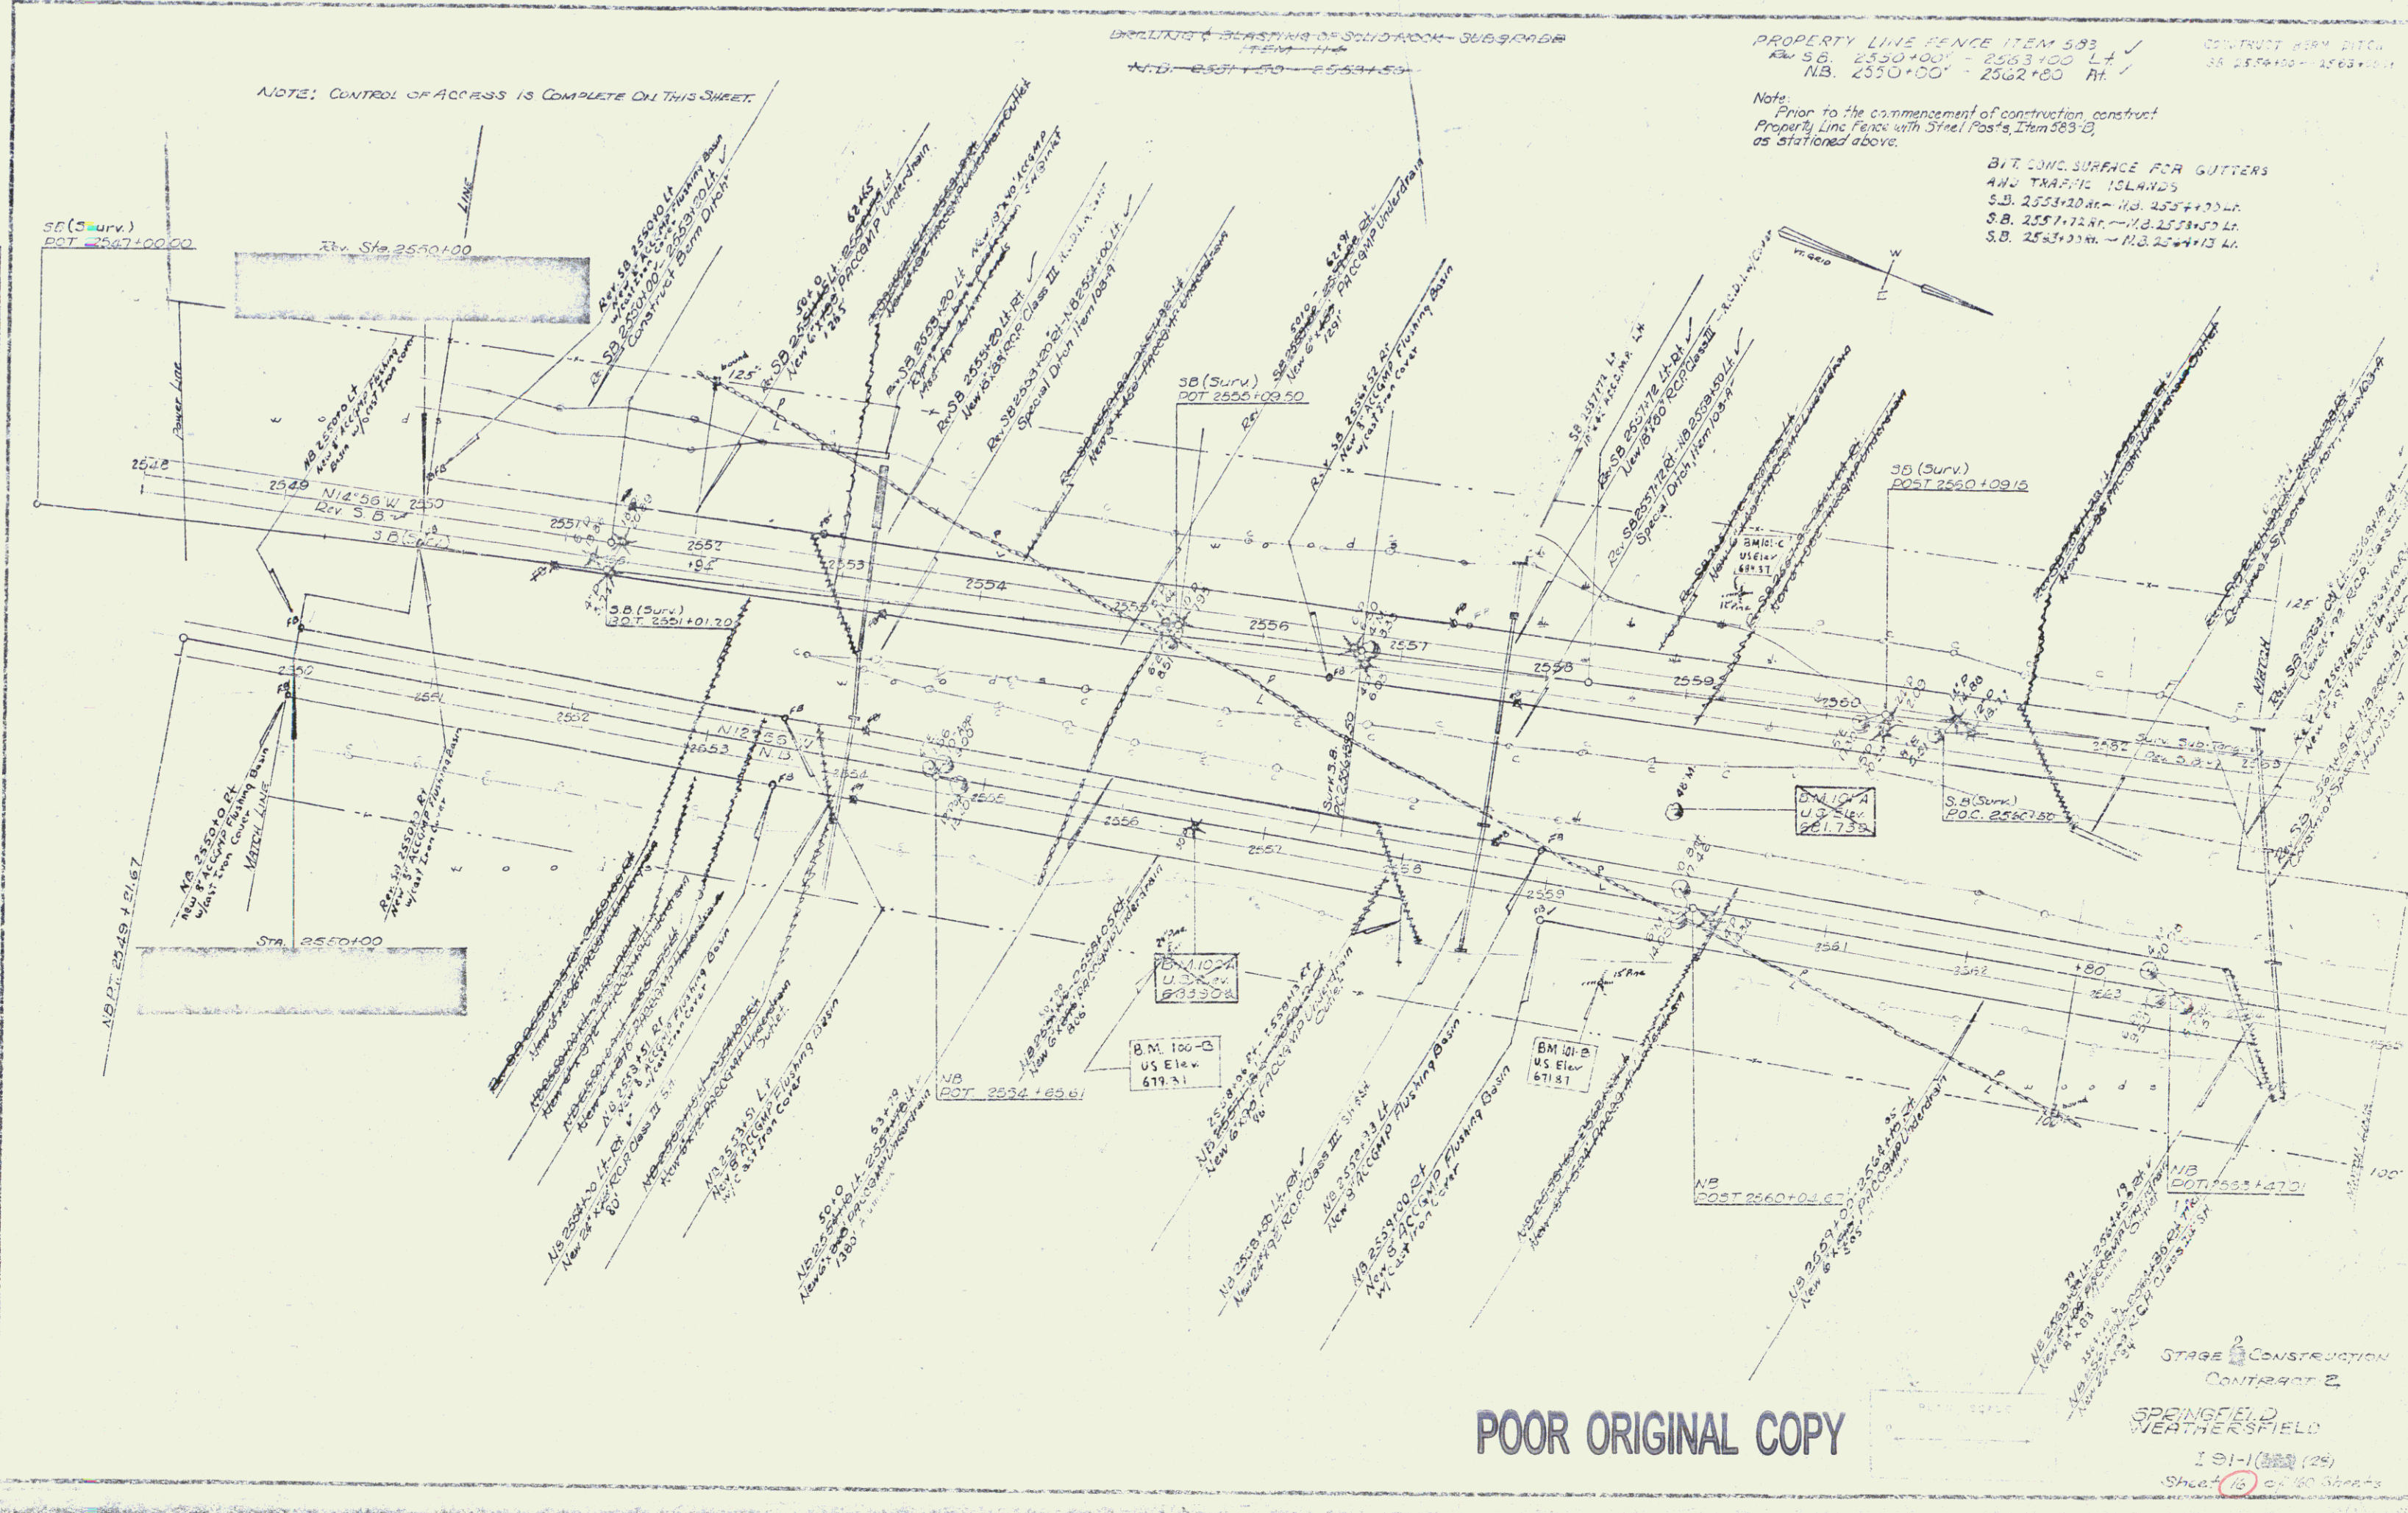

POOR ORIGINAL COPY