

DATE	BY	REVISION
11/10/00	D.J.A.M.	1.00
11/10/00	D.J.A.M.	2.00
11/10/00	D.J.A.M.	3.00
11/10/00	D.J.A.M.	4.00
11/10/00	D.J.A.M.	5.00
11/10/00	D.J.A.M.	6.00
11/10/00	D.J.A.M.	7.00
11/10/00	D.J.A.M.	8.00
11/10/00	D.J.A.M.	9.00
11/10/00	D.J.A.M.	10.00

* BITUMINOUS CONCRETE CURB
ITEM 555
2595+00-2598+00 SB EXF

* DENOTES STAGE 2 ITEMS


SB (Surv.)
P1 2598 + 35.41'
2592 + 66.77'
Δ 41° 27' 01"
D 0° 31'

DRILLING & BLASTING OF CRACKED ROCK TO GRADE
ITEM 114
2601+50-2603+50

* THREE CABLE GUARD RAIL
ITEM 543
Southbound: 2595+00-2595+00 RT
2595+00-2595+00 LT
2603+50-2603+50 RT
2603+50-2603+50 LT
Northbound: 2597+00-2597+00 RT
2597+00-2597+00 LT
2601+75-2601+75 RT
2601+75-2601+75 LT

PROPERTY LINE FENCE
ITEM 508
NB 2596+00-2608+00 RT
2608+00-2610+00 LT

NOTE: CONTROL OF ACCESS IS COMPLETE ON THIS SHEET

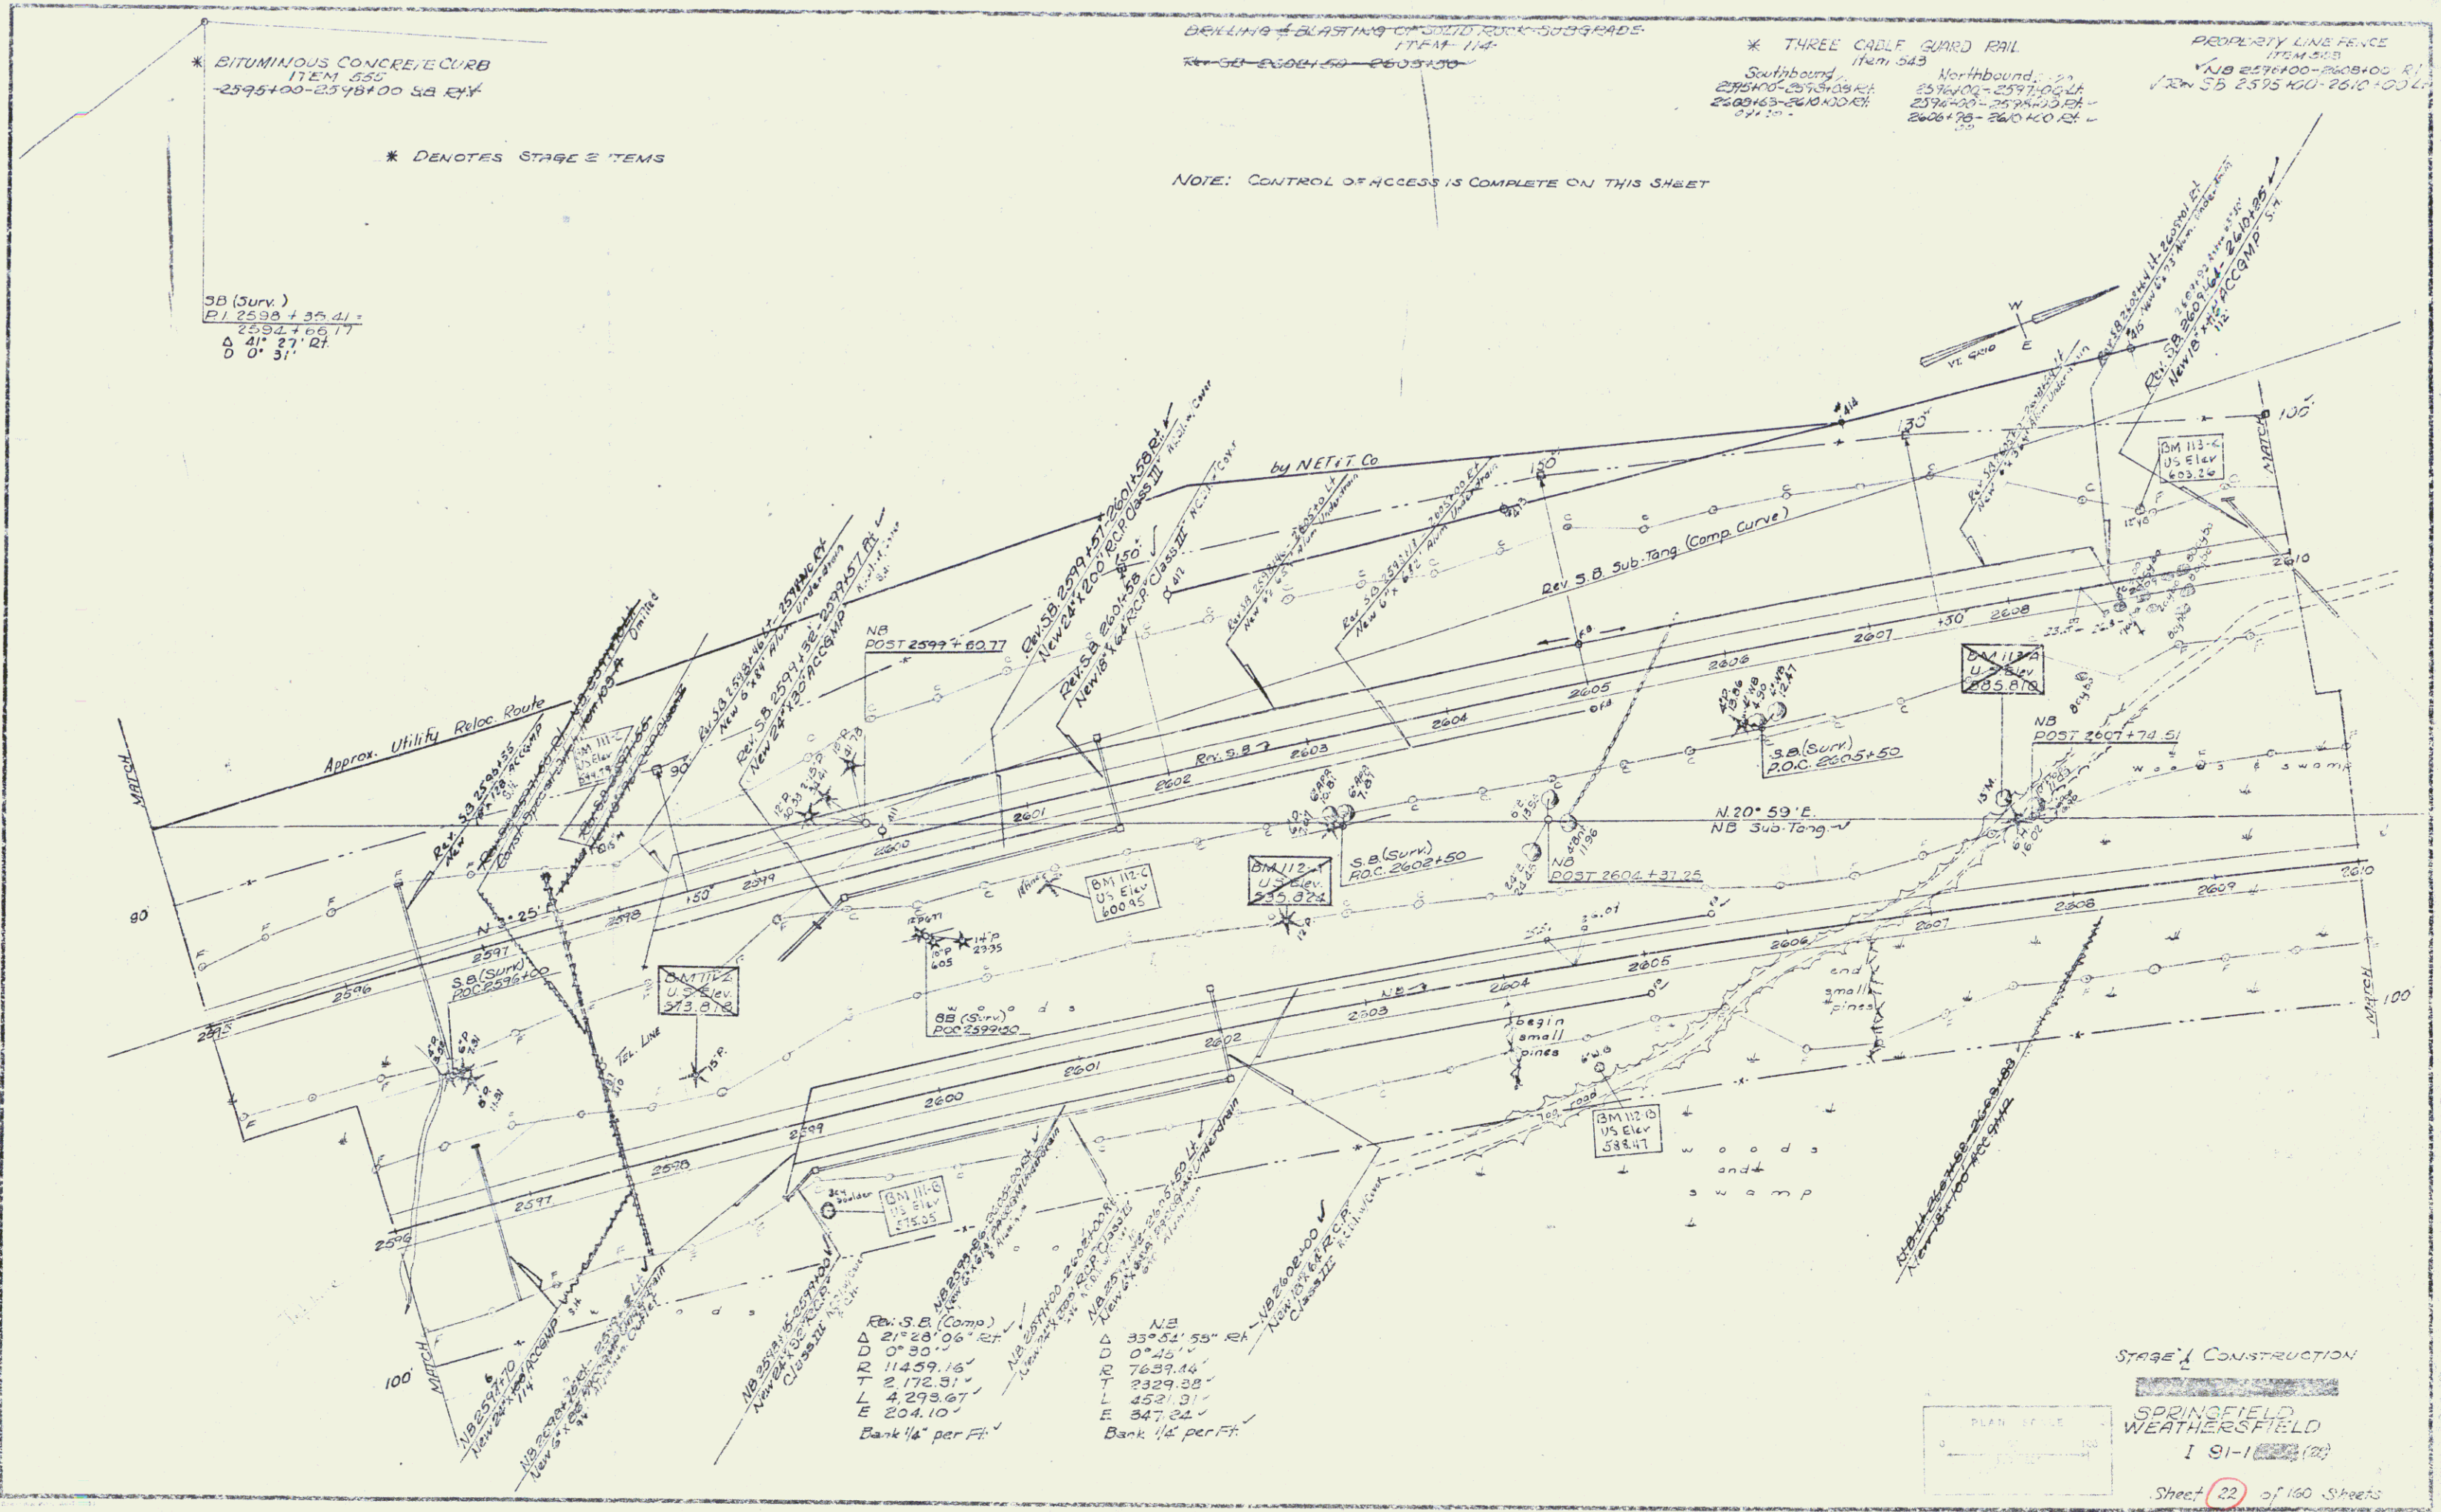

Rev. S.B. (Comp.)
Δ 21° 28' 06" RT
D 0° 30'
R 11459.16'
T 2 172.31'
L 4 293.67'
E 204.10'
Bank 1/4' per Ft.

NB
Δ 35° 51' 55" RT
D 0° 45'
R 7639.14'
T 2 329.32'
L 4 293.67'
E 347.24'
Bank 1/4' per Ft.



STAGE 1 CONSTRUCTION

SPRINGFIELD
WEATHERSFIELD

1 S1-1 (2)

Sheet 22 of 160 Sheets