

UTE MATTING, ITEM 623
MeL NB Lt 2696+50 - 2698+53

DRILLING & BLASTING OF SOLID ROCK SUBGRADE
14m 11.4
SB 2696+00 2698+00 2696+00 2697+50

NOTE: Prior to the commencement of construction construct property line fence with steel posts, 11m 503+15 is stationed below.

THREE CABLE GUARD RAIL
S.B. ITEM 543
2696+00 - 2700+00

DRILLING & BLASTING OF SOLID ROCK
14m 11.2
NB 2694+50 271+50

PROPERTY LINE FENCE
Item 553
SB 2696+00 - 2700+00


NOTE: CONTROL OF ACCESS IS COMPLETE ON THIS SHEET.

★ DENOTES STAGE 2 ITEMS

UTILITY ACCESS
LT. OF STA 2698+00

Rev Sta 2700+00 NB 655
SB Construction
Contract 2
Contract 3

POOR ORIGINAL COPY

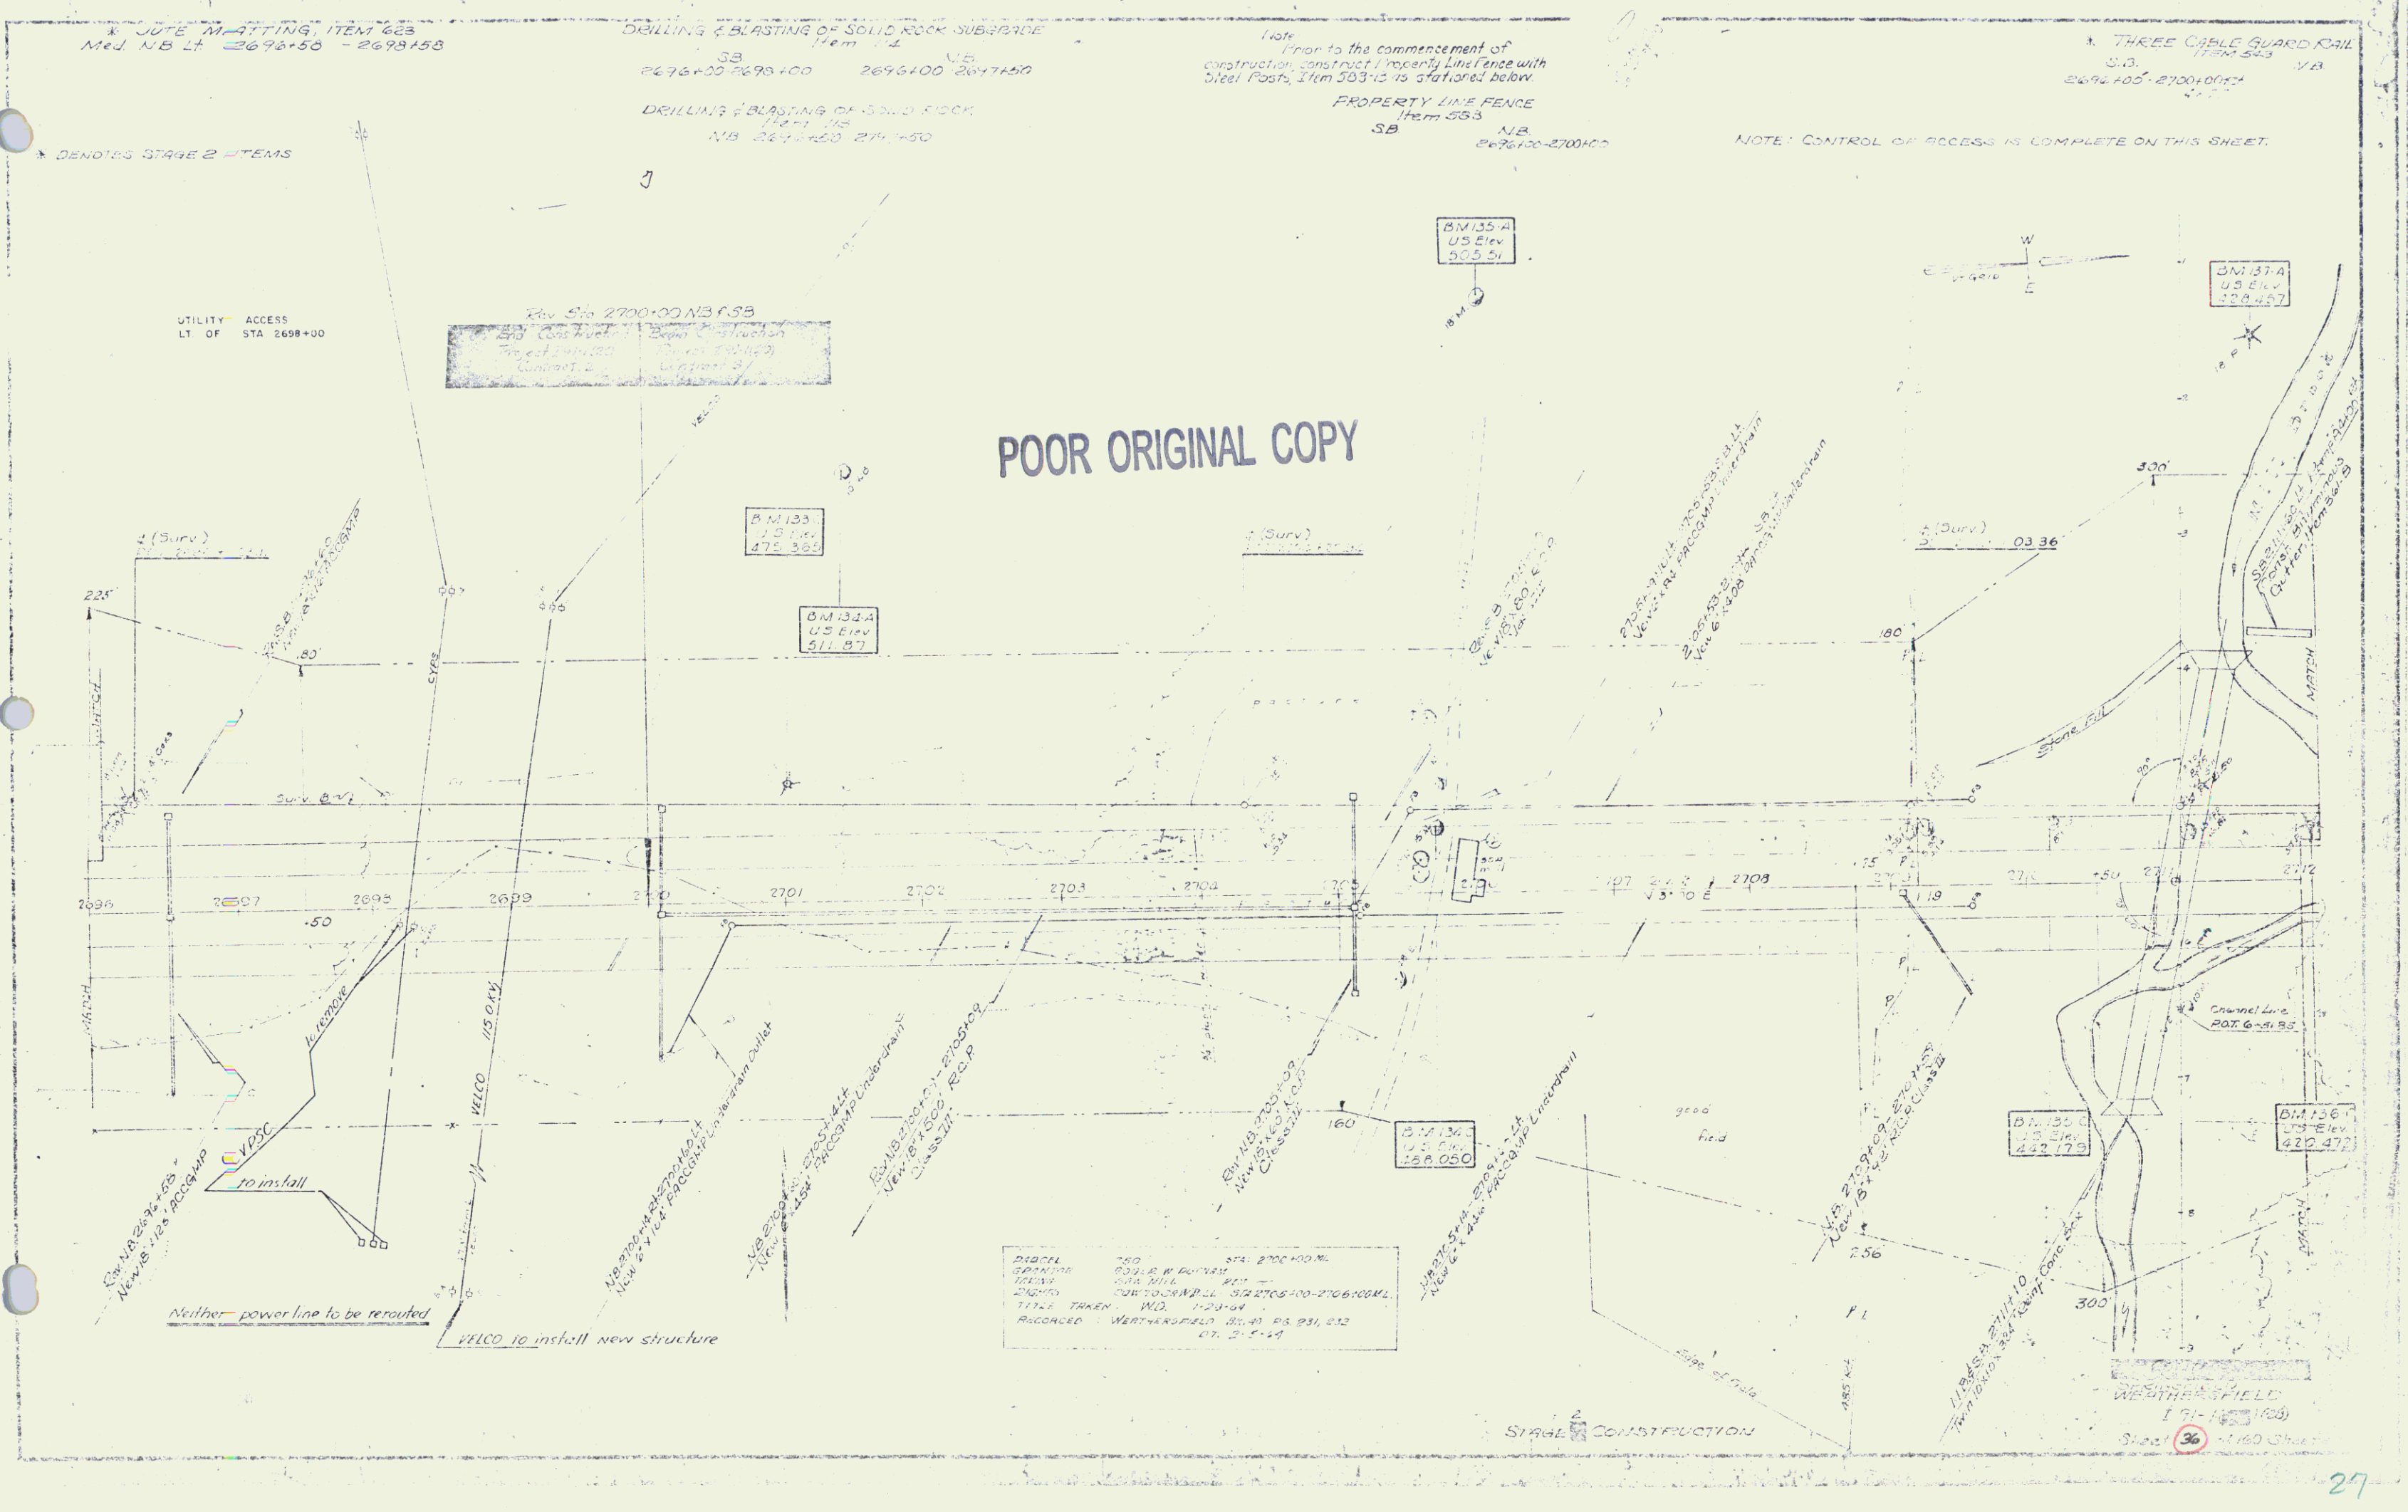

DESIGN: 260 STA. 2700+00 ML
DRAWING: SOLID R. FENCE
SCALE: 1" = 40' HORIZ. 1" = 10' VERT.
DIGNO: CURTIS R. BELL 312705+00-2706+00 ML
TITLE TAKEN: MD. 1-20-04
PRODUCED: WETHERFIELD BLDG. 15 231, 232
DT. 2-5-14