

\* JUTE MATTING, ITEM 585  
 Med. N.B. LA 2730+00 - 2732+00  
 Med. N.B. LA 2735+50 - 2735+50  
 Med. N.B. LA 2738+50 - 2740+00

NOTE: CONTROL OF ACCESS IS COMPLETE ON THIS SHEET  
 VT. RTE. 181 IS TO BE BUILT IN ITS ENTIRETY  
 DURING STAGE I CONSTRUCTION.

Two Cable Guard Rails  
 TR #20  
 0+24 - 0+48 LA

BIT. CONC. SURFACE FOR GUTTERS  
 AND TRAFFIC ISLANDS  
 N.B. 2723+00 LA RAMP D 4+30 LA  
 S.B. 2723+00 LA RAMP D 9+50 LA  
 S.B. 2732+00 LA  
 S.B. 2735+00 LA  
 S.B. 2740+00 LA

PARCEL 251C  
 STA 2740+00 - 2738+00 ML  
 TAKING 132 R2LA

PARCEL 254 STA 18+00 RT-121-000 TR-10  
 GRANTOR GUY W & MURIEL RAYMOND  
 TAKING 0 TAX REM 9941  
 RIGHTS DRAINAGE 12-615 LA, 2100 LA  
 TITLE TAKEN COND O 1-6-64  
 RECORDED WETHERFIELD BK 40 PG 125 DT 1-9-64

PARCEL 255 STA 17+50 - 19+03 RT-111  
 GRANTOR HERBERT L & MARIE M. STODOLSKY  
 TAKING 1500 SQ FT REM NONE  
 RIGHTS SLOPE STA 17+50 - 18+10 LT  
 VT RTE 181 (1360 SQ FT)  
 TITLE TAKEN WD 12-21-63  
 RECORDED WETHERFIELD BK 40 PG 125 DT 1-10-64

Ramp 101  
 A 17+38.20 LA  
 D 7+00  
 T 57+29.58  
 L 152.14  
 E 2.87  
 Bank 1' per ft


SR 10  
 A 17+25.32  
 D 40.00  
 T 43.00  
 L 128.92  
 E 17.28  
 Bank 3/4' per ft

181 Construct Drive  
 17+80 LA  
 17+00 RT

\* THREE CABLE GUARD RAIL  
 Item 543

DELLINS & BUSTING OF SOLID ROCK - SUBGRADE

PROPERTY LINE FENCE

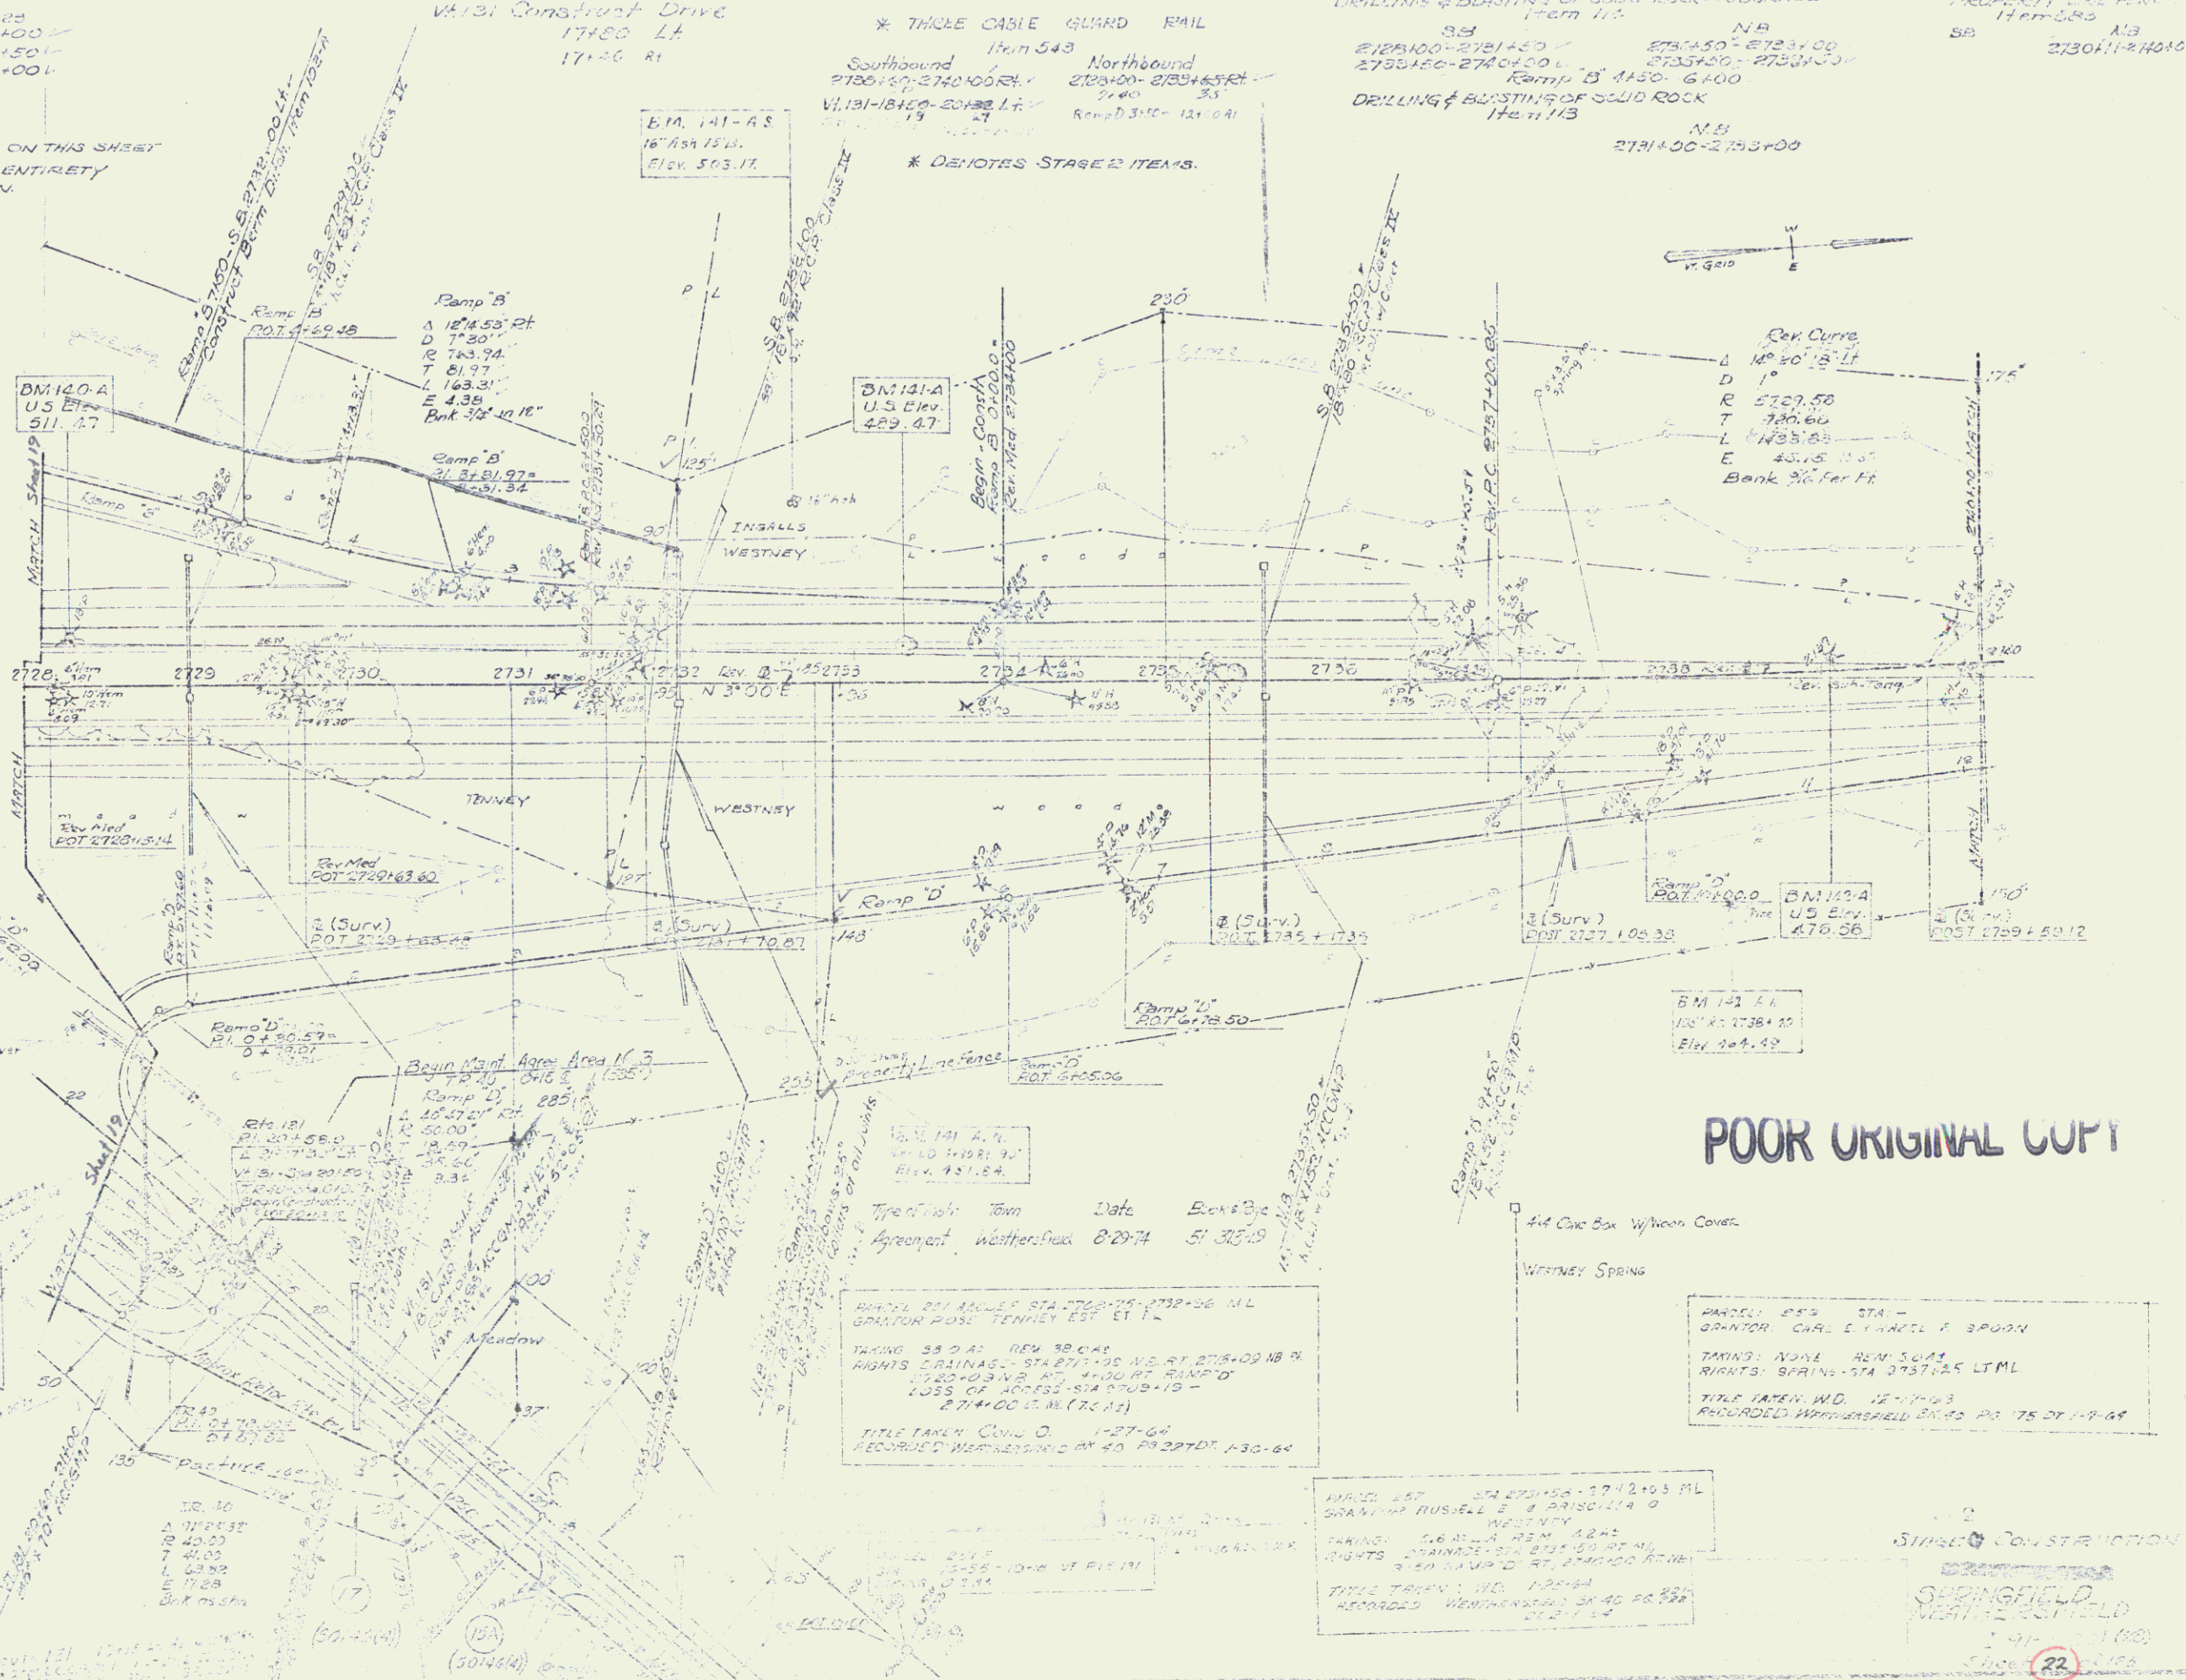

Prop Curve  
 L 40+00  
 T 7+00  
 E 43+15  
 Bank 3/4' per ft

POOR ORIGINAL COPY

Type of soil: Tom Date: 8-29-74  
 Agreement: Wetherfield 8-29-74 51 325-19

PARCEL 251 ACRES STA 17+50 - 17+03 ML  
 GRANTOR POSE TENNEY EST ET AL  
 TAKING 38 00 LA REM 9804  
 RIGHTS CRAINAS - STARTS 00 WE RT 17+50-00 NB  
 17+00-00 NB AT 4+00 RT RAMP D  
 LOSS OF ACCESS STA 17+50-10 -  
 27+00 LT M (R 12)  
 TITLE TAKEN COND O 1-27-64  
 RECORDED WETHERFIELD BK 40 PG 27 DT 1-30-64

PARCEL 252 STA -  
 GRANTOR CHAR E & MARIE A BRUGH  
 TAKING NONE REM 9844  
 RIGHTS BRUGH STA 17+50-00 LT ML  
 TITLE TAKEN WD 12-11-63  
 RECORDED WETHERFIELD BK 40 PG 125 DT 1-9-64

PARCEL 257 STA 27+50 - 27+21 05 ML  
 GRANTOR RUSSELL E & BRISCELLA O  
 TAKING 16 50 LA REM 1242  
 RIGHTS GRANTOR STA 27+50-00 RT ML  
 27+00-00 RT STA 27+00-00 RT  
 TITLE TAKEN WD 12-10-64  
 RECORDED WETHERFIELD BK 40 PG 125  
 DT 1-9-64

SPRINGFIELD  
 WETHERFIELD  
 Sheet 22