


STATE OF VERMONT  
DEPARTMENT OF HIGHWAYS

PROPOSED IMPROVEMENT

INTERSTATE PROJECT  
TOWN OF HARTFORD  
COUNTY OF WINDSOR  
INTERSTATE ROUTE 91  
BELLOWS FALLS - BRADFORD ROAD

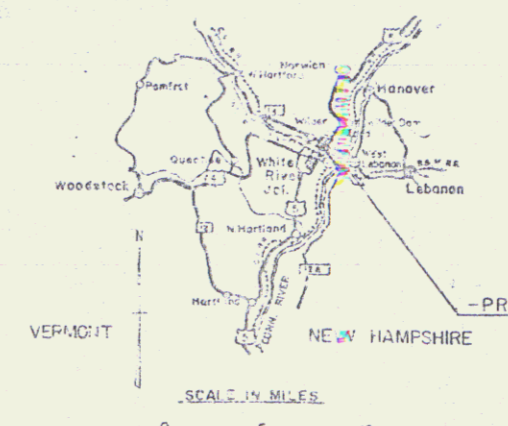


- 1 SHEET NO. 1 TITLE PAGE
- 2 BIDDING QUANTITY SHEET
- 3-5 PLAN AND PROFILE SHEETS
- 6 E-1 MATERIALS, SIGNS AND LIGHTS (BRIDGE)
- 7 E-2 CONSTRUCTION IDENTIFICATION SIGNS
- 8 E-3 MARKERS
- 9 E-4 FIELD OFFICE
- 10 PLAN AND ELEVATION - (1" = 40' SCALE)
- 11-15 PLAN AND ELEVATION - (1" = 20' SCALE)
- 16 GENERAL NOTES
- 17 PRELIMINARY FOUNDATION SHEET
- 18-19 EARTHWORK SHEETS
- 20 FRAMING PLAN, DETAILS, TYPICAL CROSS-SECTION
- 21 BRIDGE DETAILS
- 22 JOINTS, DEAD LOAD DEFLECTION, SHEARS, REACTIONS
- 23 TYPICAL EXPANSION DEVICE
- 24 BELLEVUE
- 25 BEARING DEVICES
- 26 ADJUSTMENT NO. 1 NB
- 27 ADJUSTMENT NO. 1 SB
- 28 ADJUSTMENT NO. 2 NB AND SB
- 29 PIER NO. 1 NB AND SB
- 30 PIER NO. 1 RB AND SB
- 31 PIER NO. 2 NB AND SB
- 32 PIER NO. 2 RB AND SB
- 33 PIER NO. 3 NB AND SB
- 34 PIER NO. 3 RB AND SB
- 35 PIER NO. 4 NB AND SB
- 36 PIER NO. 4 RB AND SB
- 37-40 REINFORCING STEEL DETAIL SHEETS
- 41-42 CHANNEL SECTIONS
- 43-44 ROADWAY CROSS SECTIONS
- 45-46 TCB - C4-65, DETAILS "A" AND "B"
- 47 SCD - D7-65, DETAIL "A"
- 48-50 RB-64, SHEETS 1 AND 2
- 51-52-55 RB-64-65
- 56-59 RB-64-65

Project # 191-2 (a) STAGE I

BEGINNING AT A POINT 3.362 MILES NORTH OF THE HARTLAND-HARTFORD  
TOWN LINE AT NB 3775+80.50 AND EXTENDING NORTHERLY 0.245 MILE TO NB STA 3775+87.50  
SB 3764+30.50  
LENGTH OF BRIDGE NB 1176.00 FEET - 0.225 MILE  
NB STA 3775+80.50  
SB STA 3776+40.50

ADT 1965	2000
ADT 1965	4800
Div 1965	7750
D	7%
V	60'


CONTRACTOR - K. H. MILLER & SONS, INC. - HOLYOKE, MASS.  
DATE - SEPTEMBER 27, 1967  
DESIGNED BY - THOMAS R. BENTLEY  
CHECKED BY - P. PLUMB  
RECORD PLANS - A. A. WHEELER & SONS  
DATE - OCTOBER 1, 1968  
APPROVED - NOVEMBER 8, 1967  
REVISIONS - JANUARY 18, 1967

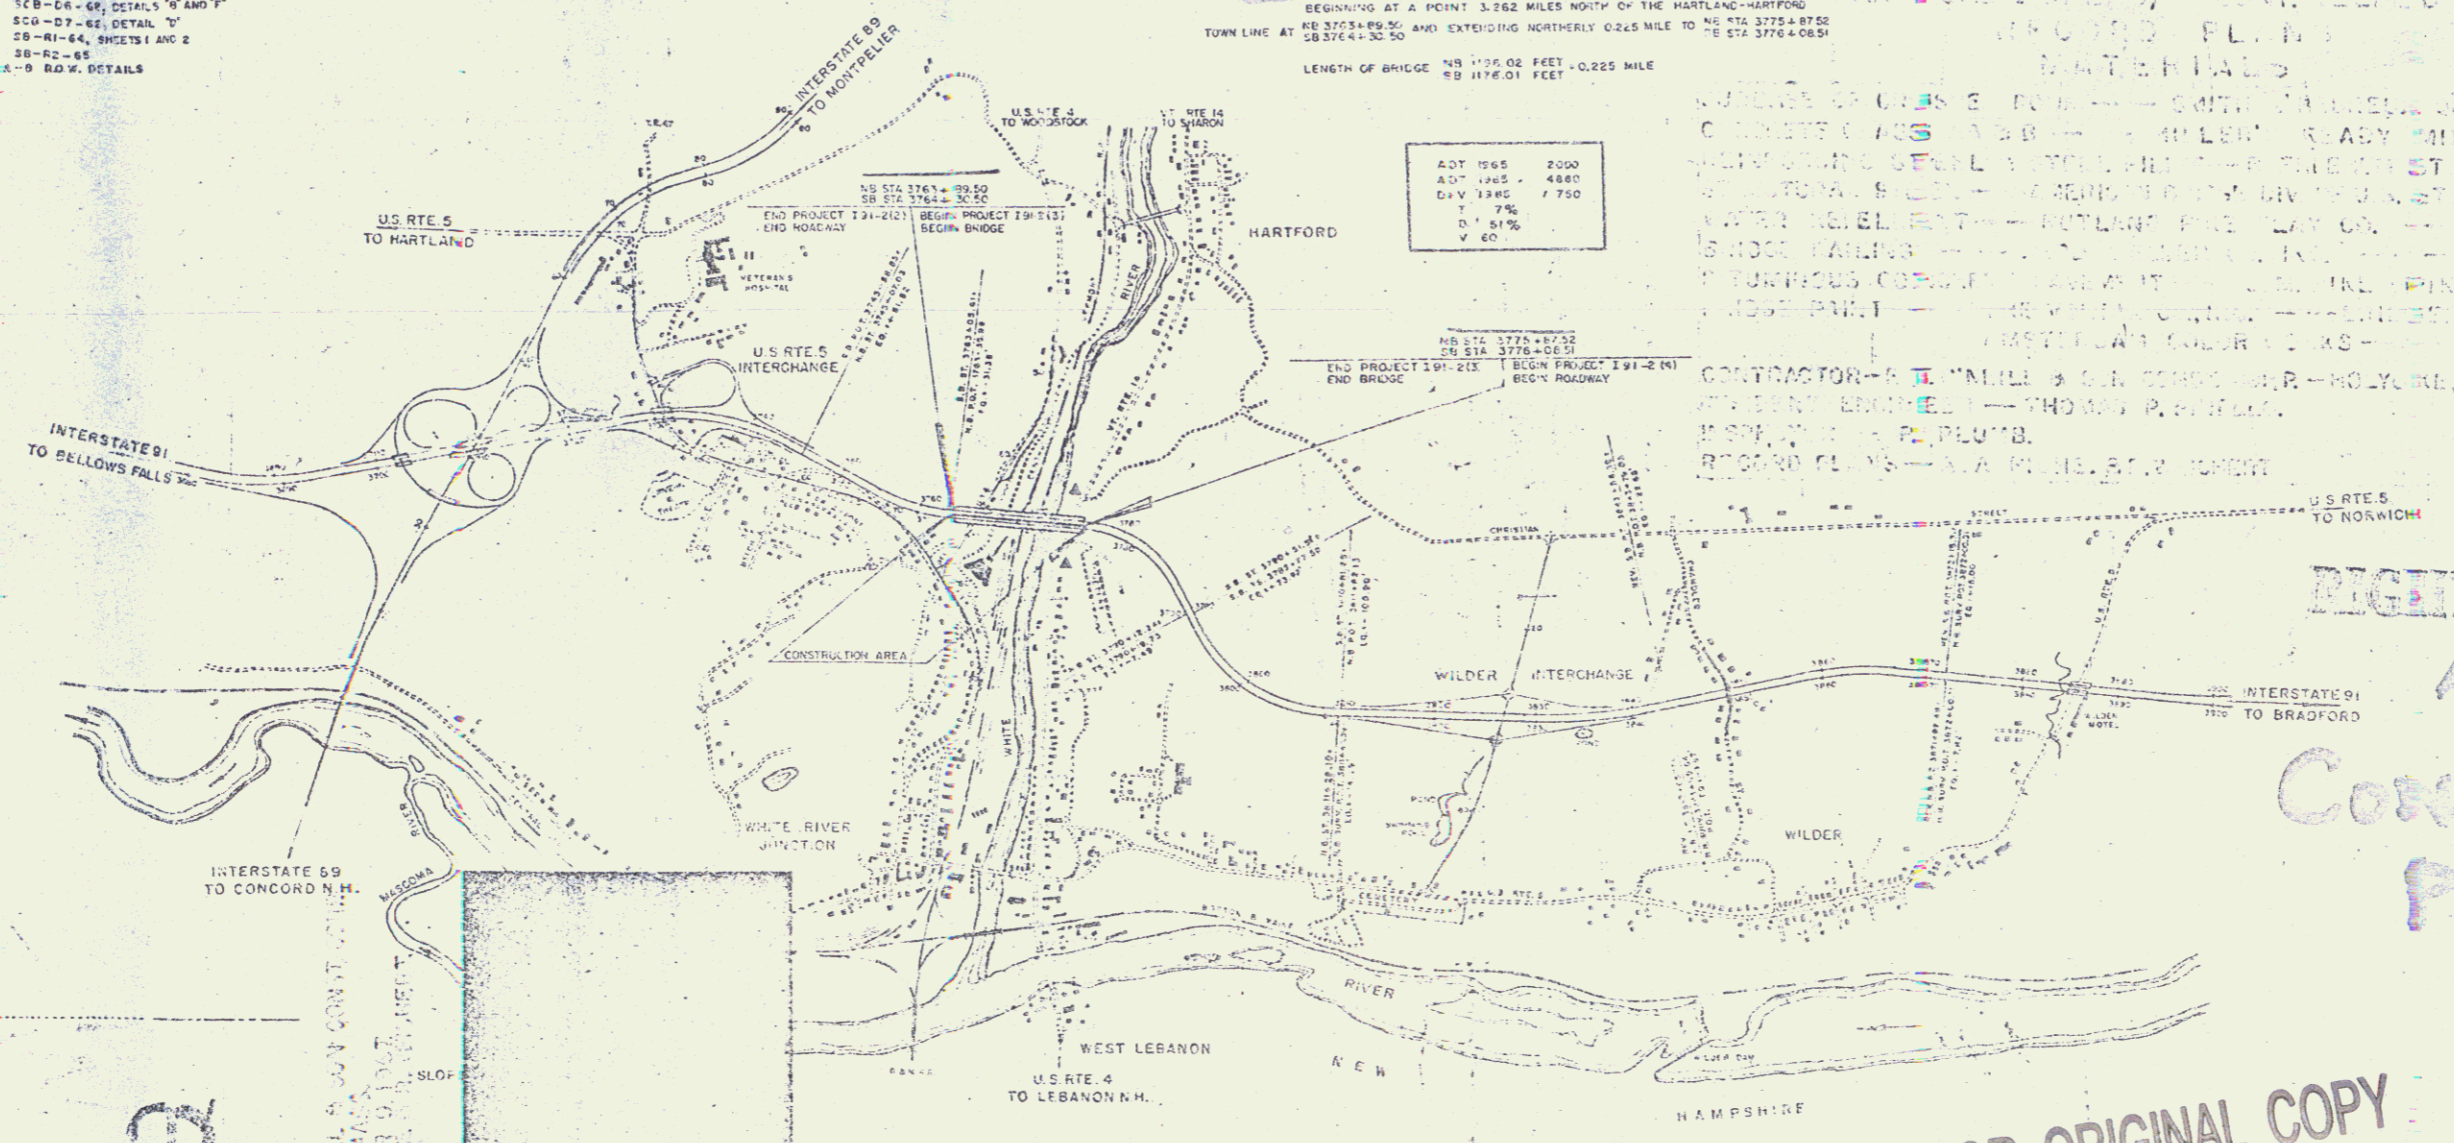

RIGHT-OF-WAY  
AND  
CONSTRUCTION  
PLANS

POOR ORIGINAL COPY

162

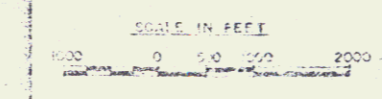

Bill Gould 7/7/67  
Ed Hubing 8/1/67  
L. Hubing 11/2/67  
J. Chase 11/2/67  
W. M. Lane 1/1/68  
A. J. Bandy 1/1/68

NOV 12 1973

1 2