


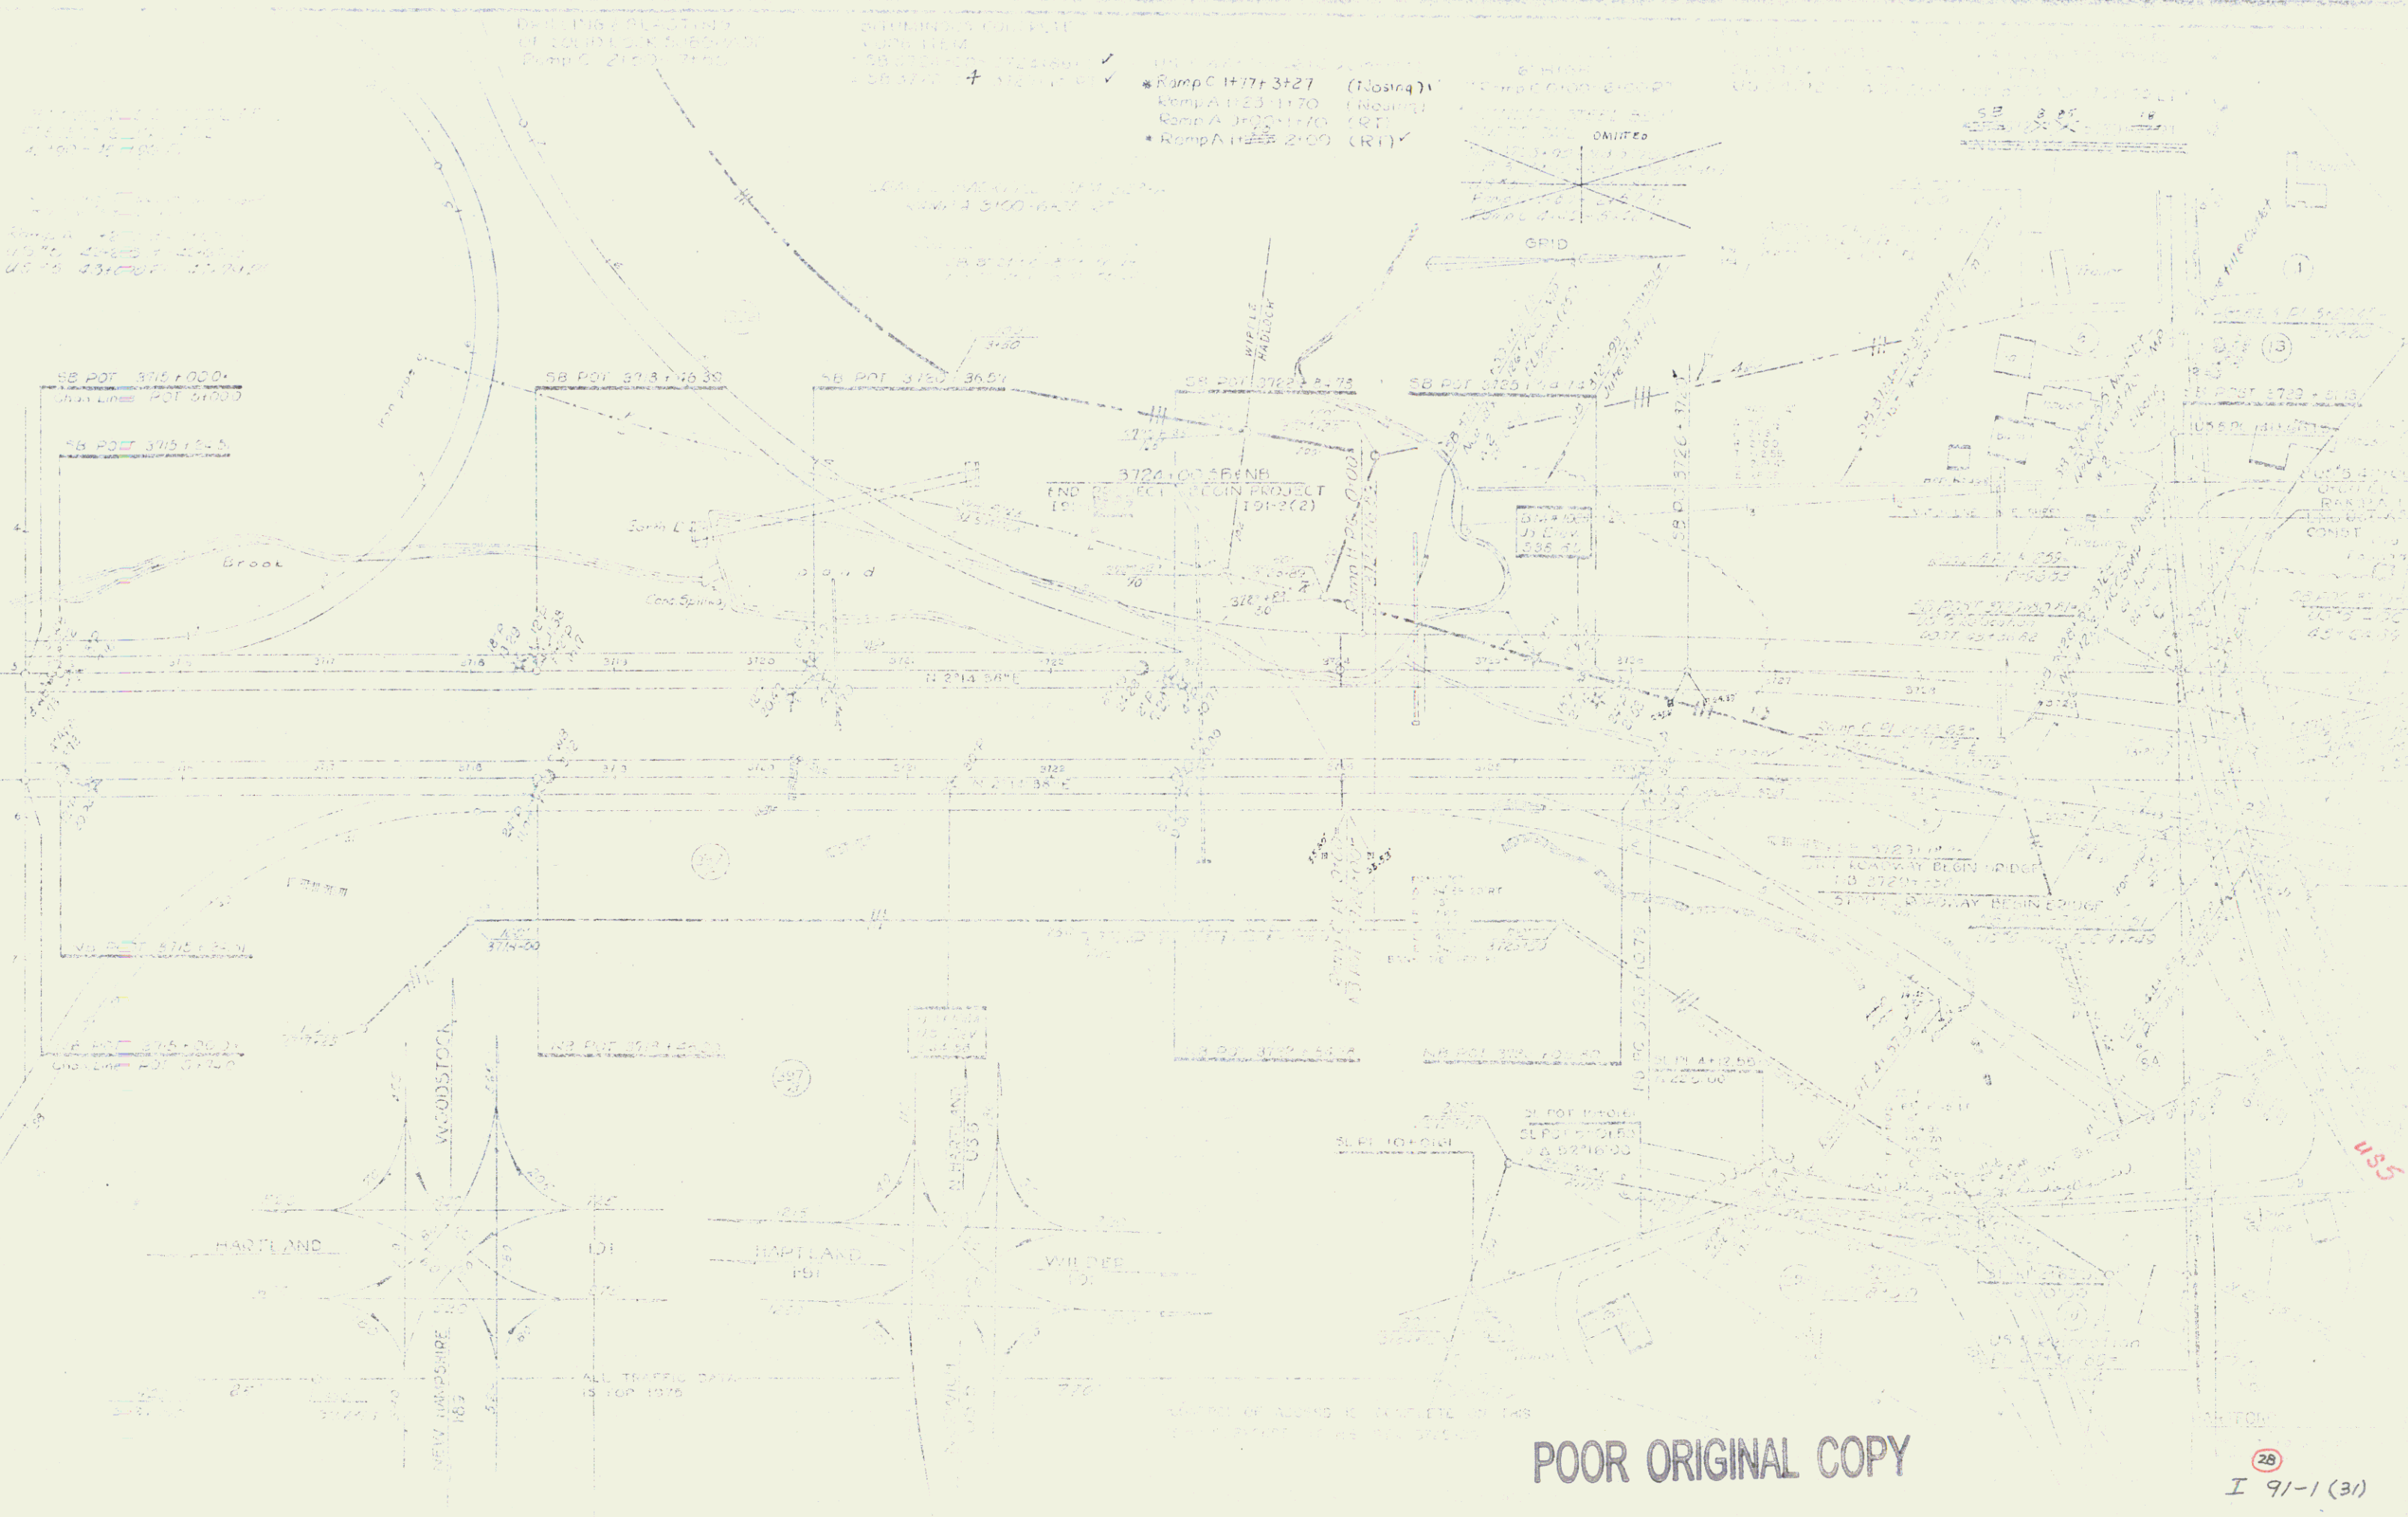

POOR ORIGINAL COPY