

DEMOLITION ITEM  
 US 5 41+50 RT #2  
 US 5 41+15 RT #2  
 US 5 40+00 LT #1  
 US 5 41+00 LT #3  
 U 41+55

CHAIN LINK FENCE 6' HIGH  
 Ramp B 10+00-20+00 RT

DRILLING & BLASTING OF SOLID ROCK SUBGRADE  
 Ramp B 10+00-19+50  
 Ramp A 2+00-3+00  
 Ramp A 4+50-12+00  
 Ramp A 5+50-6+00

TOPSOIL ITEM  
 US 5 34+50-39+00 LT  
 US 5 34+50-39+00 RT

SLOPE EDGING  
 Ramp A 8+38-12+04 RT  
 Ramp B 10+08-20+35 LT  
 RAMP B 20+35-20+85 LT

CONST DRIVED  
 US 5 35+70 RT COMM  
 US 5 36+35 RT COMM  
 WINDSOR DRIVE STA 1+15  
 US 5 36+77 LT  
 US 5 31+90 RT  
 WINDSOR DRIVE STA 3+40 LT

PROPERTY LINE FENCE  
 US 5 38+75-42+25 RT


RAMPA 3+00-6+25 RT

DRILLING & PRESPLITTING OF SOLID ROCK, ITEM 125  
 RAMP B 11+00-17+25

RAMP "B" #2  
 D 73' 54" 22' LT  
 R 284.71  
 T 214.8  
 L 38' 55"  
 E 1' 16"  
 BANK 15.6' PER FT

RAMP "A" #5  
 D 88' 21" 6" RT  
 R 276.71  
 T 270.00  
 L 1' 16"  
 E 1' 16"  
 BANK 15.6' PER FT

PLAN CHECKED  
 APPROVED  
 DATE

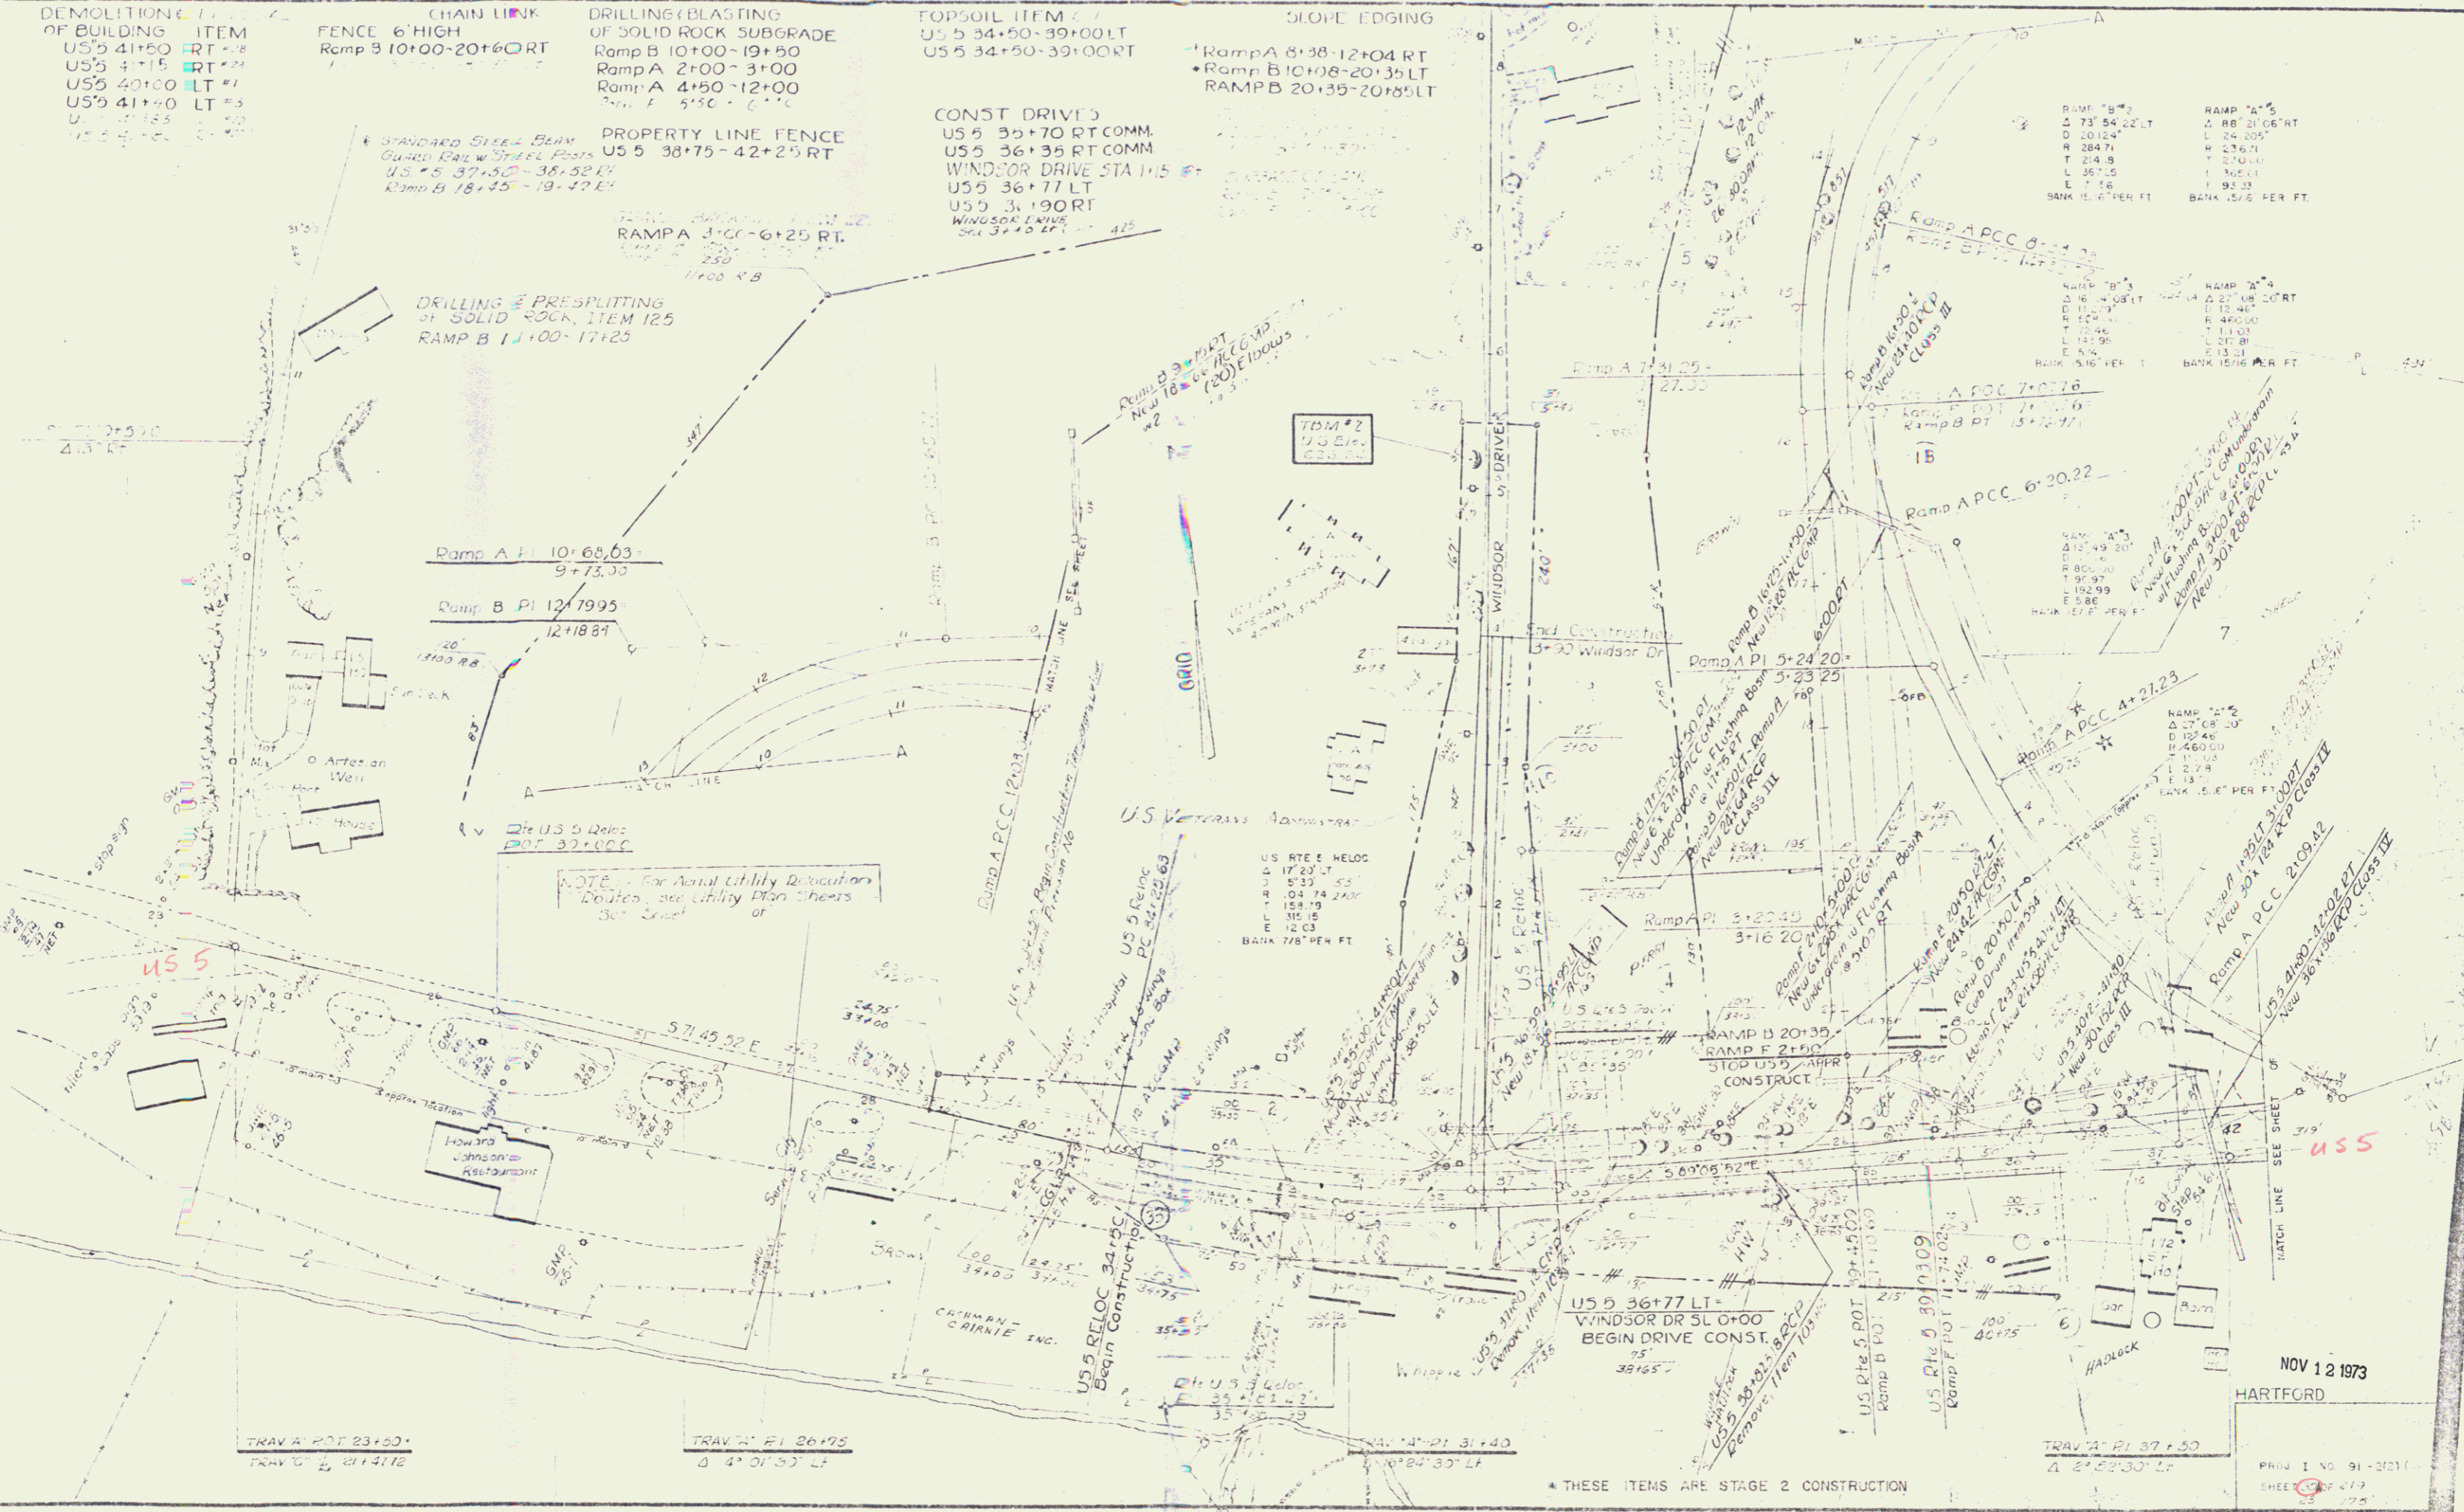

NOV 12 1973  
 HARTFORD

\* THESE ITEMS ARE STAGE 2 CONSTRUCTION

PROJ NO 91-2031  
 SHEET 219