


PROPERTY LINE FENCE
w STEEL POSTS
NB 3763+00-3763+91

THREE CABLE GUARD
RAIL w STEEL POSTS
ITEM
* SB 3763+00-3764+00 LT
* NB 3763+00-3763+03 LT
* NB 3763+00-3763+03 RT

* STANDARD 4" x 4" x 1/2" M
GUARD RAIL
* 3763+00-3764+00 LT
* 3763+00-3763+03 LT
* 3763+00-3763+03 RT

OUTLINE OF ABUTMENT & PIER FOOTINGS APPROX

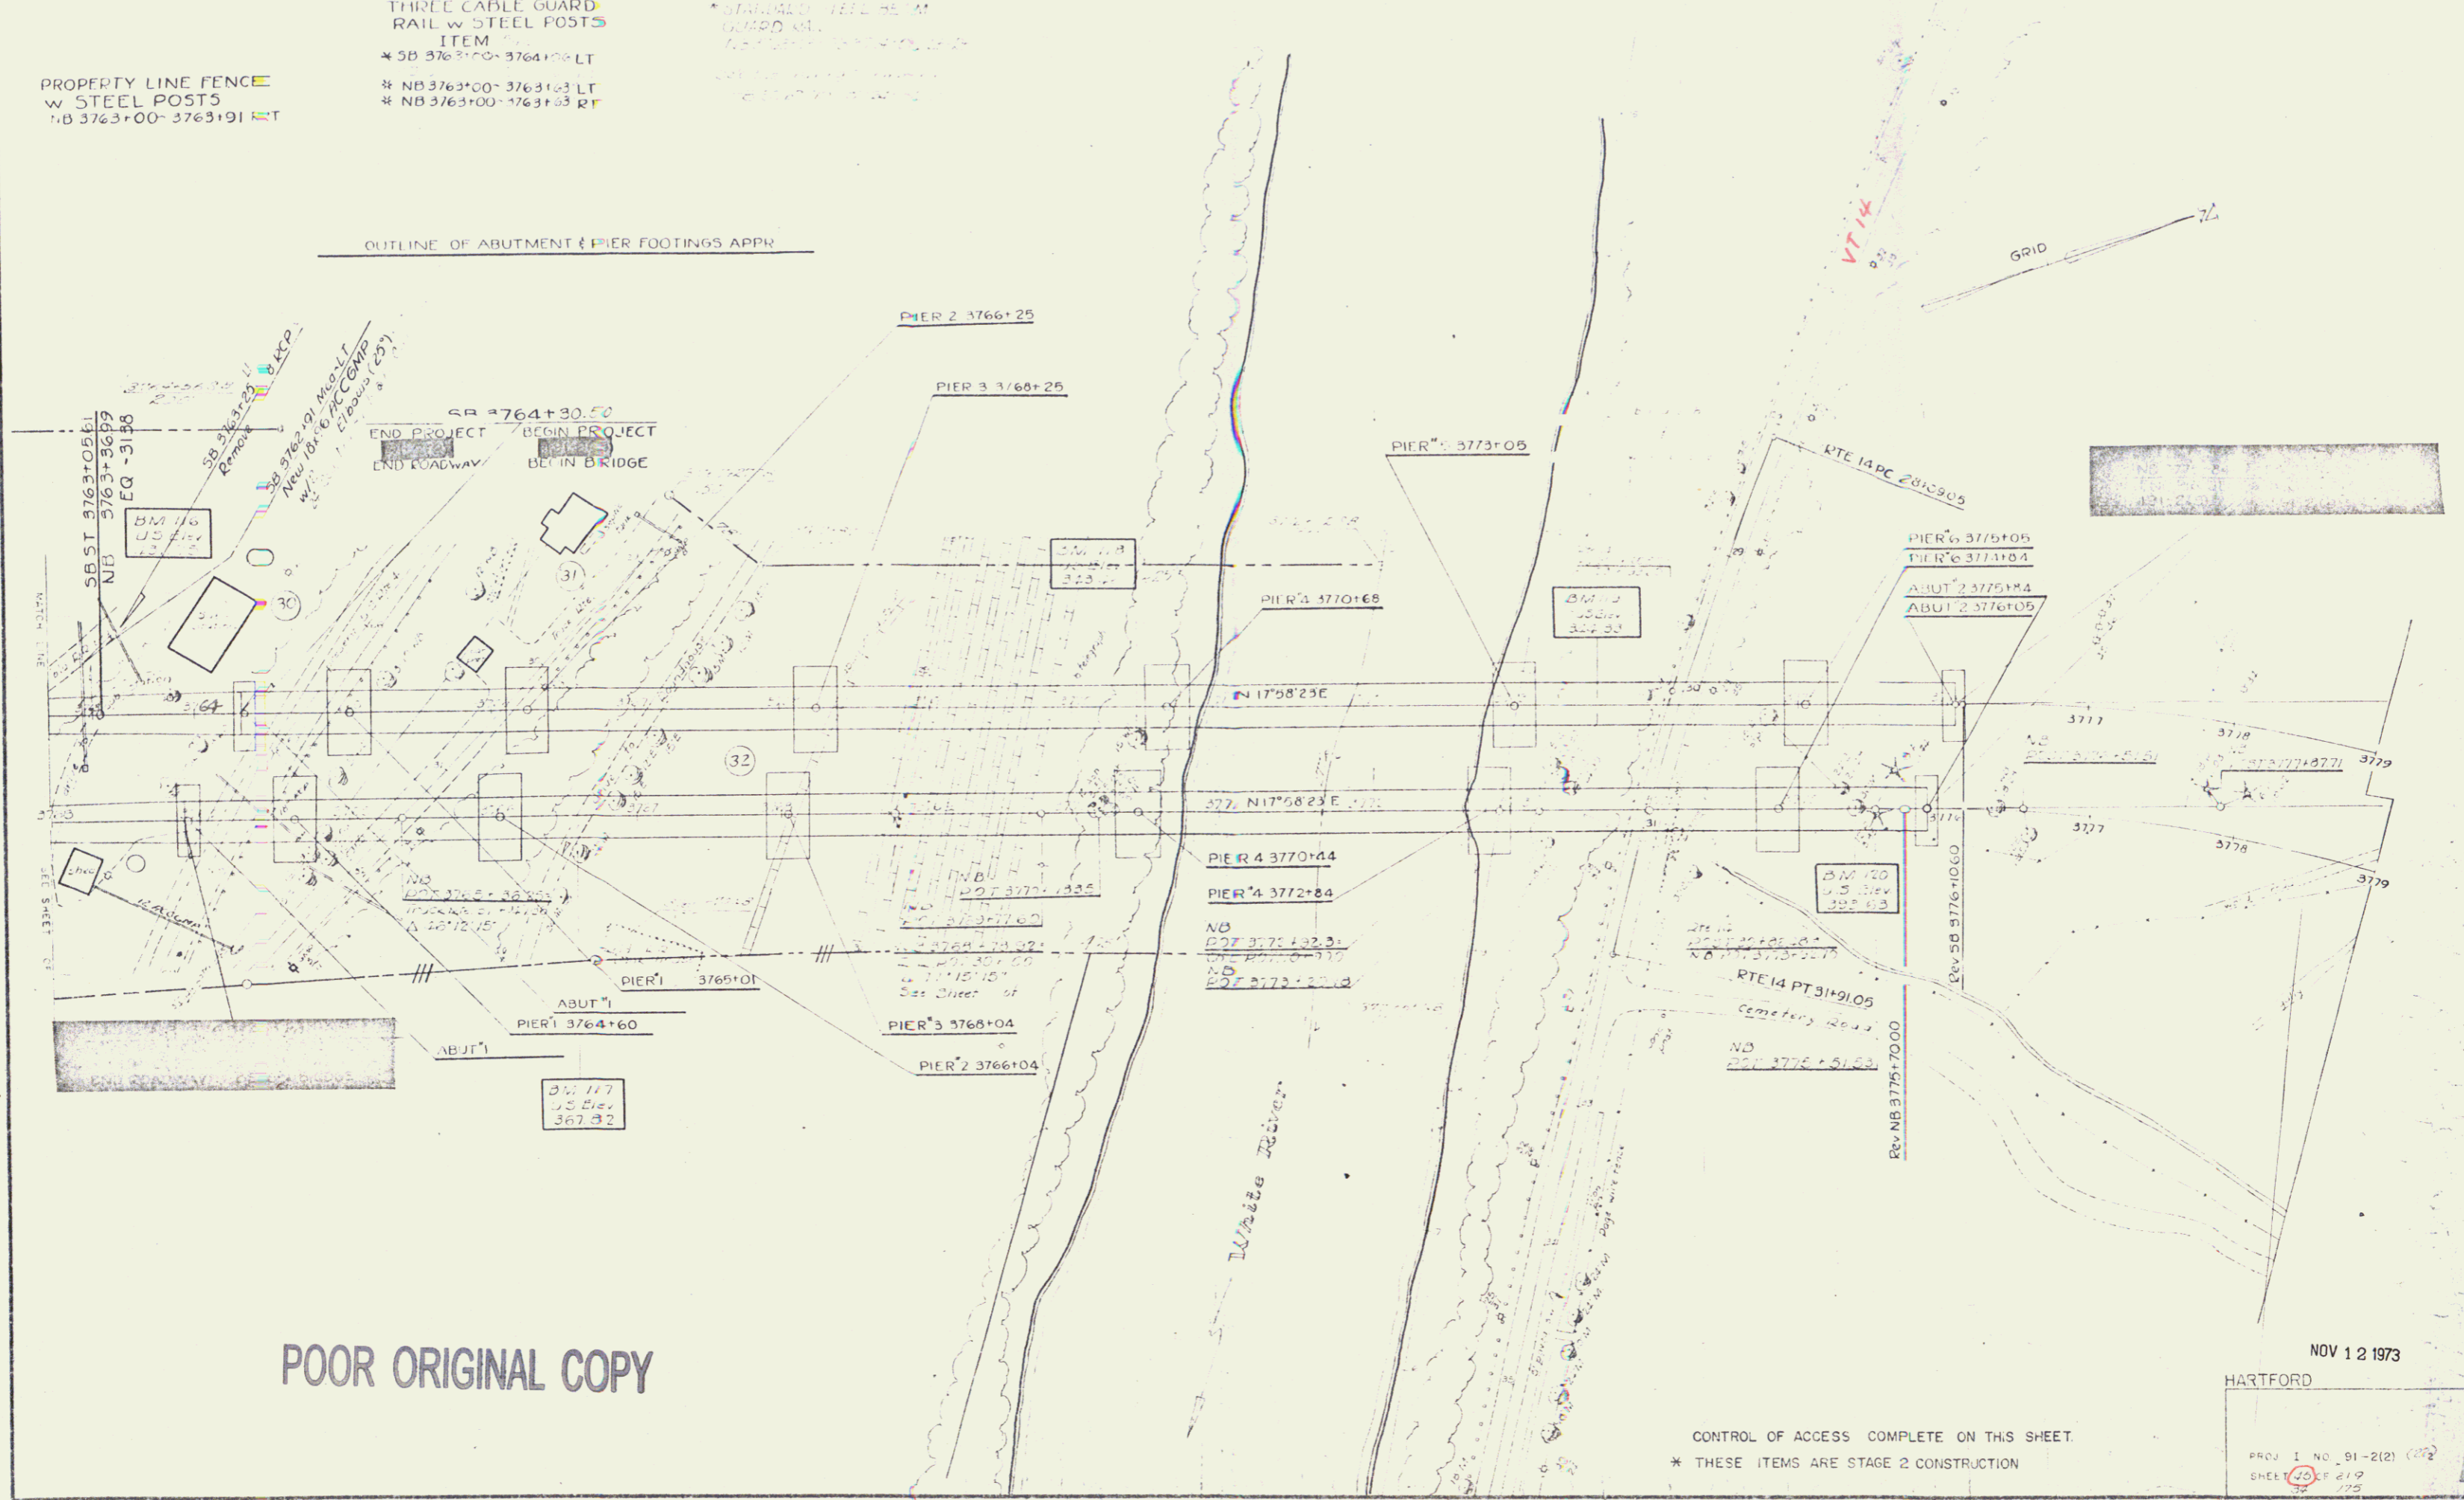

POOR ORIGINAL COPY

NOV 12 1973

HARTFORD

CONTROL OF ACCESS COMPLETE ON THIS SHEET.
* THESE ITEMS ARE STAGE 2 CONSTRUCTION

PROJ 1 NO. 91-2(2)
SHEET 20 OF 219