

DRILLING & BLASTING OF SOLID
ROCK SUBGRADE ITEM
NB 3800+25 - 3811+00
SB 3789+75 - 3811+00


* THREE CABLE GUARD RAIL w/
STEEL POSTS ITEM
NB 3785+00 - 3789+15 Rt
SB 3785+00 - 3801+00 Rt

Spiral Curve Data
NB 350+00 curve
 Δ 60° 45' 45" Lt
Dc 3' 30"
Rc 1637.02
Ls 445.00
Ts 374.37
Ss 374.37
Bant 1/8" per ft

NB 150 out of curve
 Δ 60° 45' 45" Lt
Dc 3' 30"
Rc 1637.02
Ls 300.00
Ts 374.37
Ss 374.37
Bant 1/8" per ft

* STANDARD STEEL BEAM
GUARD RAIL w/STEEL POSTS
NB 3808+25 - 3809+27 Rt

See alignment data sheet
spiral curve information

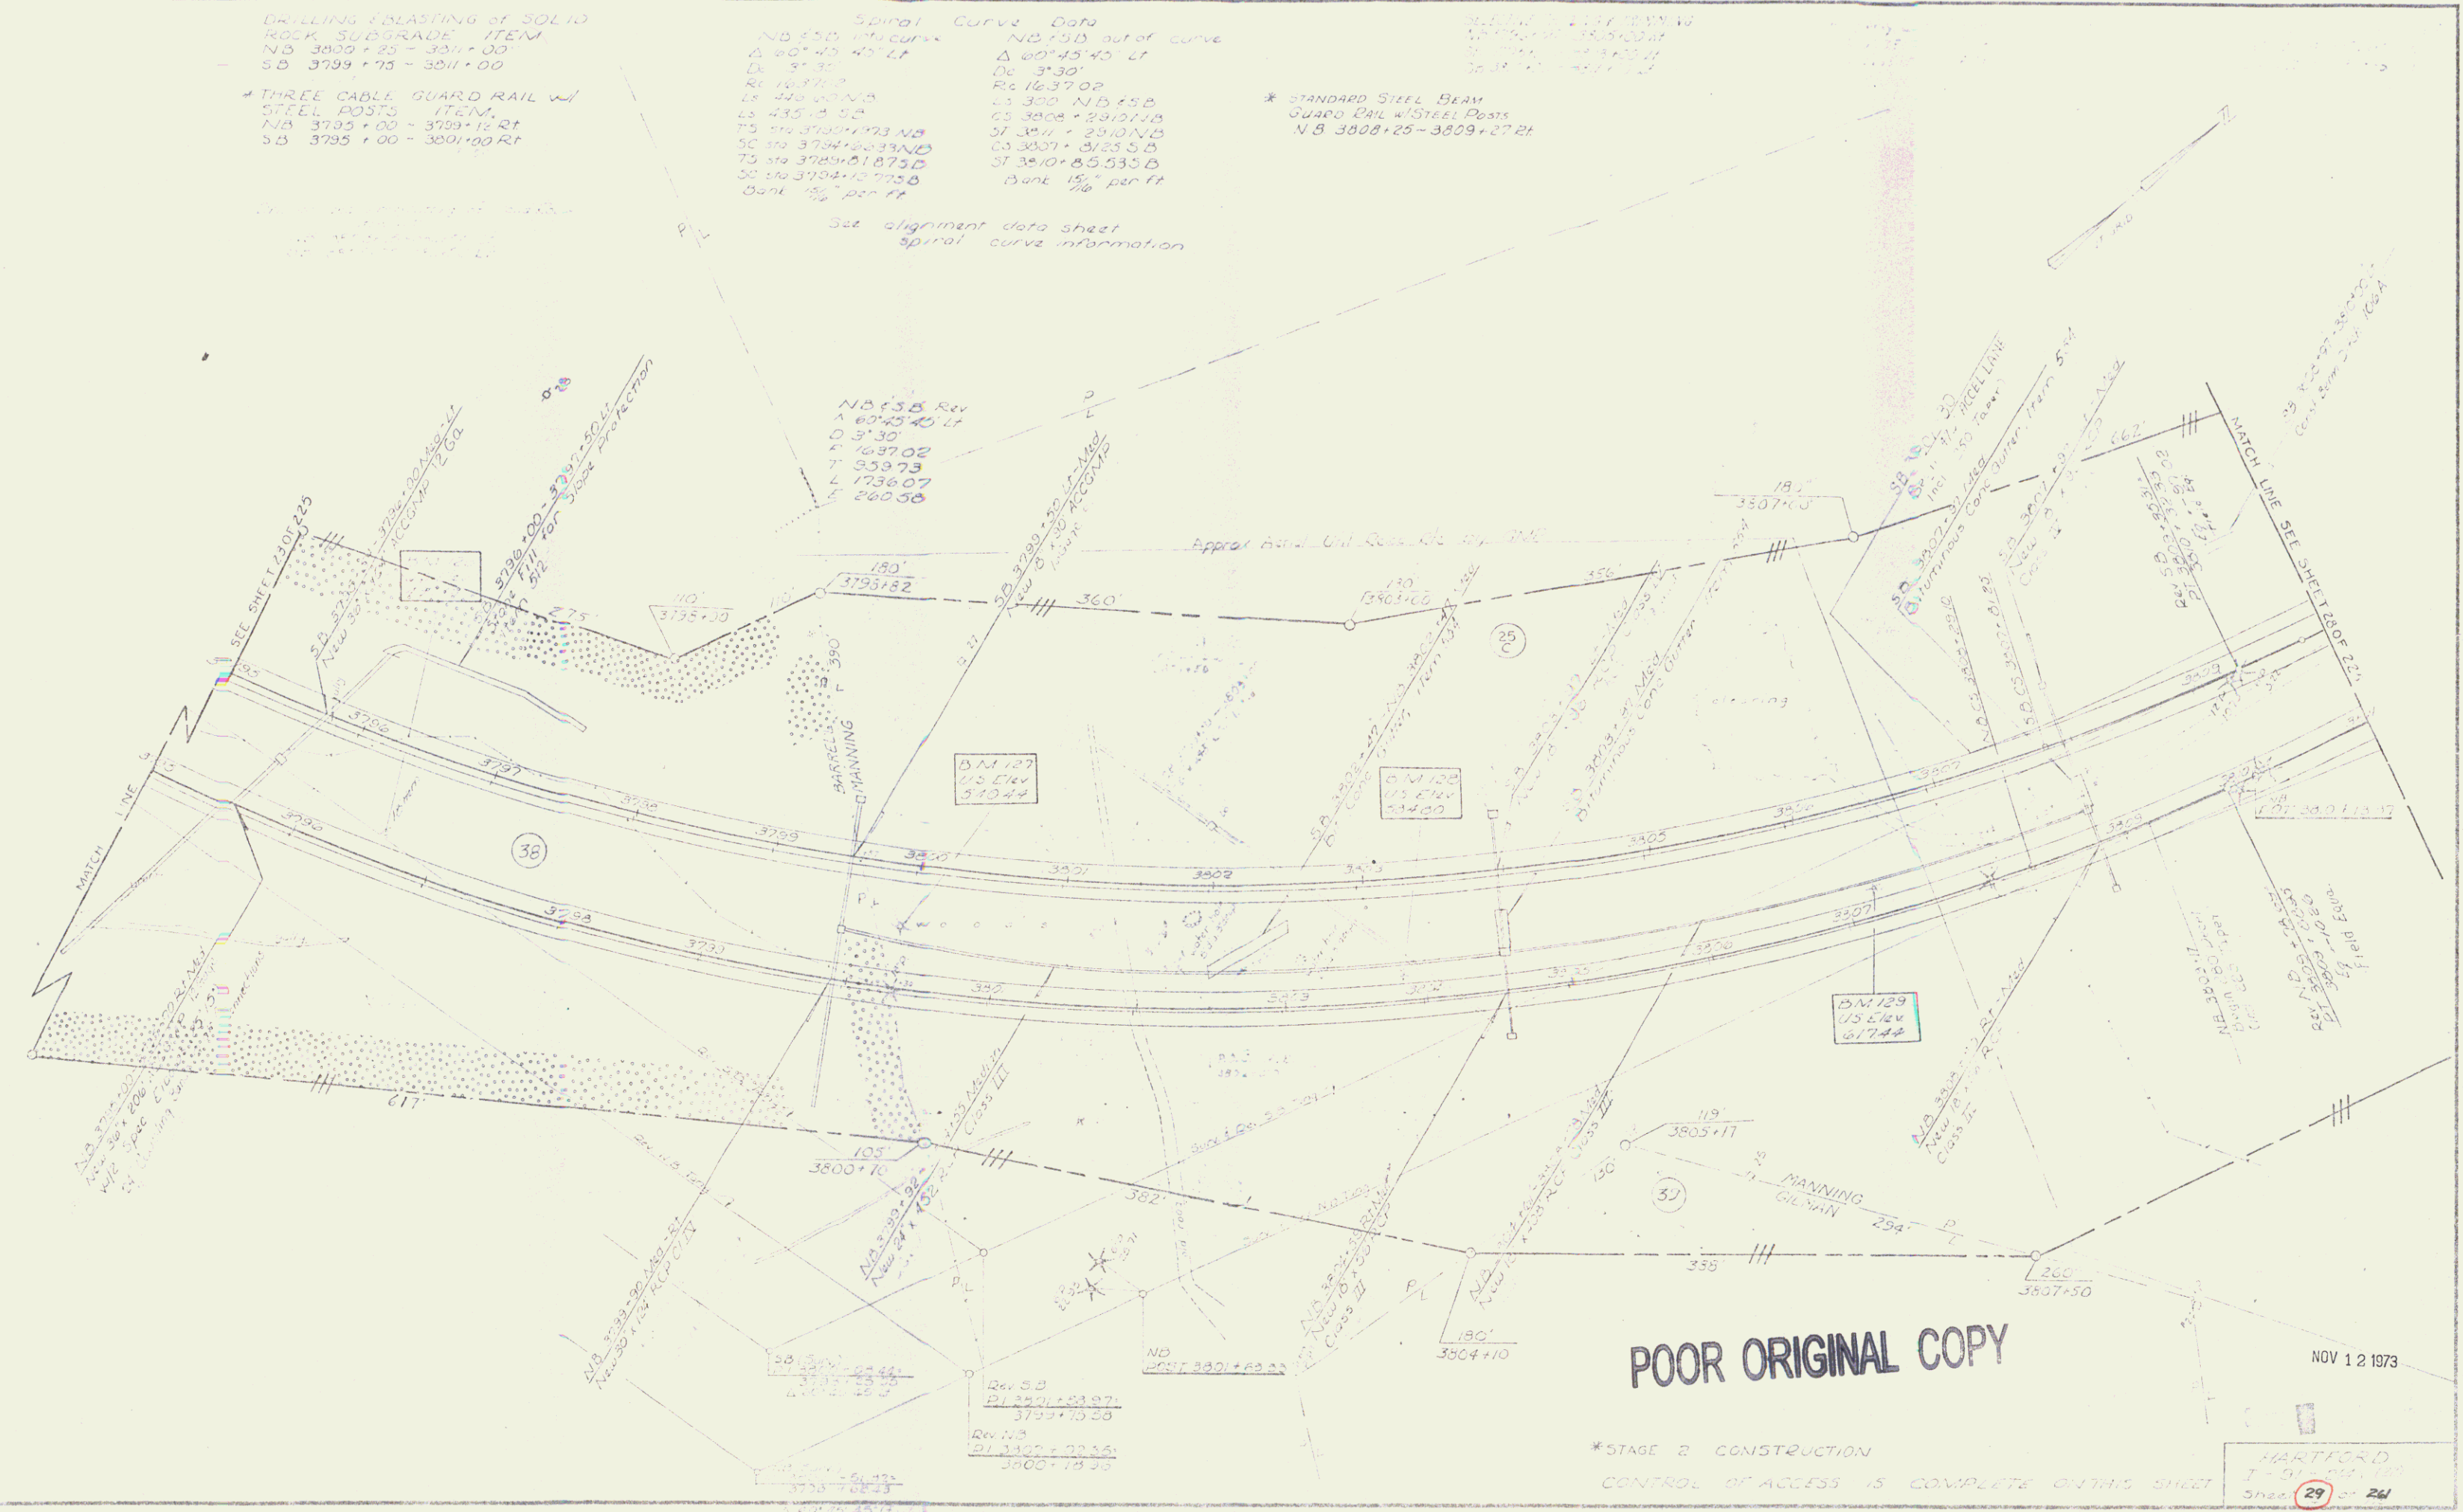

POOR ORIGINAL COPY

NOV 12 1973

*STAGE 2 CONSTRUCTION
CONTROL OF ACCESS IS COMPLETE ON THIS SHEET

HARTFORD
I-91-24-100
Sheet 29 of 24

6