

CAMP A
9+52+13 + 00' RT

PROPERTY LINE FENCE w/
STEEL POSTS
P+3 35+4+00 - 3825 + 00 LI
3+3 36+4+00 - 3825 + 00 LI


CAMP A
2+24 + 3+24 (average)

THREE SABLE GUARD RAIL
w/ STEEL POSTS
Camp A 2+7 + 13+00 RT
NB 3829+61 - 3825+00 RT
NB 3831+42 - 3825+00 RT

DRILLING / BASTING IN GROUND
30" x 30" SQUARE
NB 3817+00 - 3817+25
SB 3811+00 - 3816+75
Camp A 0+100 - 5+00
Camp B 16+00 - 14+00

DRILLING / BASTING IN GROUND
30" x 30" SQUARE
NB 3815+75 RT No 1
NB 3815+75 RT No 2

DRILLING / BASTING IN GROUND
30" x 30" SQUARE
NB 3815+75 RT No 1
NB 3815+75 RT No 2
Camp A 0+100 - 5+00
Camp B 16+00 - 14+00

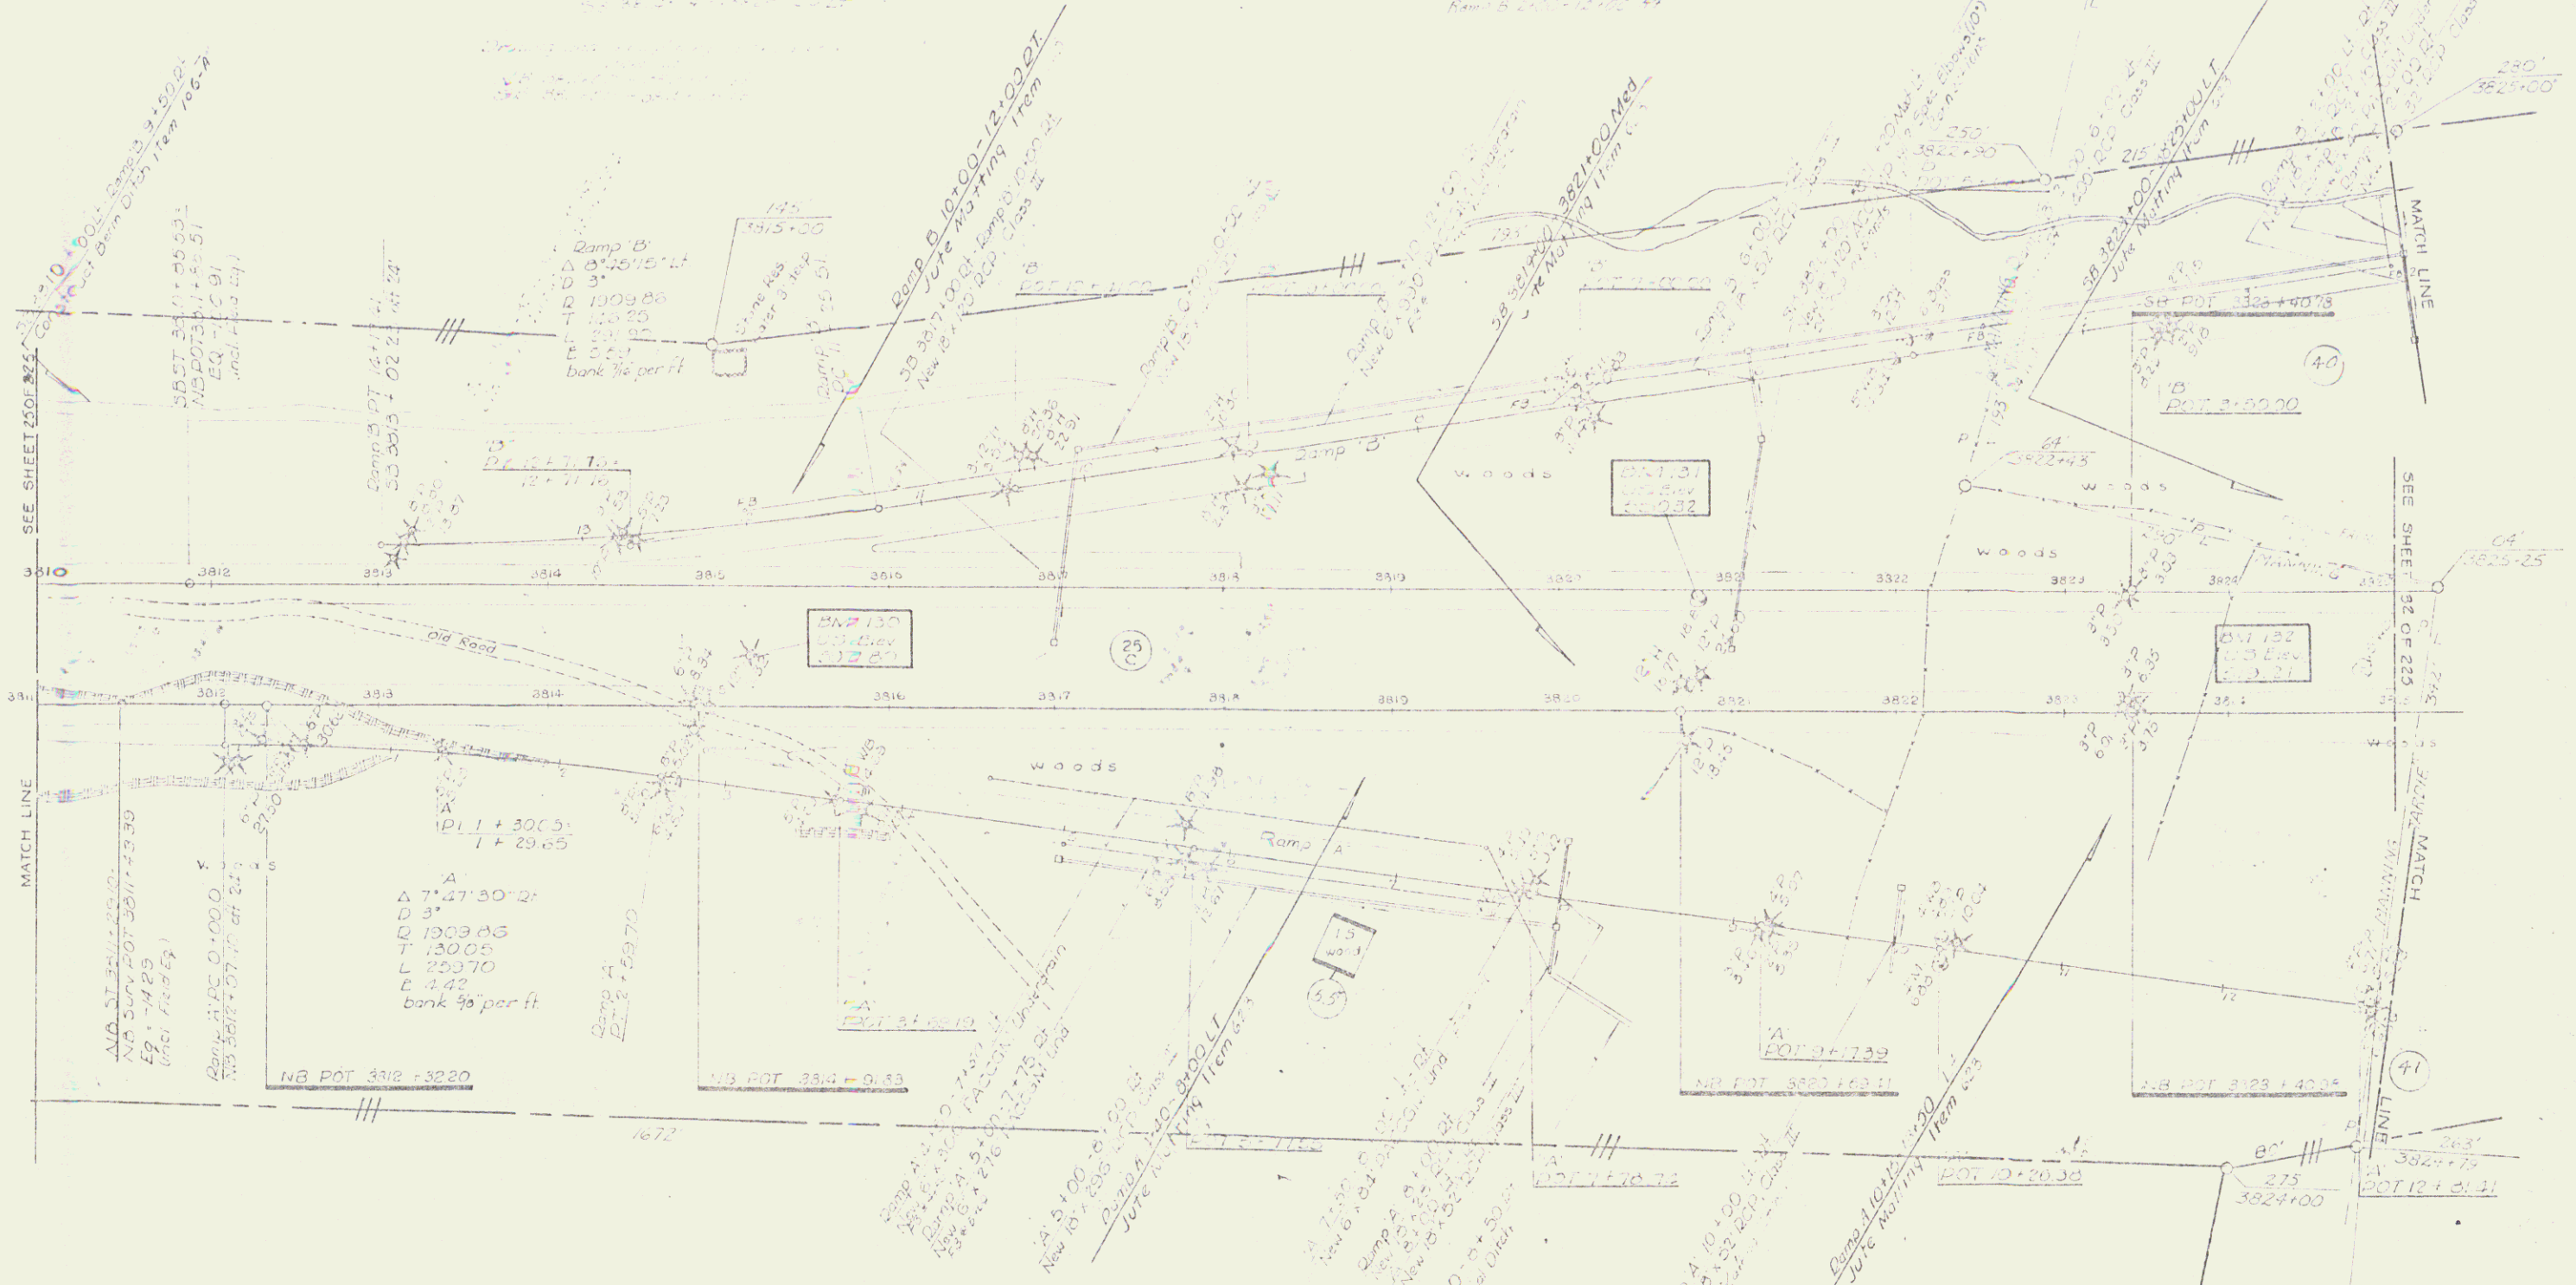

POOR ORIGINAL COPY

NOV 12 1973

*STAGE 2 CONSTRUCTION
CONTROL OF ALL WORK COMPLETE BY THIS SHEET

HAD 1020
Sheet 31 of 26