


See Pin #99R051

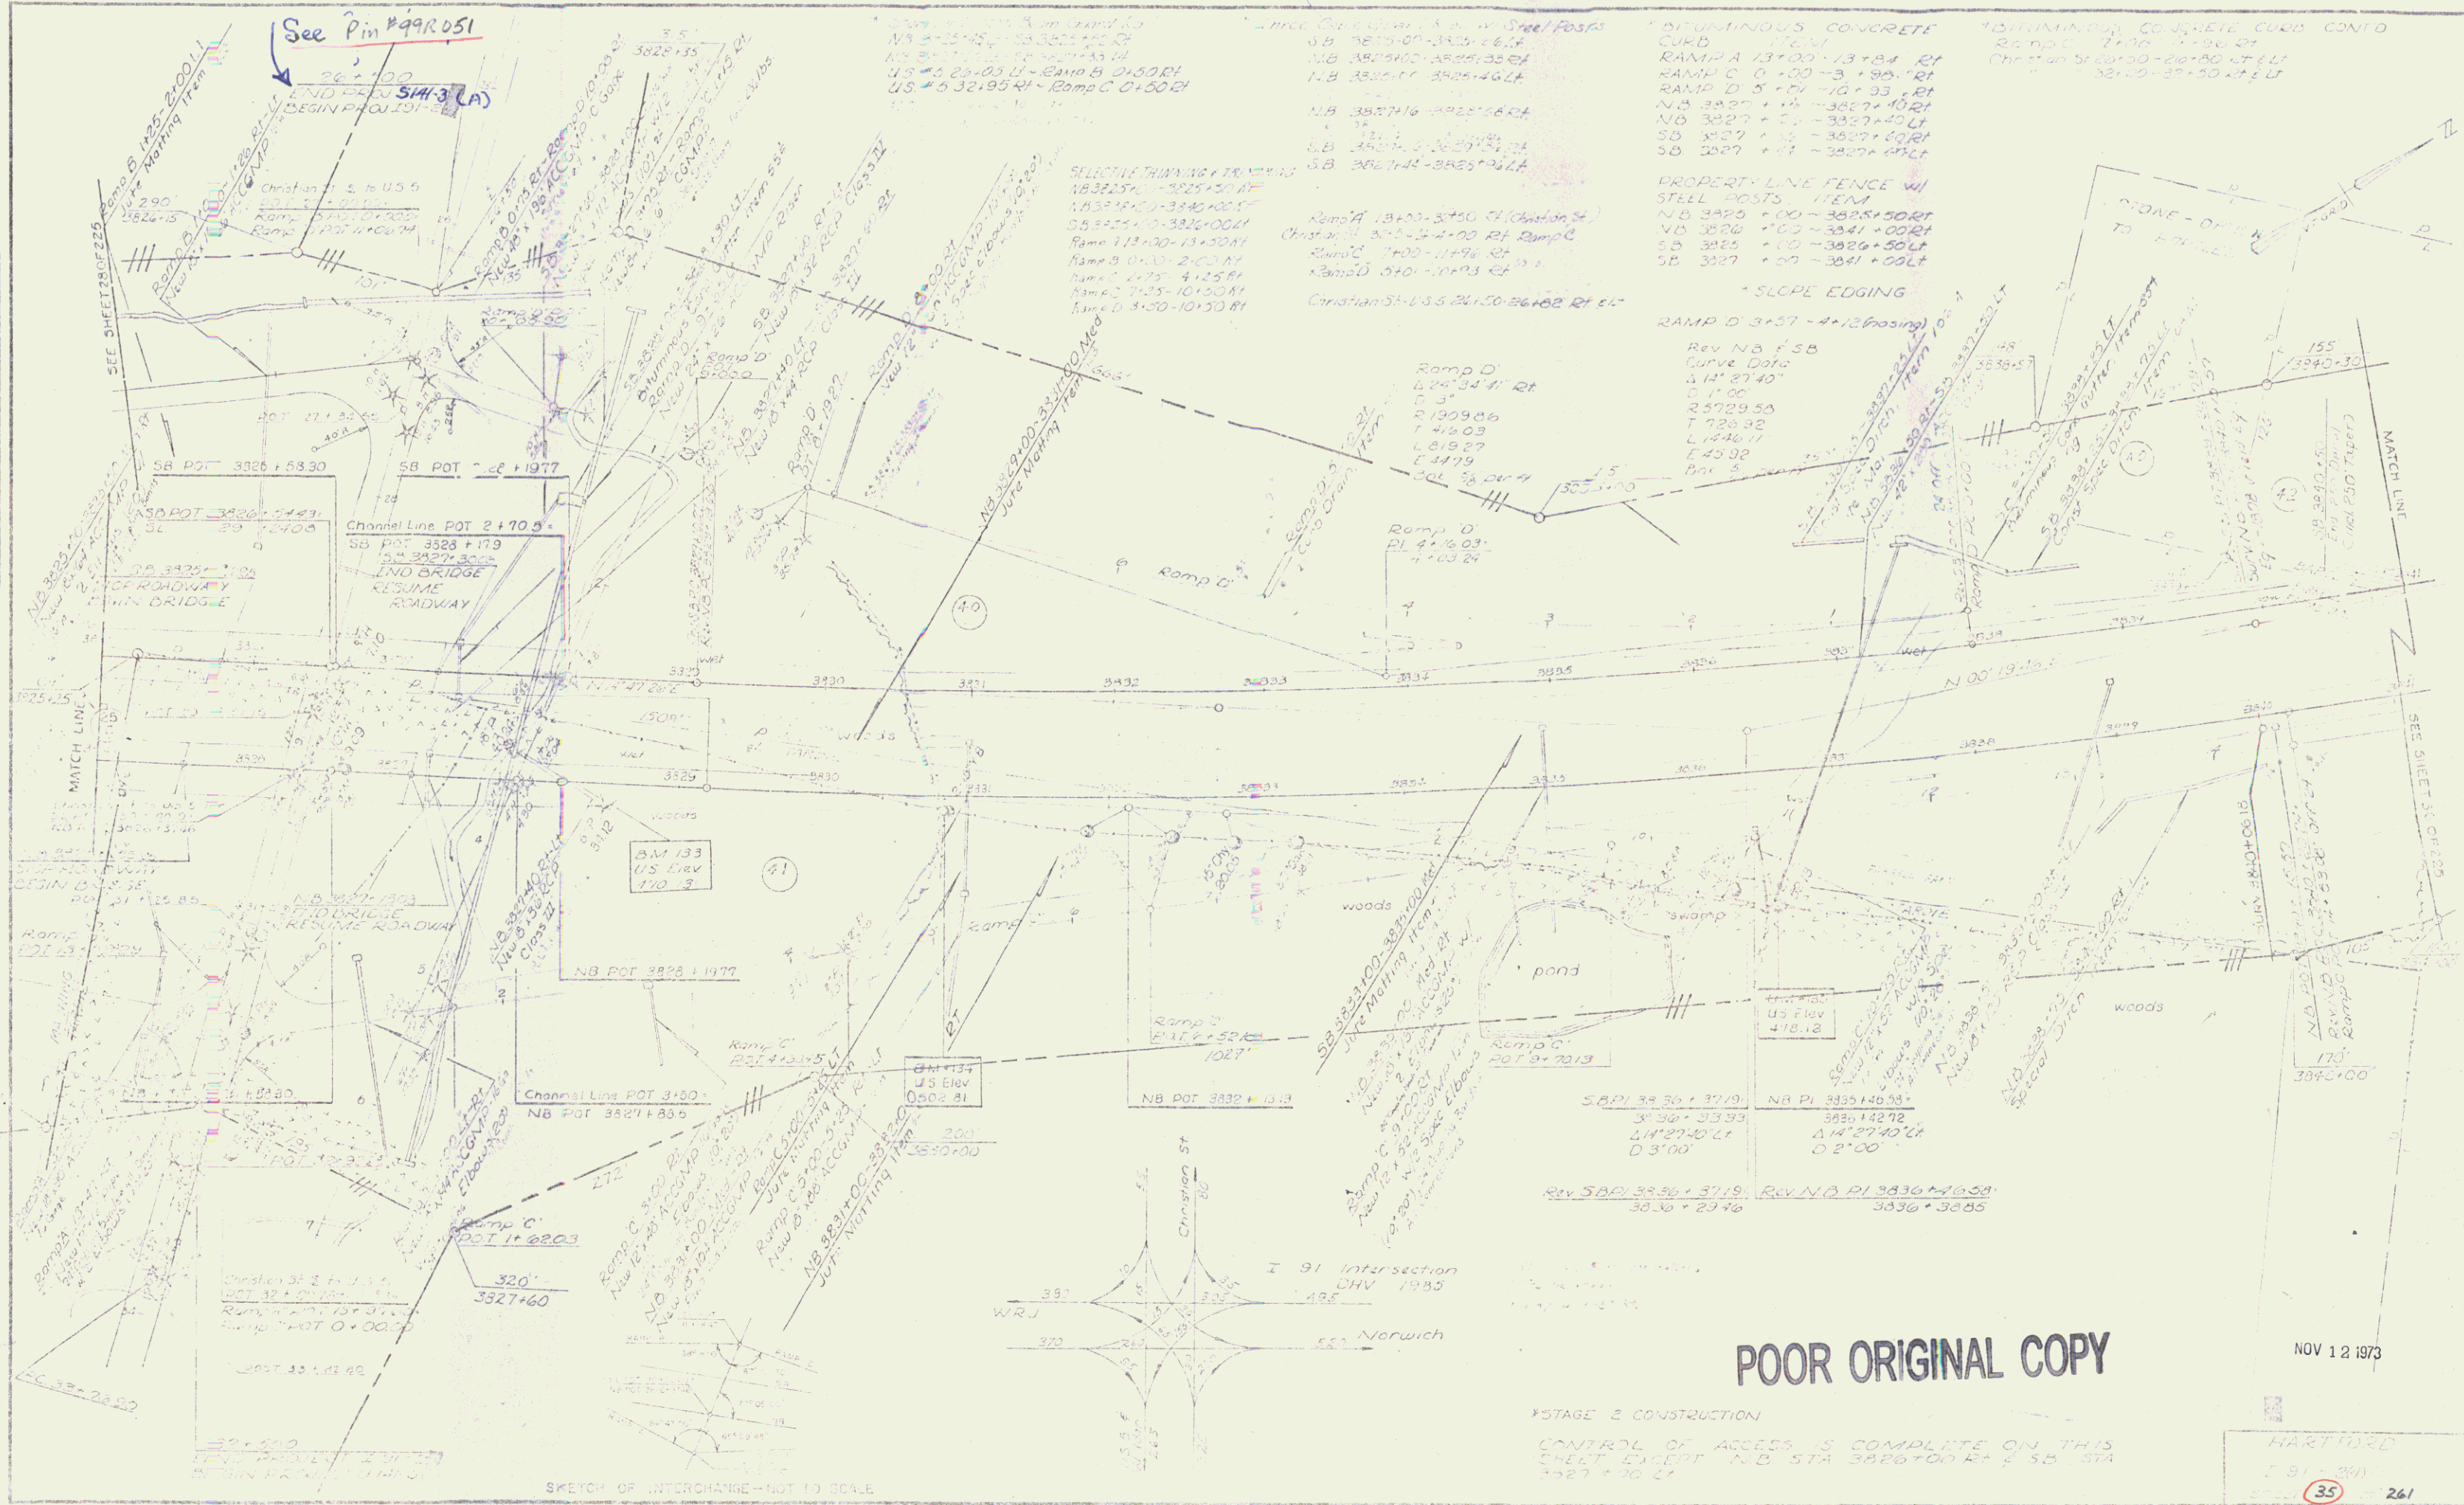

US # 32-95 U - Ramp B 0+50.00  
 NB 3225+00 - 3225+50.00  
 US # 32-95 U - Ramp B 0+50.00  
 US # 32-95 U - Ramp C 0+50.00

US # 32-95 U - Ramp A 0+50.00  
 NB 3225+00 - 3225+50.00  
 US # 32-95 U - Ramp A 0+50.00  
 US # 32-95 U - Ramp C 0+50.00

CONTINUOUS CONCRETE CURB  
 RAMP A 13+00 - 13+84.84  
 RAMP C 0+00 - 3+95.14  
 RAMP D 5+00 - 10+33.84  
 NB 3227+00 - 3227+40.84  
 SB 3227+00 - 3227+40.84  
 SB 3227+00 - 3227+40.84

CONTINUOUS CONCRETE CURB CONT'D  
 RAMP C 7+00 - 13+84.84  
 Channel 5+00+00 - 26+90.84  
 Channel 32+00 - 35+50.84

PROPERTY LINE FENCE W/ STILL POSTS  
 NB 3225+00 - 3225+50.00  
 NB 3225+00 - 3225+50.00  
 SB 3225+00 - 3225+50.00  
 SB 3225+00 - 3225+50.00

RAMP D 3+57 - 4+12 (crossing)


Rev NB F SB  
 Curve Data  
 L 141.2740'  
 D 1.00'  
 E 25729.50  
 T 726.32  
 L 1446.11  
 E 45.92  
 PVI 3.00'

Ramp D  
 L 243.3441'  
 D 3.00'  
 E 1909.86  
 T 414.03  
 L 619.27  
 E 44.79  
 PVI 3.00'

Ramp D  
 PI 4+12.03'  
 4+03.24'

Rev SB PI 3836+16.00  
 3836+29.46

Rev NB PI 3836+16.00  
 3836+38.85

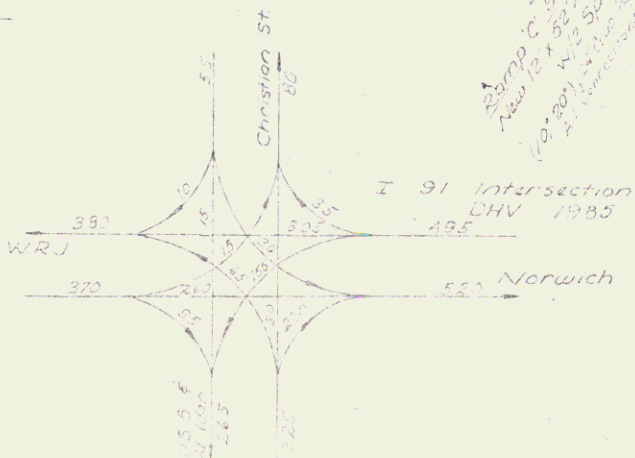

POOR ORIGINAL COPY

NOV 12 1973

STAGE 2 CONSTRUCTION  
 CONTROL OF ACCESS IS COMPLETE ON THIS SHEET EXCEPT NB STA 3826+00 RT & SB STA 3827+00 LT

HARTD  
 I 91 (251)  
 35 261