

DRILLING & BLASTING of SOLID ROCK SUBGRADE, ITEM 114
 5B NB
 2745+00 - 2756+50 2746+50 - 2758+50

PROPERTY LINE FENCE w/ STEEL POSTS, (NOTE 2747+78 NB OF 2759+08 NB OF Property Line Fence to be located inside ROW Line)
 5B NB
 2745+00 - 2756+00 2745+00 - 2747+30 (up) inside ROW Line
 2747+78 - 2756+00

PLANK GUARD RAIL w/ PRESERVATIVE TREATMENT, ITEM 540
 2747+54 - 2747+78 NB RT

STAGE 2 CONSTRUCTION
 STANDARD STEEL BEAM GUARD RAIL w/ STEEL POSTS
 2744+00 - 2745+39 SB Lt.


UNDER DRAIN
 SB 2748+90 - 2749+30 2' 2"
 SB 2753+00 - 2753+30 2' 2"
 NB 2747+53 - 2749+30 2' 2"
 NB 2749+33 - 2751+36 4' 4"
 NB 2751+30 - 2754+19 4' 4"
 NB 2753+00 - 2753+30 2' 2"
 NB 2753+03 - 2753+75 RT
 SB 2749+30 - 2750+12 4'

DEMOLITION & REMOVAL OF BUILDINGS ITEM 586
 2749+60 OF (Shed & Milk Ho.)
 2749+90 OF
 2750+40 OF


PARCEL 258 A-3 STA 2731+95 ML - 2741+30 SB GRANTOR ORVILLE A & NAOMA H. ENGLEE
 TAKING NONE REM-21-94
 RIGHTS: DRAINAGE STA 2730+25 RT NL 2734+00 RT ML - 2736+50 RT NB 2750+00 RT NB
 SPRING STA 2748+50 LT NL
 TITLE TAKEN COND. O. 1-6-64
 RECORDED WEATHERFIELD 84-40 PG. 85 DT. 1-9-64

NOTE: 2747+00 - 2760+00
 Details of Sleeves and Water Pipes are shown on Sheet 21 of 180

PLAN	DATE	BY
2745+00	11/13/55	J. H. HARRIS
2745+00	11/13/55	J. H. HARRIS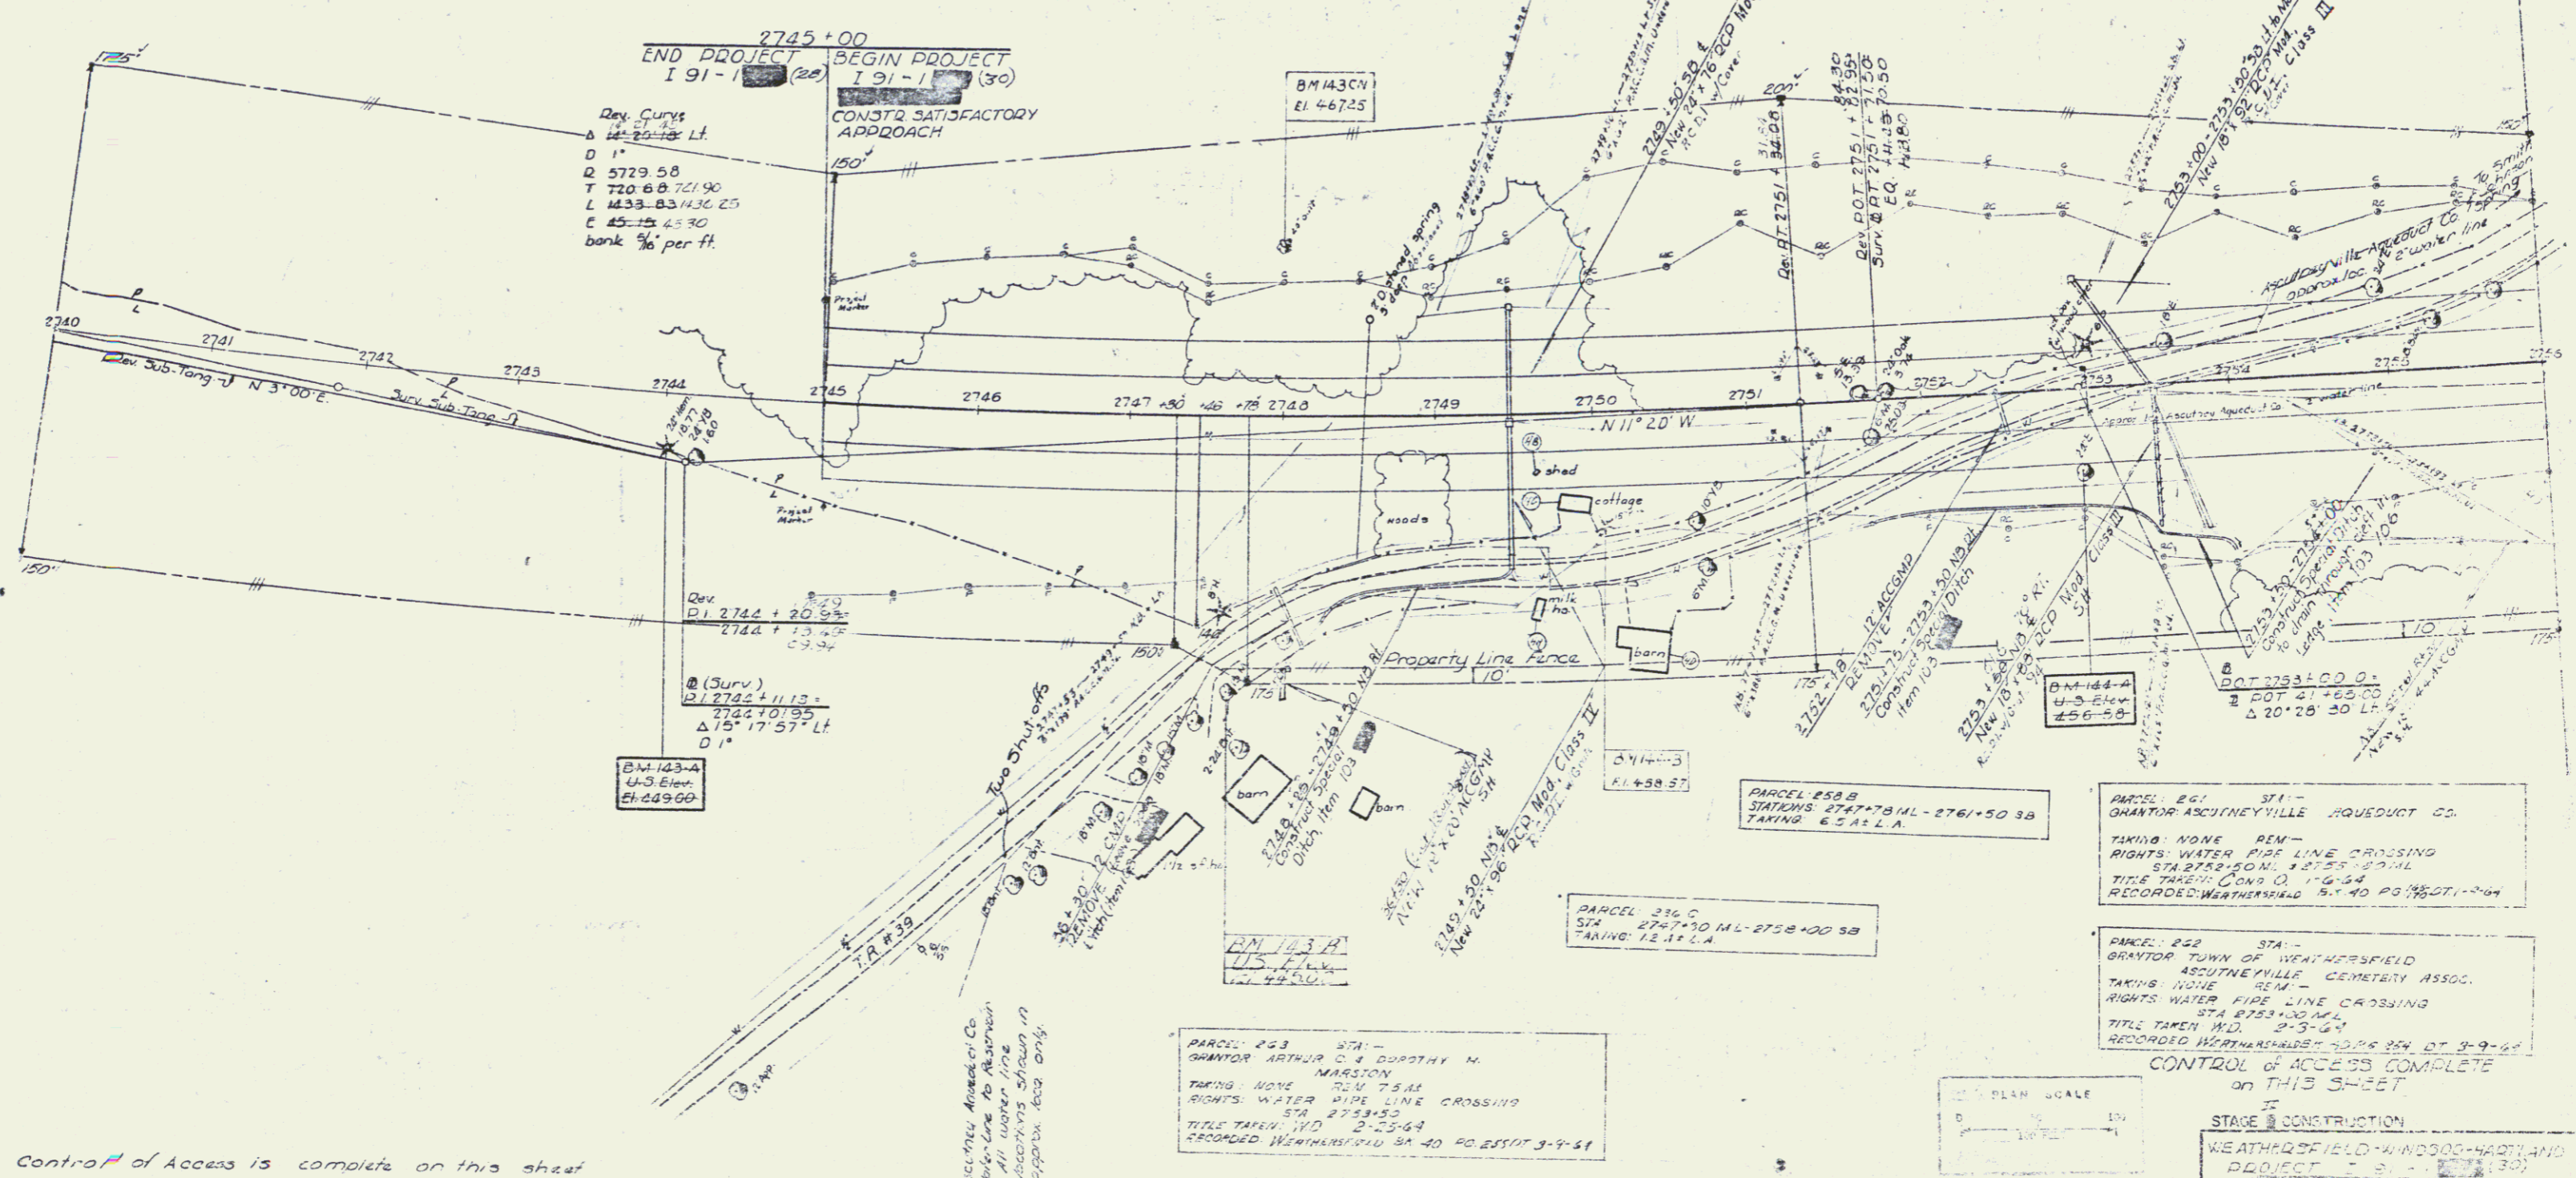
Control of Access is complete on this sheet

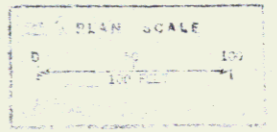

PARCEL 251 STA - GRANTOR ASCUTNEYVILLE AQUEDUCT CO. TAKING NONE REM- TAKING NONE REM- STA 2752+50 ML - 2755+00 NL TITLE TAKEN COND. O. 1-6-64 RECORDED WEATHERFIELD 84-40 PG. 85 DT. 1-9-64

PARCEL 252 STA - GRANTOR TOWN OF WEATHERFIELD ASCUTNEYVILLE CEMETERY ASSOC. TAKING NONE REM- STA 2753+00 ML TITLE TAKEN COND. O. 2-5-64 RECORDED WEATHERFIELD 84-40 PG. 85 DT. 2-9-64 CONTROL OF ACCESS COMPLETE ON THIS SHEET

STAGE 2 CONSTRUCTION
 WEATHERFIELD WINDSOR-HARDY AND PROJECT - 5 - 11/13/55
 Sheet 22 of 180