

Construct
 Standard Steel Beam Guard
 Rail w/ Steel Posts
 2764+50 - 2766+50 NB Rt.
 2766+50 - 2767+50 NB Rt.
 2767+50 - 2768+50 NB Rt.
 2768+50 - 2769+50 NB Rt.

SODDING, ITEM 612
 NB Rt.
 2760+30 - 2762+10
 2768+70 - 2770+75

JUTE MATTING, ITEM 623
 SB Rt.
 2765+25 - 2773+25

*THREE CABLE GUARD RAIL w/ STEEL POSTS
 ITEM 542
 NB Rt.
 2759+50 - 2763+00
 2760+00 - 2765+00


DRILLING & BLASTING of SOLID ROCK
 SUBGRADE, ITEM 114
 NB
 2764+00 - 2768+00
 2770+00 - 2772+00

*BITUMINOUS CONCRETE CURB
 ITEM 555
 NB Rt.
 2759+50 - 2761+00
 2760+00 - 2765+00

*BITUMINOUS CONCRETE SURFACE
 FOR GUTTERS AND TRAFFIC ISLANDS
 ITEM 554
 NB Rt.
 2770+75 - 2771+75

*STANDARD STEEL BEAM GUARD
 RAIL w/ STEEL POSTS, ITEM 545-A
 2766+00 NB RT - 2767+00 NB RT
 2766+00 SB LT - 2767+00 SB LT

PLAN
 SHEET NO.
 DATE
 BY
 CHECKED
 APPROVED

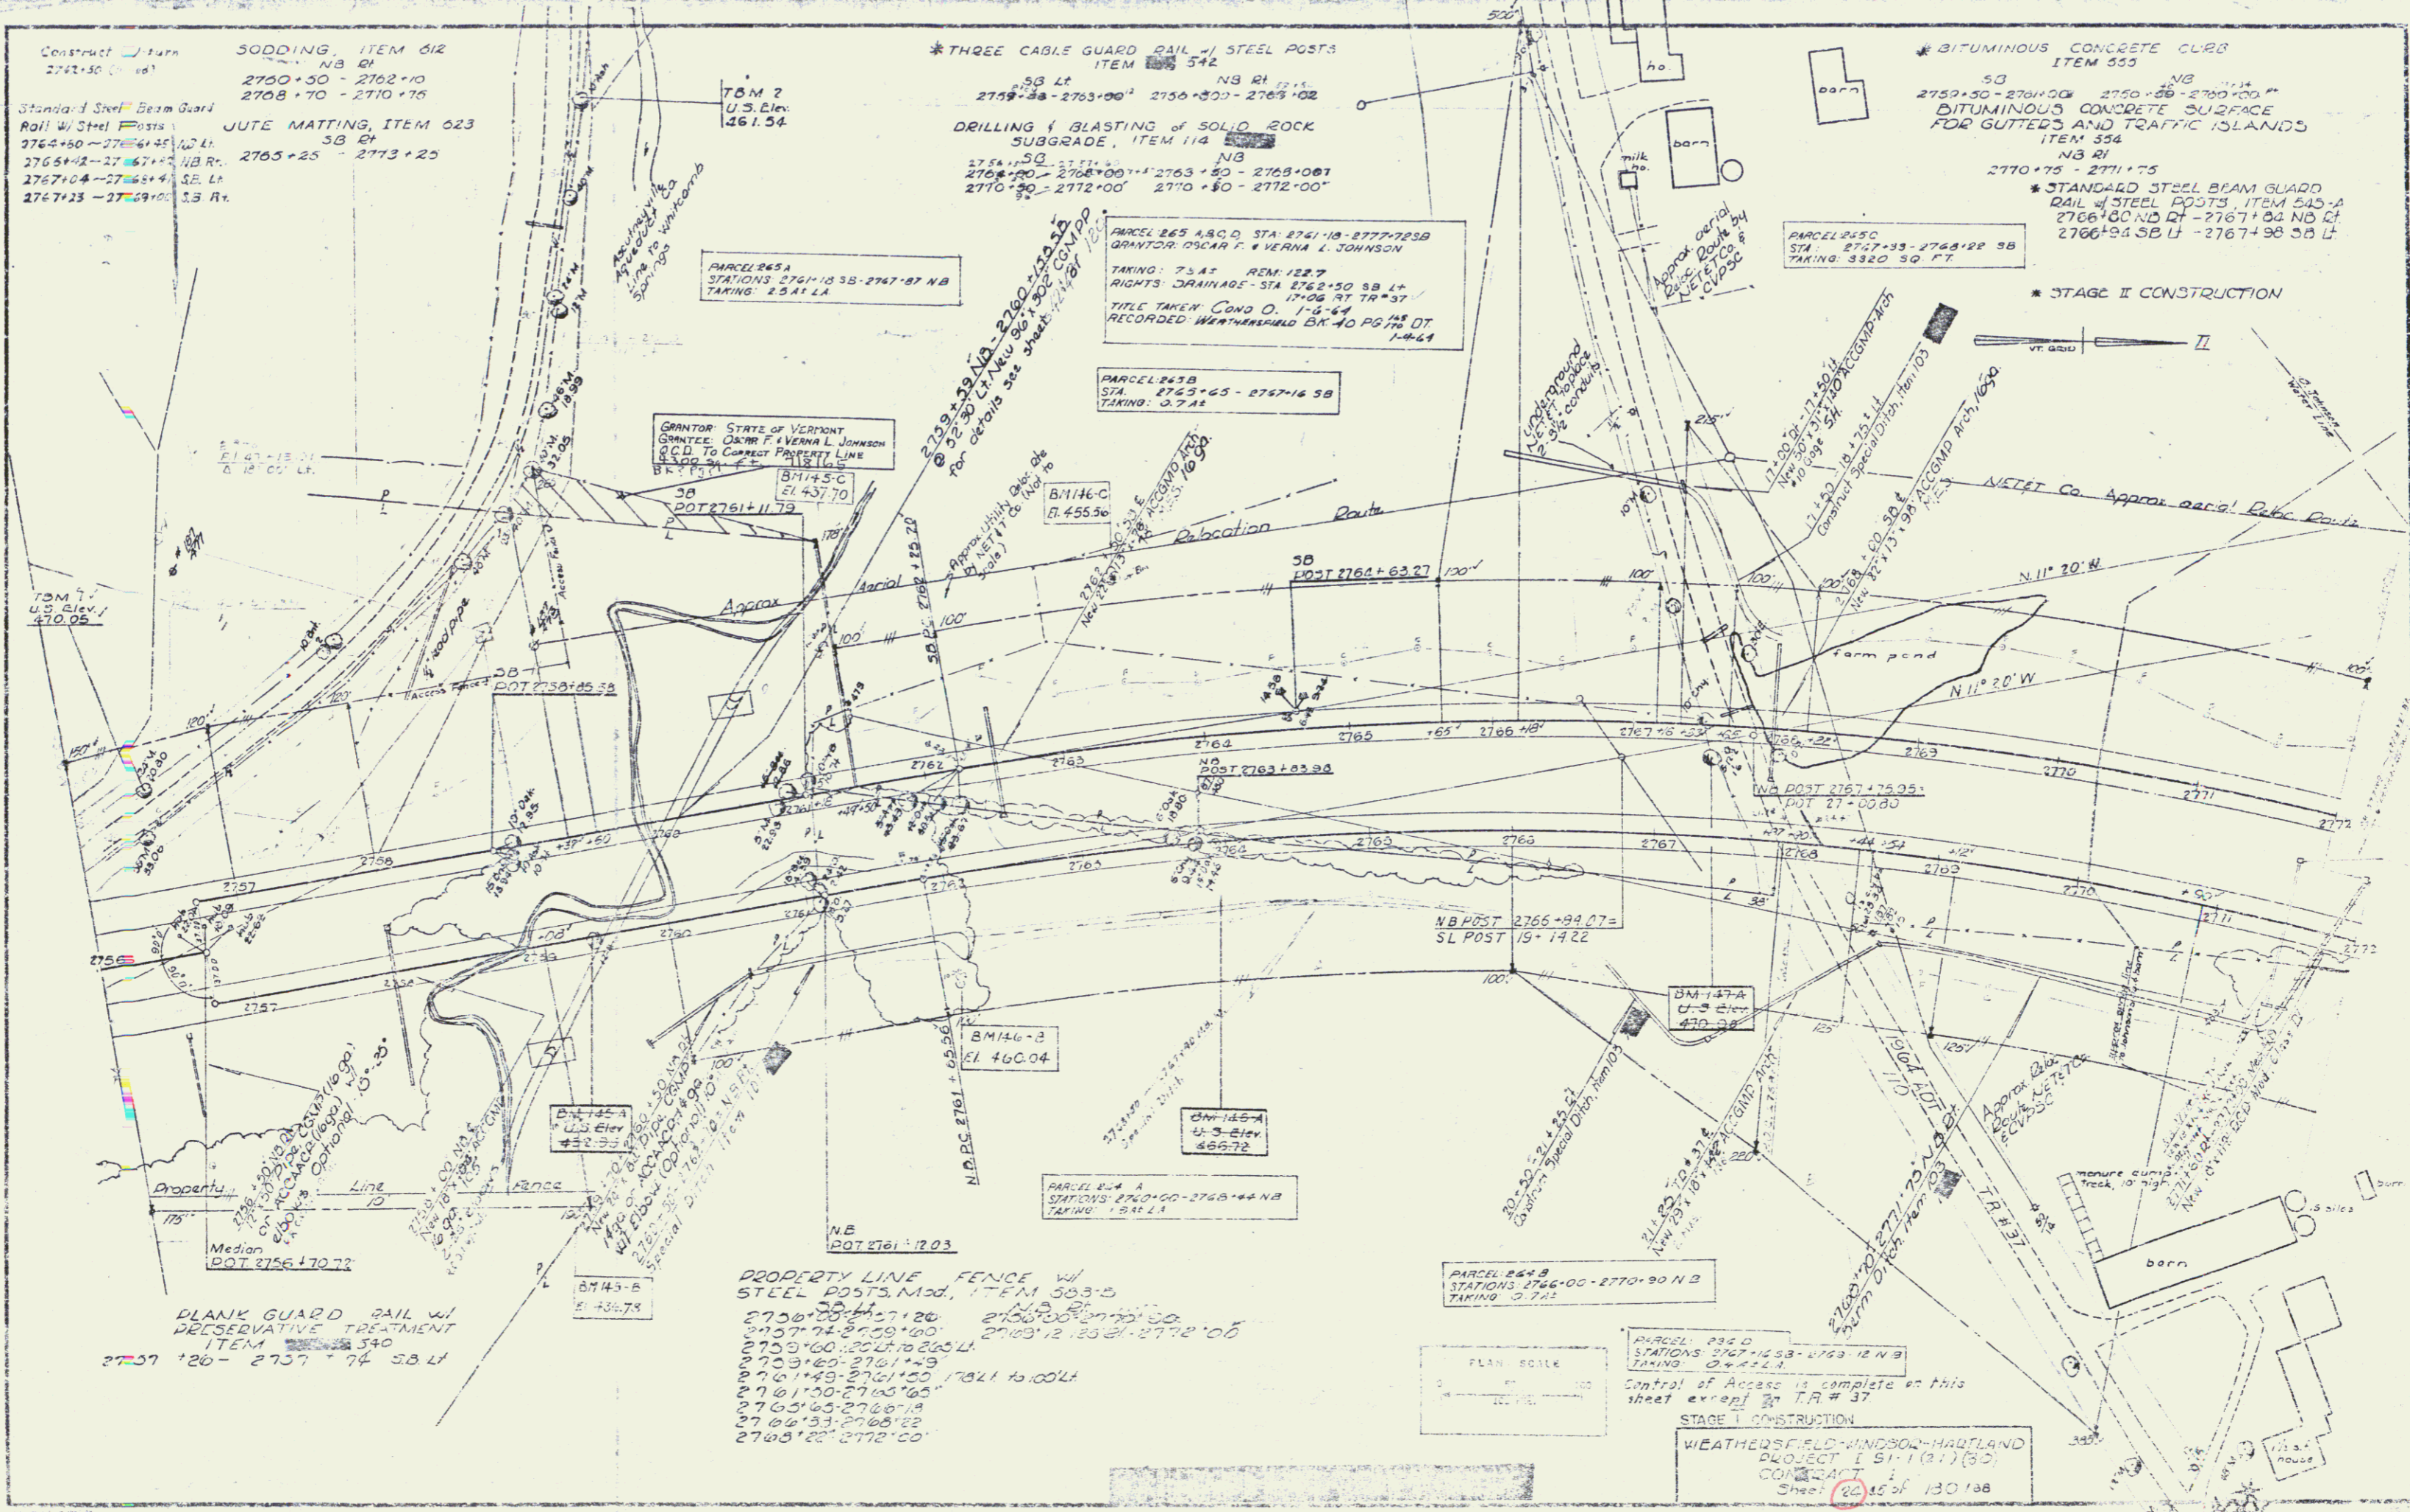

PROPERTY LINE FENCE w/
 STEEL POSTS, Mod., ITEM 503-B
 NB Rt.
 2757+00 - 2757+20
 2757+20 - 2757+40
 2757+40 - 2757+60
 2757+60 - 2757+80
 2757+80 - 2758+00
 2758+00 - 2758+20
 2758+20 - 2758+40
 2758+40 - 2758+60
 2758+60 - 2758+80
 2758+80 - 2759+00

PLANK GUARD RAIL w/
 PRESERVATIVE TREATMENT
 ITEM 540
 NB Rt.
 2757+20 - 2757+74 SB LT

PARCEL #65D
 STATIONS 2767+00 - 2768+12 NB
 TAKING 0.422 LA
 Control of Access is complete on this
 sheet except for T.R. # 37

STAGE I CONSTRUCTION
 WEATHERSFIELD-WINDSOR-HARTLAND
 PROJECT I 51-1(21)(B)
 CONTRACT 1
 Sheet 60 of 130 138