

DRILLING & BLASTING of SOLID ROCK  
SUBGRADE, ITEM 114  
2804+00 - 2818+00 SB  
2812+00 - 2814+00 NB  
PROPERTY LINE FENCE w/ STEEL  
POSTS, MOD. ITEM 503-D  
2808+00 - 2808+30 NB-ET  
2802+00 - 2802+96 NB-ET  
2803+41 - 2817+00 NB-ET

STONE FILL FOR SLOPE PROTECTION  
ITEM 522  
2815+50 - 2816+55 NB-ET

RIP-RAP FOR BANK PROTECTION  
MOD. FOR CULV ENDS, ITEM 520  
2816+55 - 2816+75 NB-ET


THREE CABLE GUARD RAIL w/ STEEL  
POSTS, ITEM 542  
NB  
2815+50 - 2816+00 NB-ET  
2816+50 - 2816+90 NB-ET  
\* STAGE II CONSTRUCTION

ENTRANCE CONCRETE CURB  
2815+20 - 2817+00 NB-ET


PARCEL: 247 STA 2734+90 NB - 2810+63 SB  
GRANTOR: HOWARD C. & WIFE EDITH MCDONALD  
TAKING: 24.1 A.E. L.A. DEM. 43.9 AC  
RIGHTS: DEWING - STA 2801+00 SB L.S. 2796+50 NB-ET  
2798+00 NB-ET, 2805+00 NB-ET  
LOSS of ACC. 253 - STA 2797+40 - 2813+63 S.B. ET (49.0 AC)  
SPRING - STA 2801+15 SB-ET  
TITLE TAKEN: W.D. 2-30-63  
RECORDED WEATHERSFIELD BK 40 Pg 176 DT 1-9-64

POOR ORIGINAL COPY

PLAN	2815+00 - 2816+00 NB-ET
SECTION	2815+00 - 2816+00 NB-ET
DATE	1-9-64
BY	W.D. WEATHERSFIELD
CHECKED	W.D. WEATHERSFIELD
NO.	100

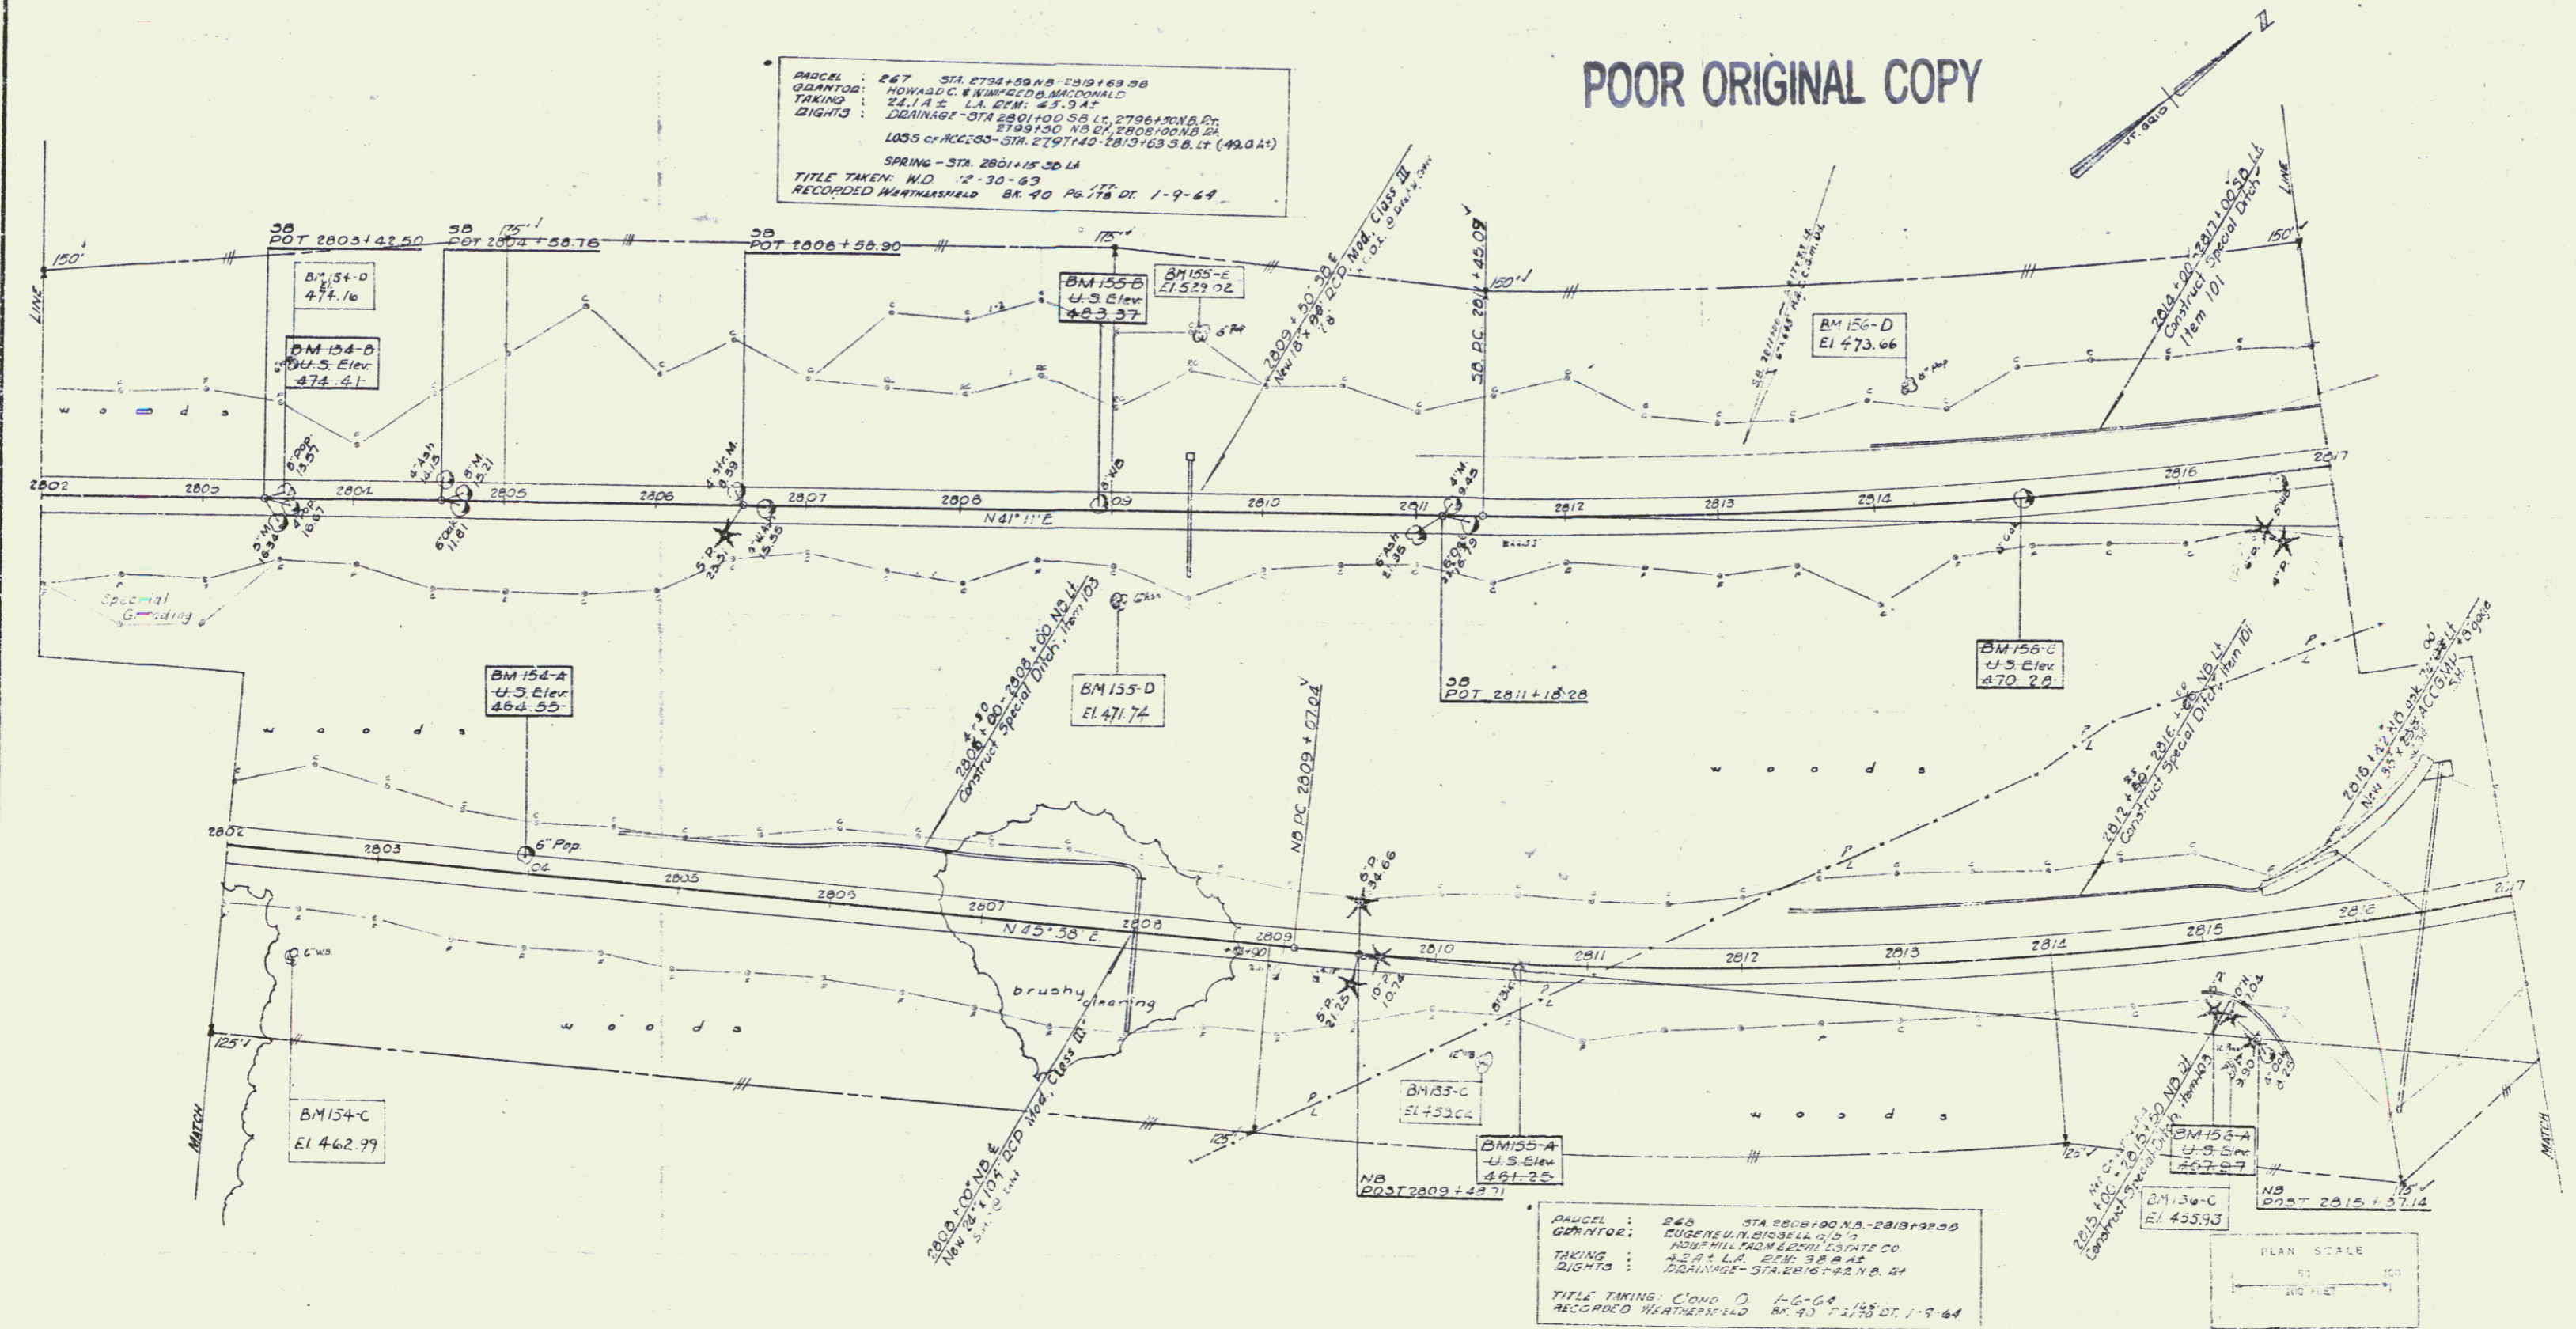

PARCEL: 245 STA 2808+00 NB - 2818+25 SB  
GRANTOR: EUGENE W. & WIFE BESSIE W. WOOD  
TAKING: 4.2 A.E. L.A. DEM. 38.8 AC  
RIGHTS: DEWING - STA 2816+75 NB-ET  
TITLE TAKING: COND. D 7-6-64  
RECORDED WEATHERSFIELD BK 40 Pg 175 DT 1-9-64

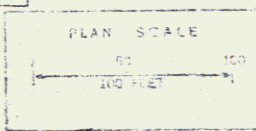

Control of Access is complete on this sheet

STAGE II CONSTRUCTION  
WEATHERSFIELD-KINDSQR-HARTLAND  
PROJECT 181-150(50)  
CONTRACT 1  
Sheet (30) of 100  
sheet 50 of 100