



PLAN SUBMITTED BY: [unclear]
 DATE: [unclear]
 AUTHORITY: [unclear]
 NO. OF SHEETS: [unclear]

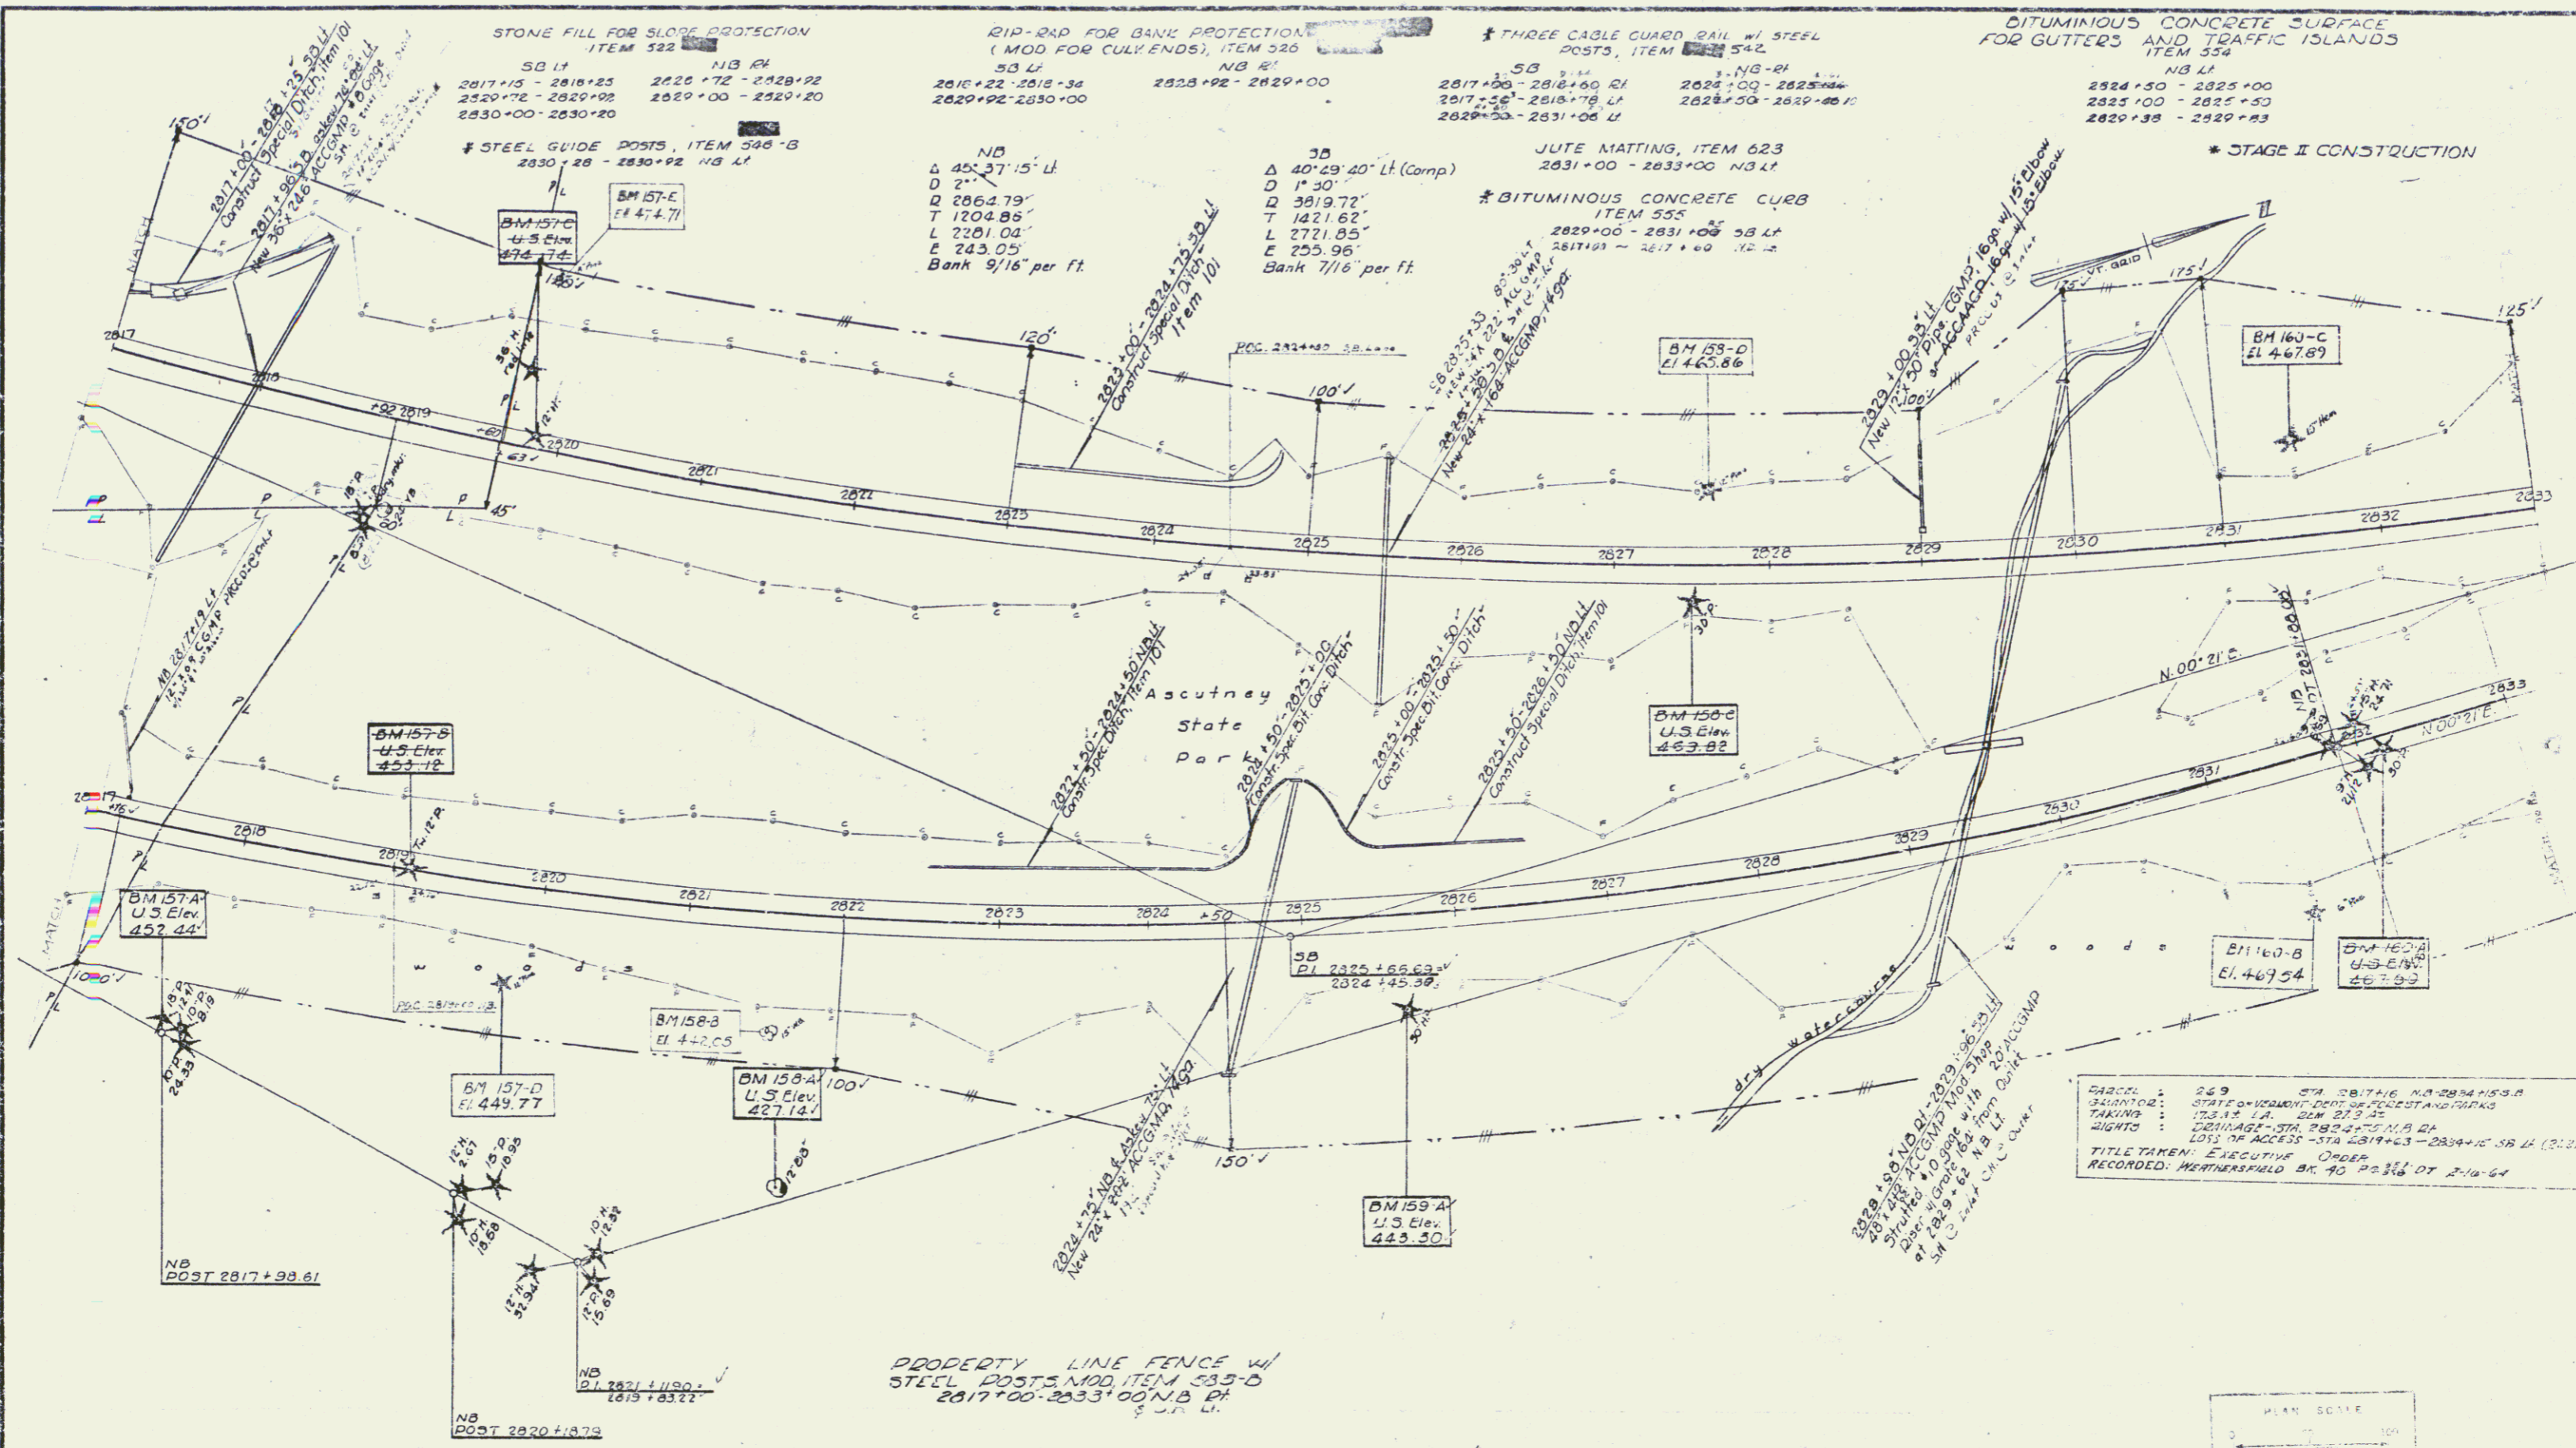

DATE: 2-29-64
 DRAWN BY: [unclear]
 CHECKED BY: [unclear]
 TITLE TAKEN: EXECUTIVE ORDER
 RECORDED: MEMPHISFIELD BK 40 PG 24 OF 2-16-64

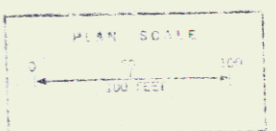

STAGE II CONSTRUCTION
 WEATHERSFIELD WINDSOR-HARTLAND
 PROJECT I-SI-100A(30)
 CONTRACT I
 SHEET (32) OF 180

Control of Access is Complete on this sheet.

Sheet 32 of 180