
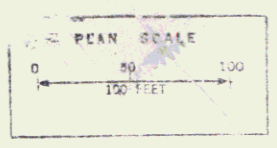


Sheet - Drawn 7-80
12-80
KUC
1-81
TRAVERSE

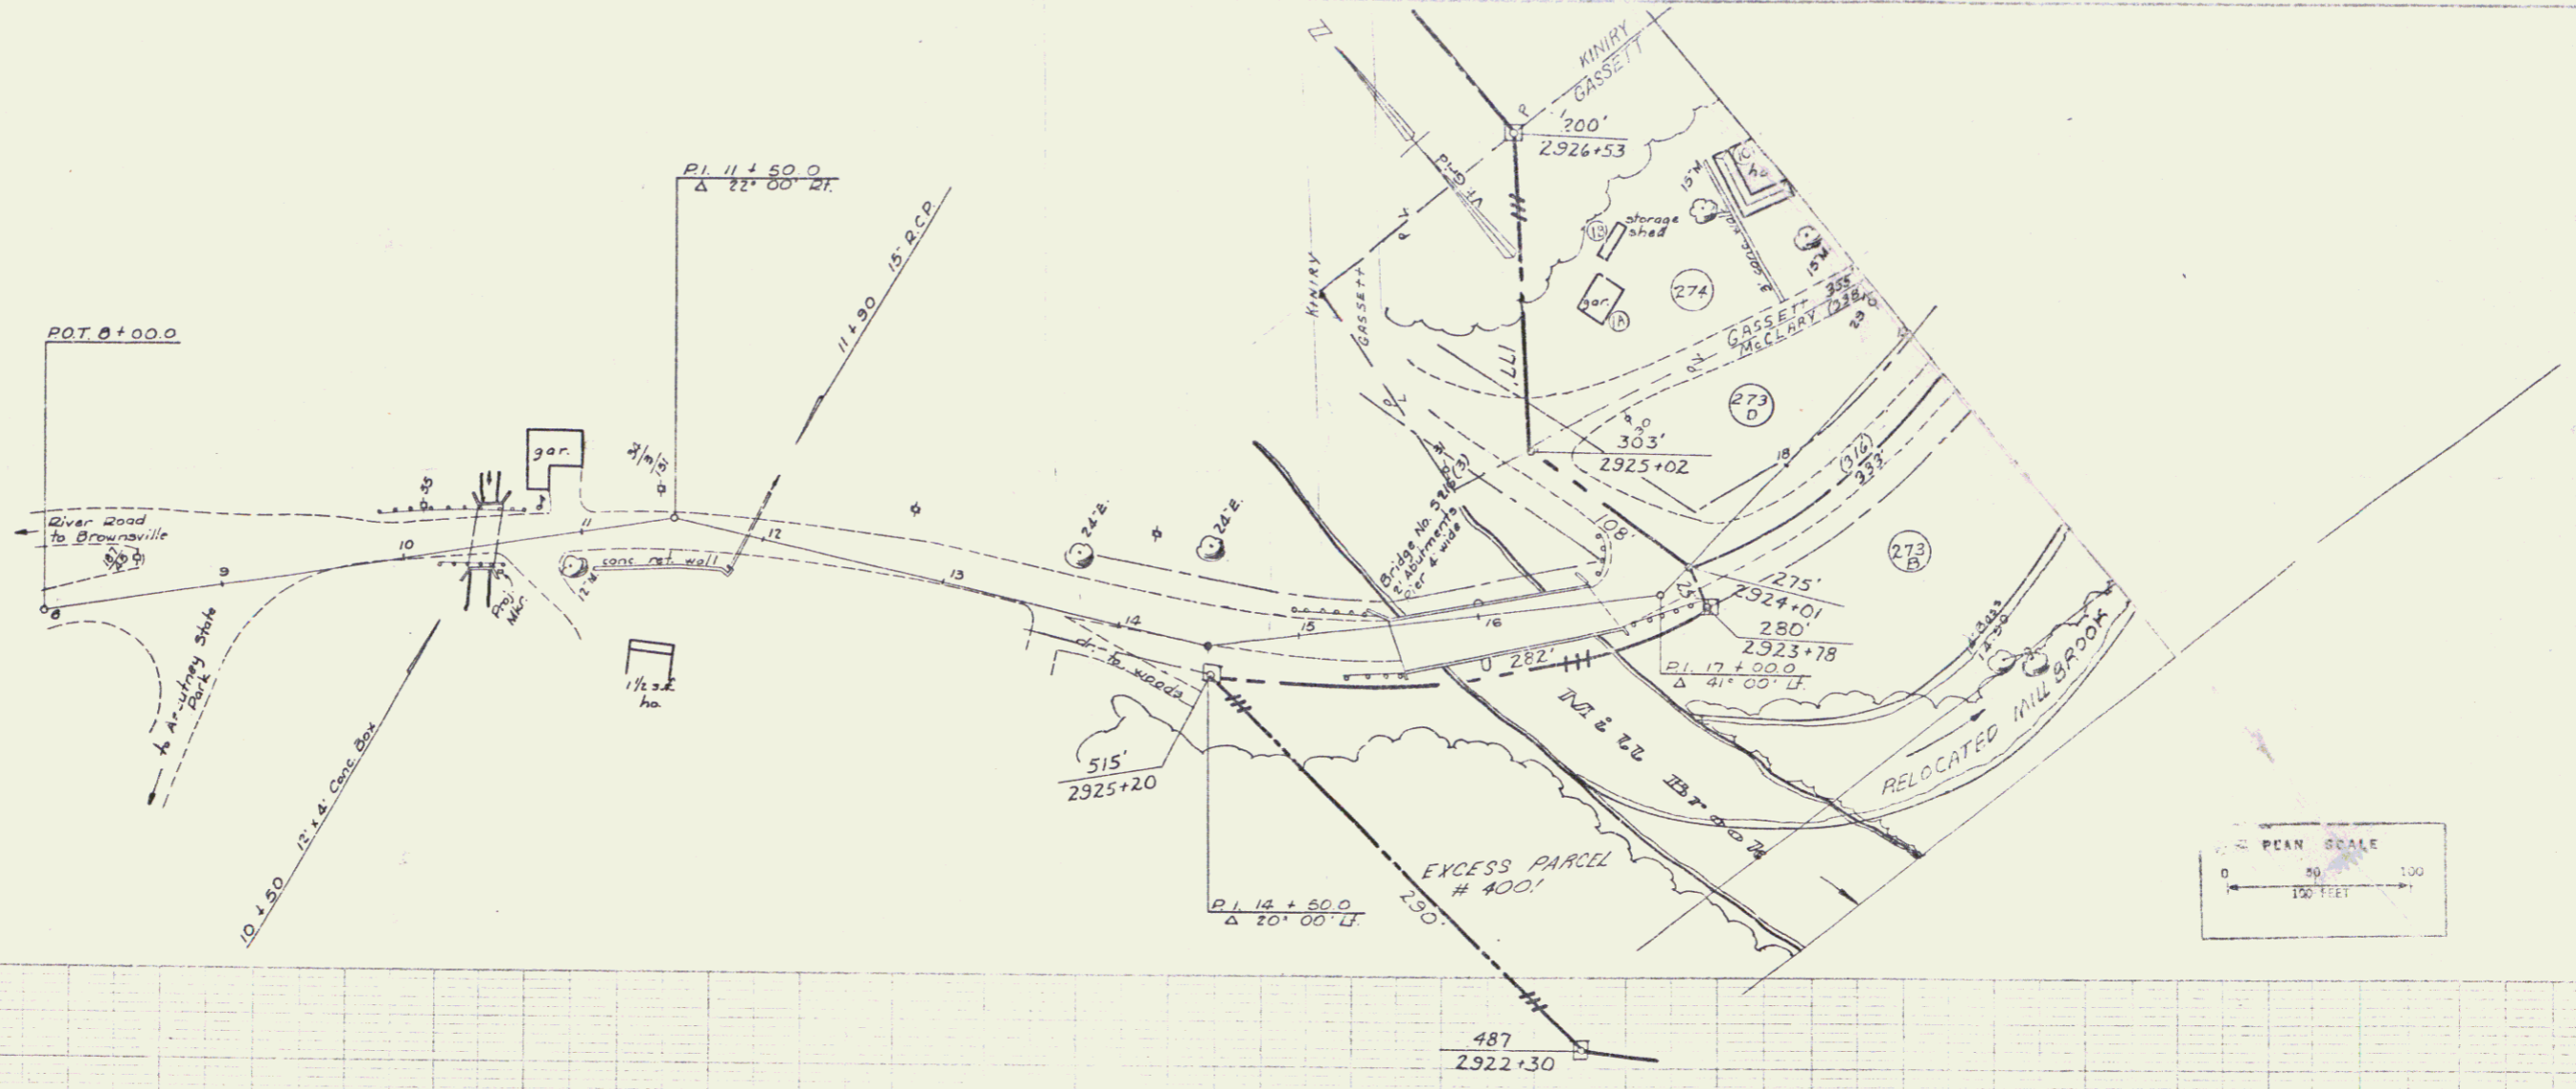

VT. ROUTE 44

STAGE 1 CONSTRUCTION
WEATHERSFIELD-WINDSOR-HARTLAND
PROJECT 1 91-1(21)
CONTRACT 2
Sheet 34 of 168
TRAVERSE - VT. Rte 44 @ Sta. Line 2322+45.70

21