



DRILLING & BLASTING of SOLID ROCK
 SUBGRADE, ITEM 114
 2937+00 - 2952+00 NB.V
 2937+00 - 2952+00 SB.V
 2937+00 - 2947+00 NB.
 2938+00 - 2947+00 NB.

THREE CABLE GUARD RAILS WITH STEEL
 POSTS, ITEM 115
 2937+00 - 2952+00 NB.V
 2937+00 - 2952+00 SB.V
 2937+00 - 2947+00 NB.
 2938+00 - 2947+00 NB.

PROPERTY LINE PER
 W/ STEEL POSTS
 2937+00 - 2952+00 SB.V
 2937+00 - 2952+00 NB.V

STAGE 2 CONSTRUCTION

PLAN	DATE	BY
REVISIONS		
NO.	DESCRIPTION	DATE
1	ISSUED FOR PERMIT	7/20/00
2	ISSUED FOR CONSTRUCTION	10/10/00
3	ISSUED FOR CONSTRUCTION	10/10/00
4	ISSUED FOR CONSTRUCTION	10/10/00

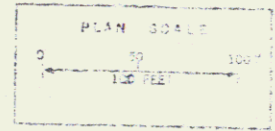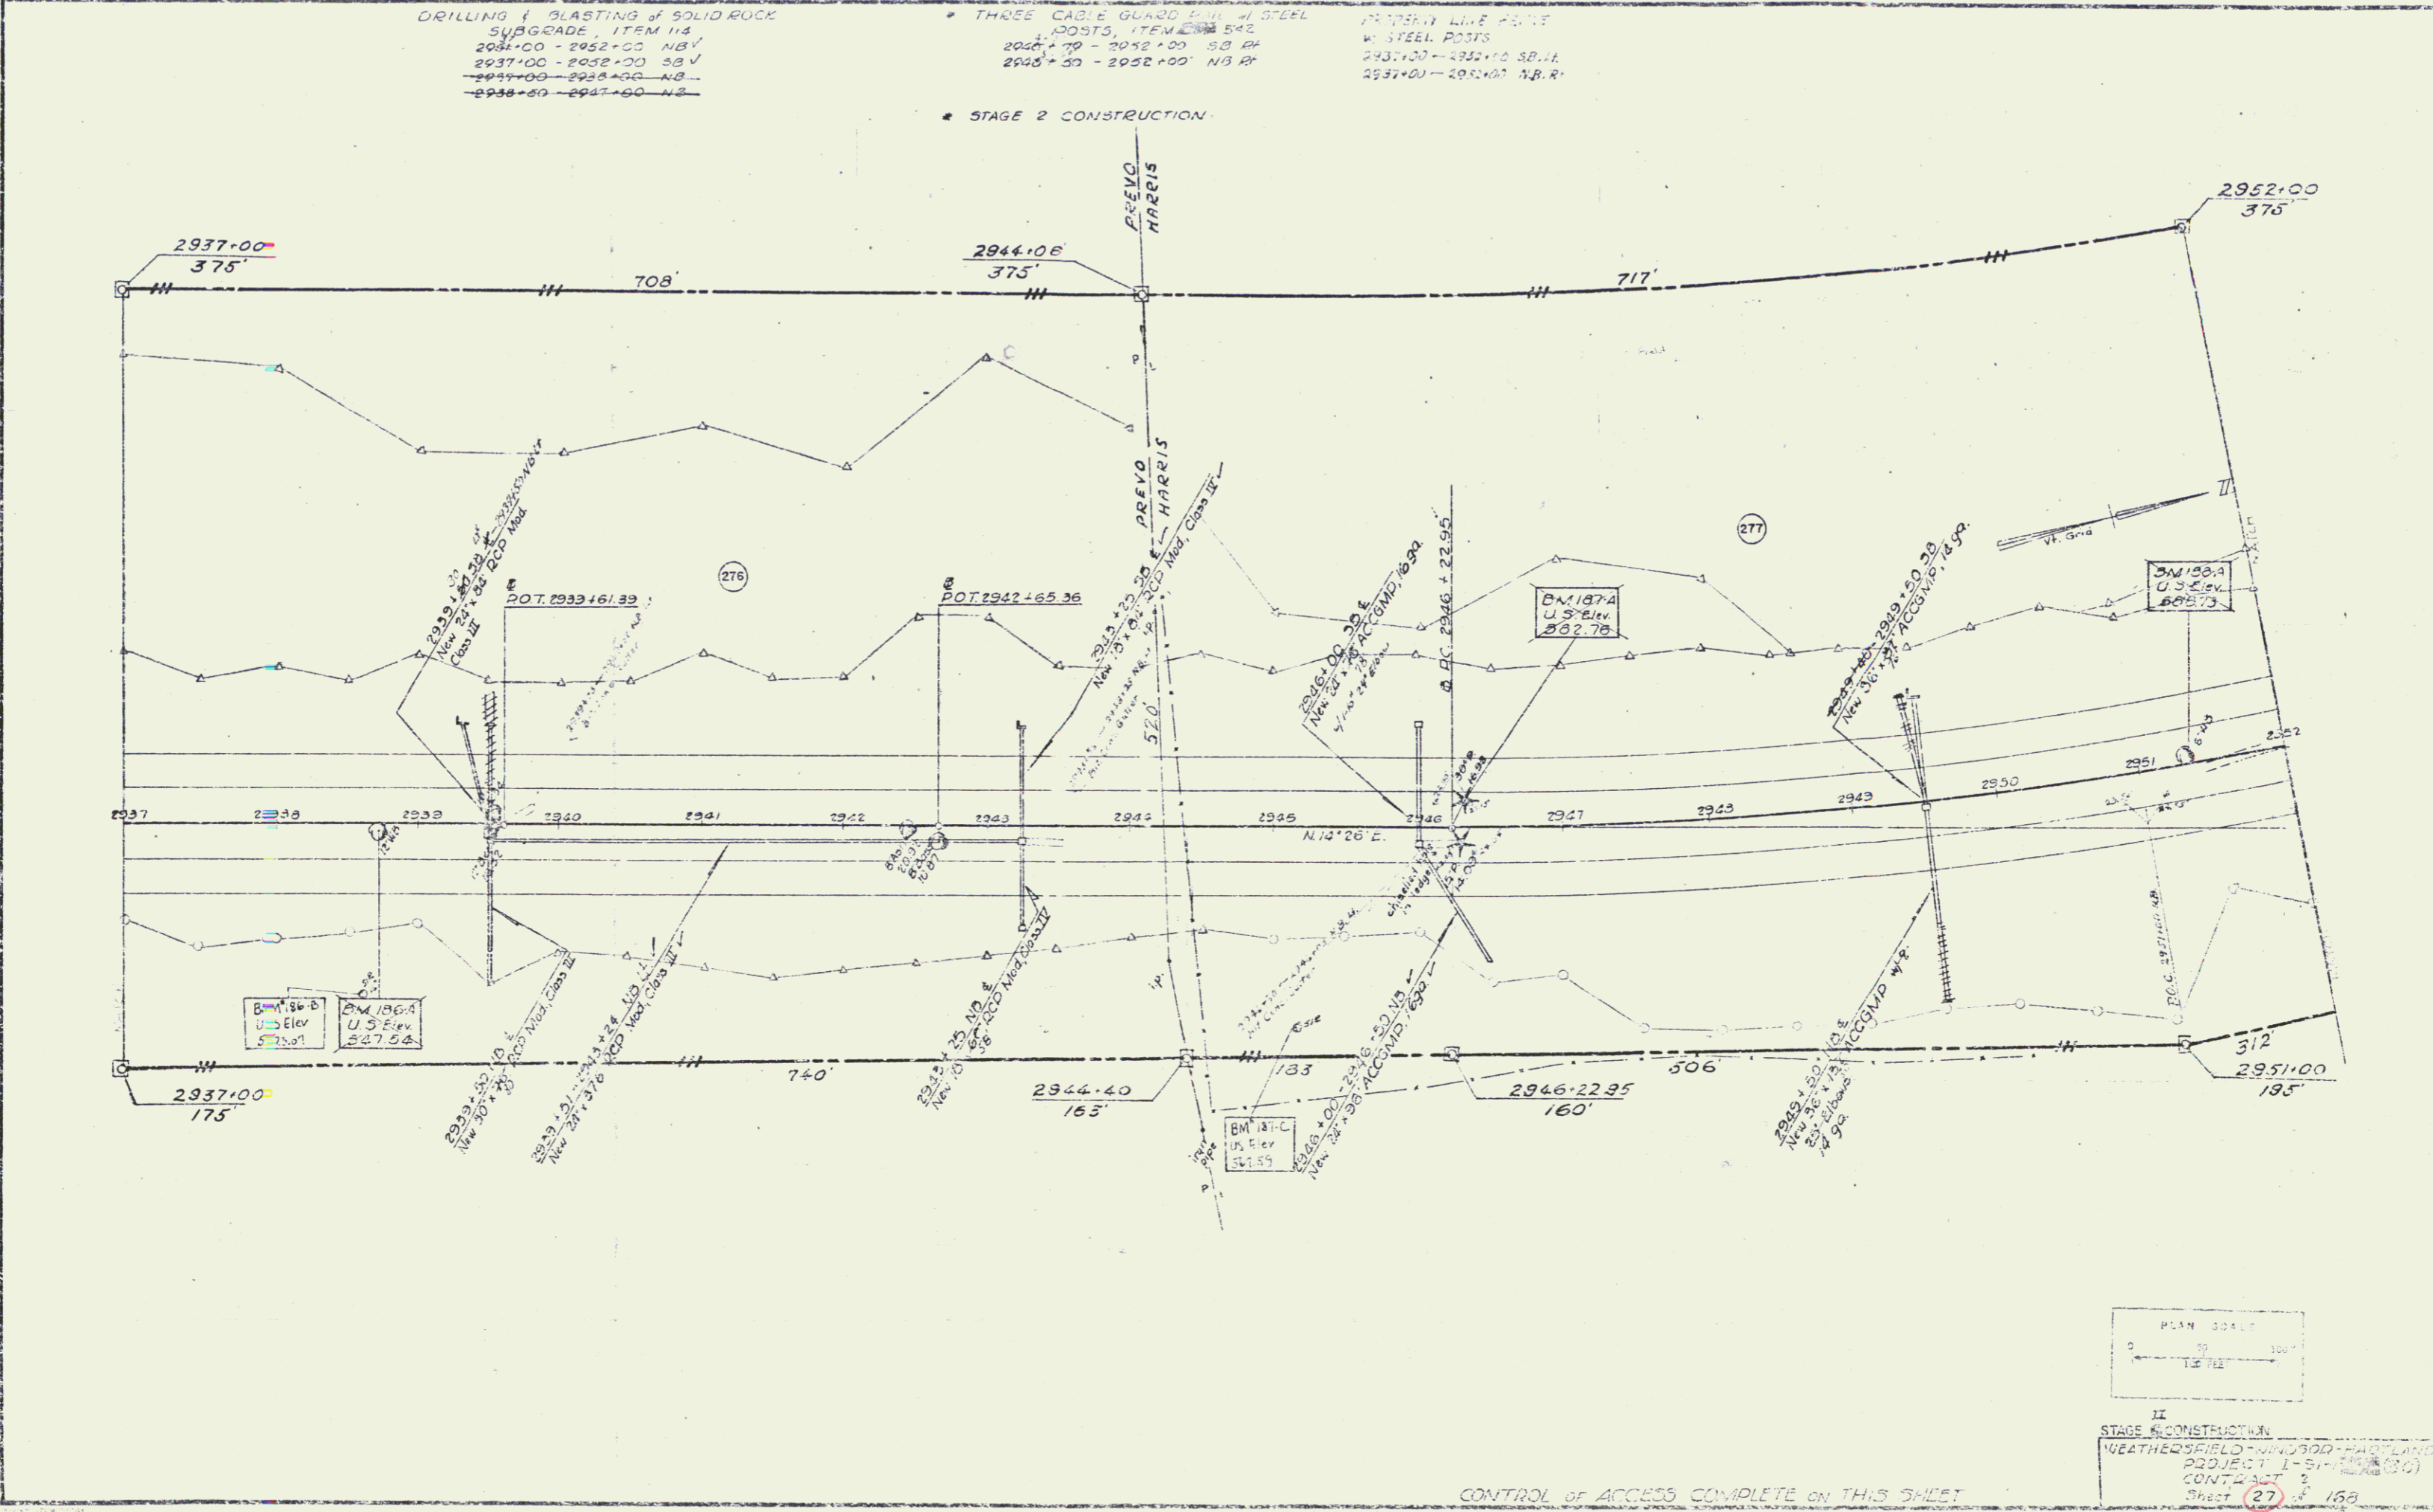

II
 STAGE 2 CONSTRUCTION
 WEATHERFIELD WINDYBOD HARBORLAND
 PROJECT 1-S-1000(30)
 CONTRACT 2
 Sheet 27 of 158
 Sheet 27 of 158

CONTROL of ACCESS COMPLETE on THIS SHEET