


PLAN	DATE	BY
DATE	BY	BY
DATE	BY	BY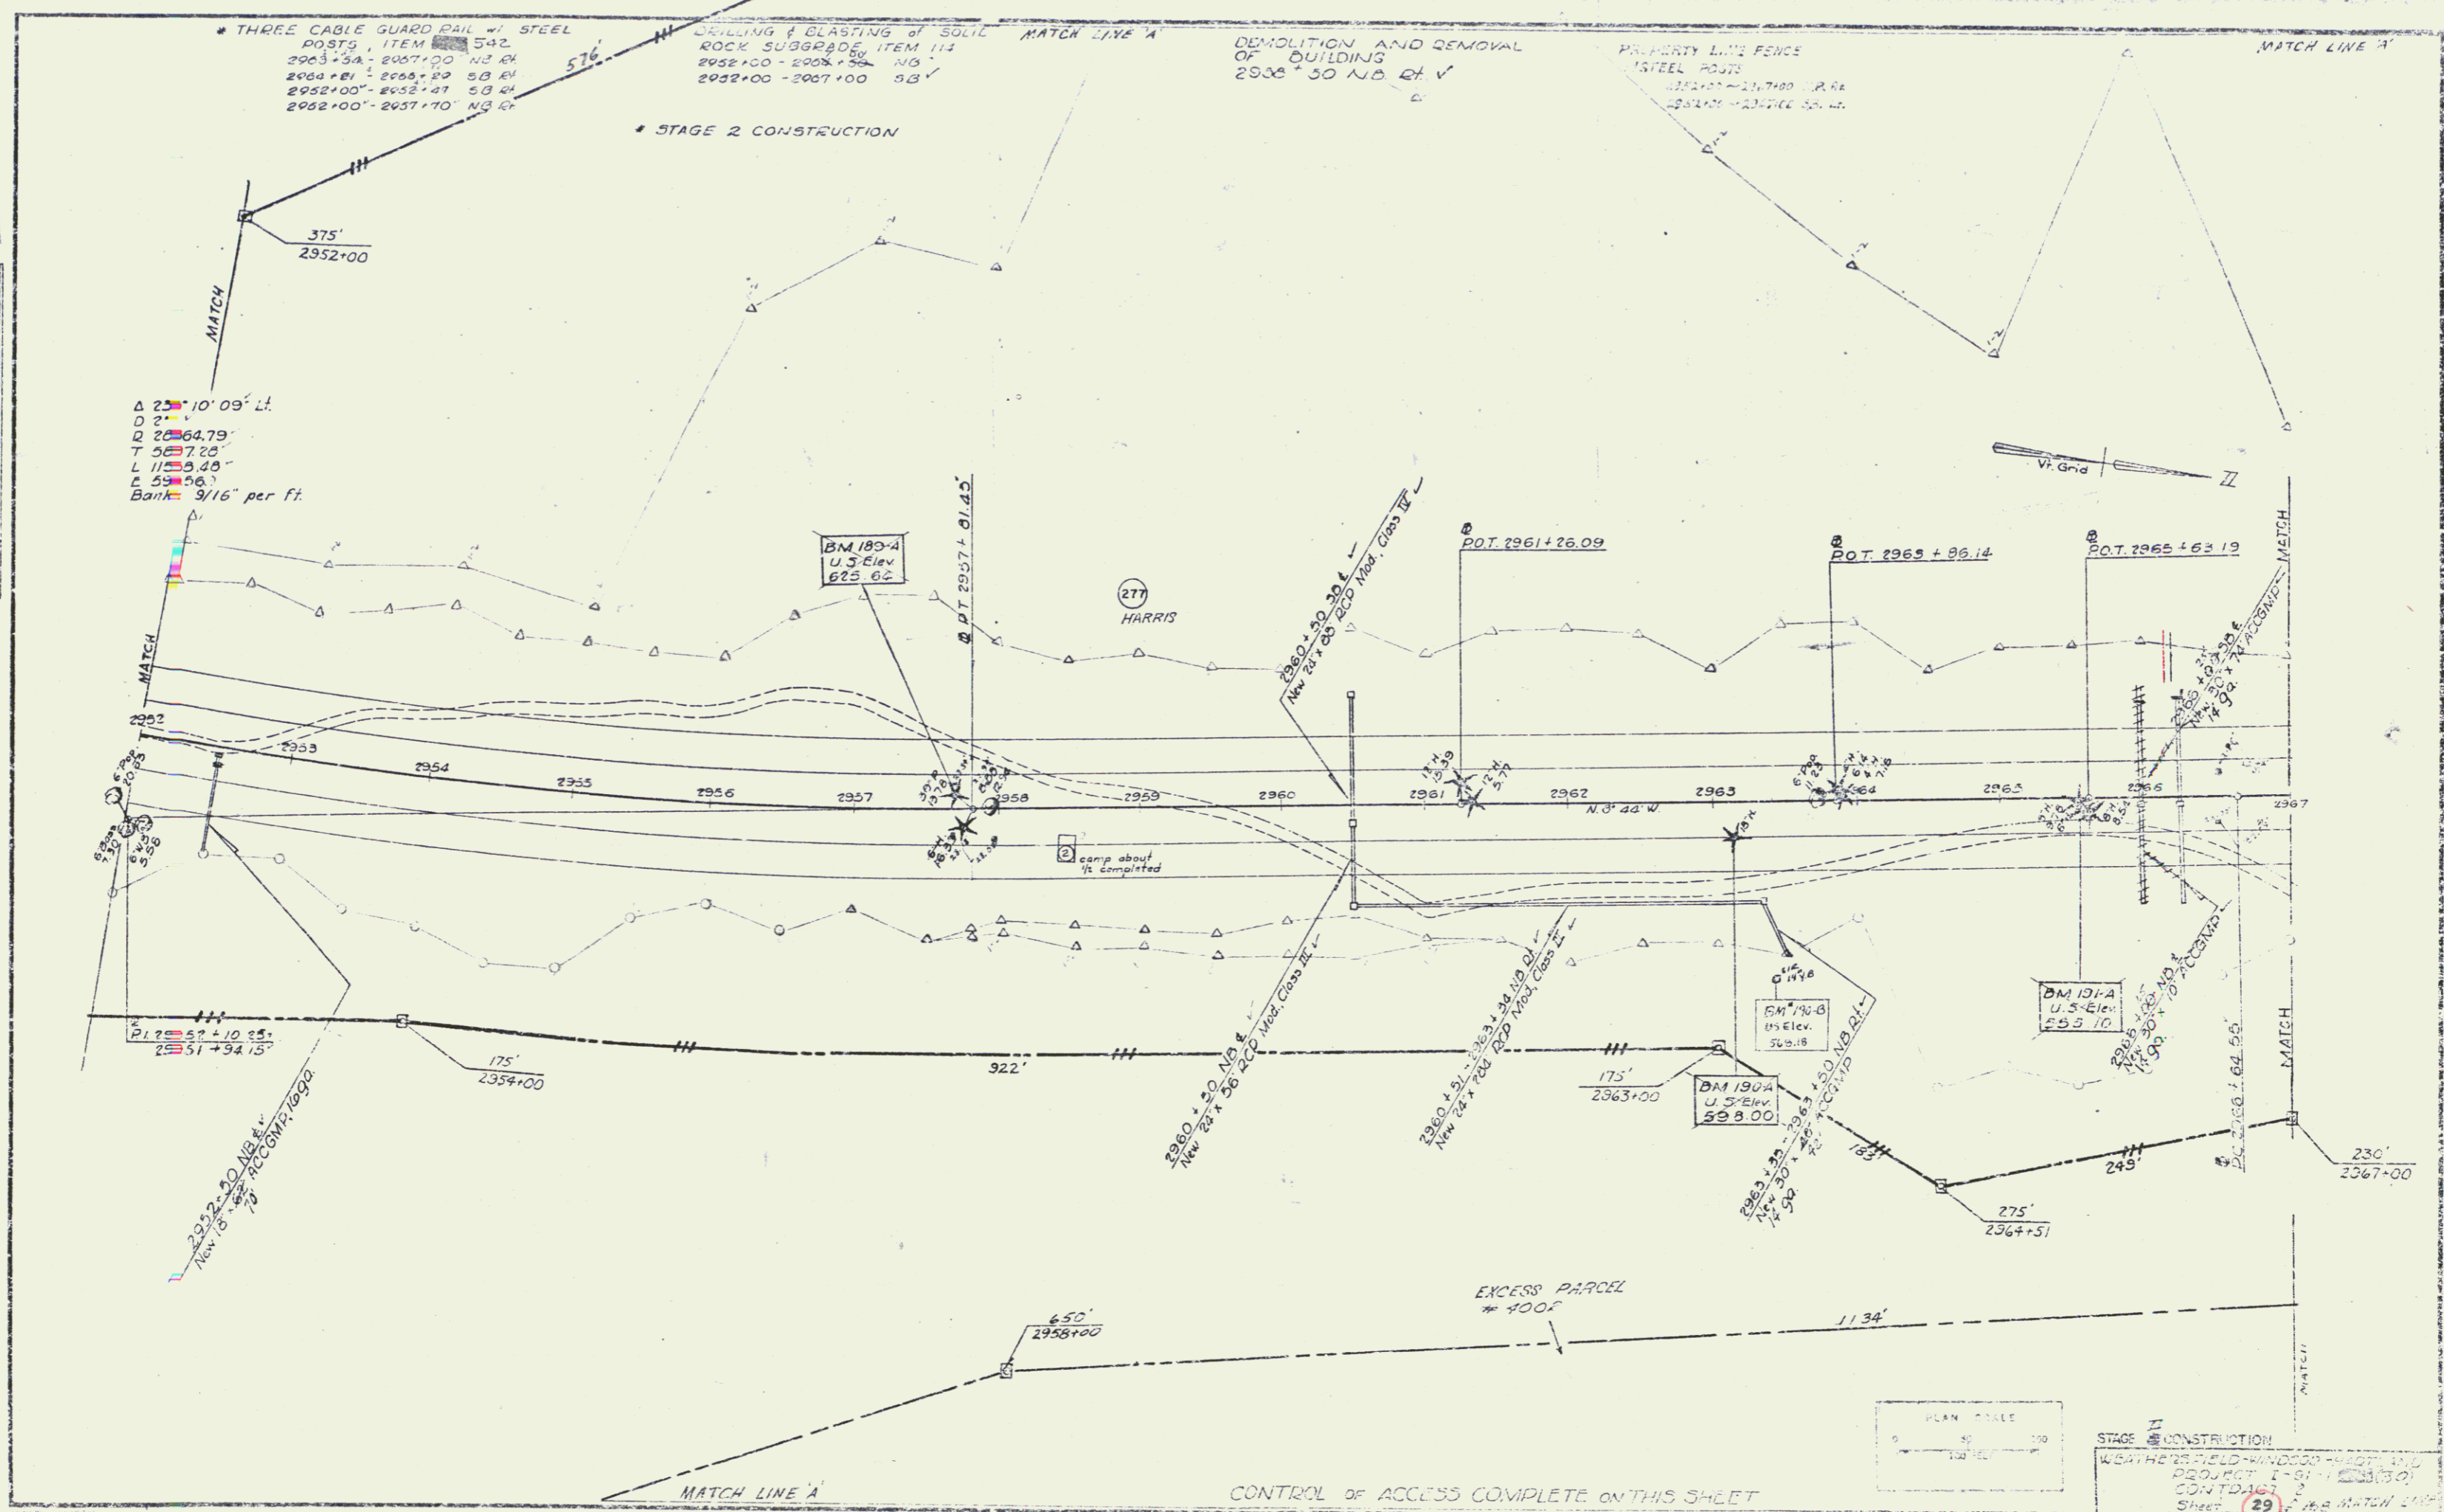
STAGE II CONSTRUCTION
 WEATHERS FIELD WINDSOR PROJECT I-81
 CONTRACT NO. 1-81-1-103
 SHEET NO. 29
 DATE 12/01/88