


PLAN	DATE	BY
APPROVED		
REVISION		
NO.		



ROW Rev No 1 10-5-69 E.A.A.  
 ROW Rev No 2 10-8-63 E.A.A.

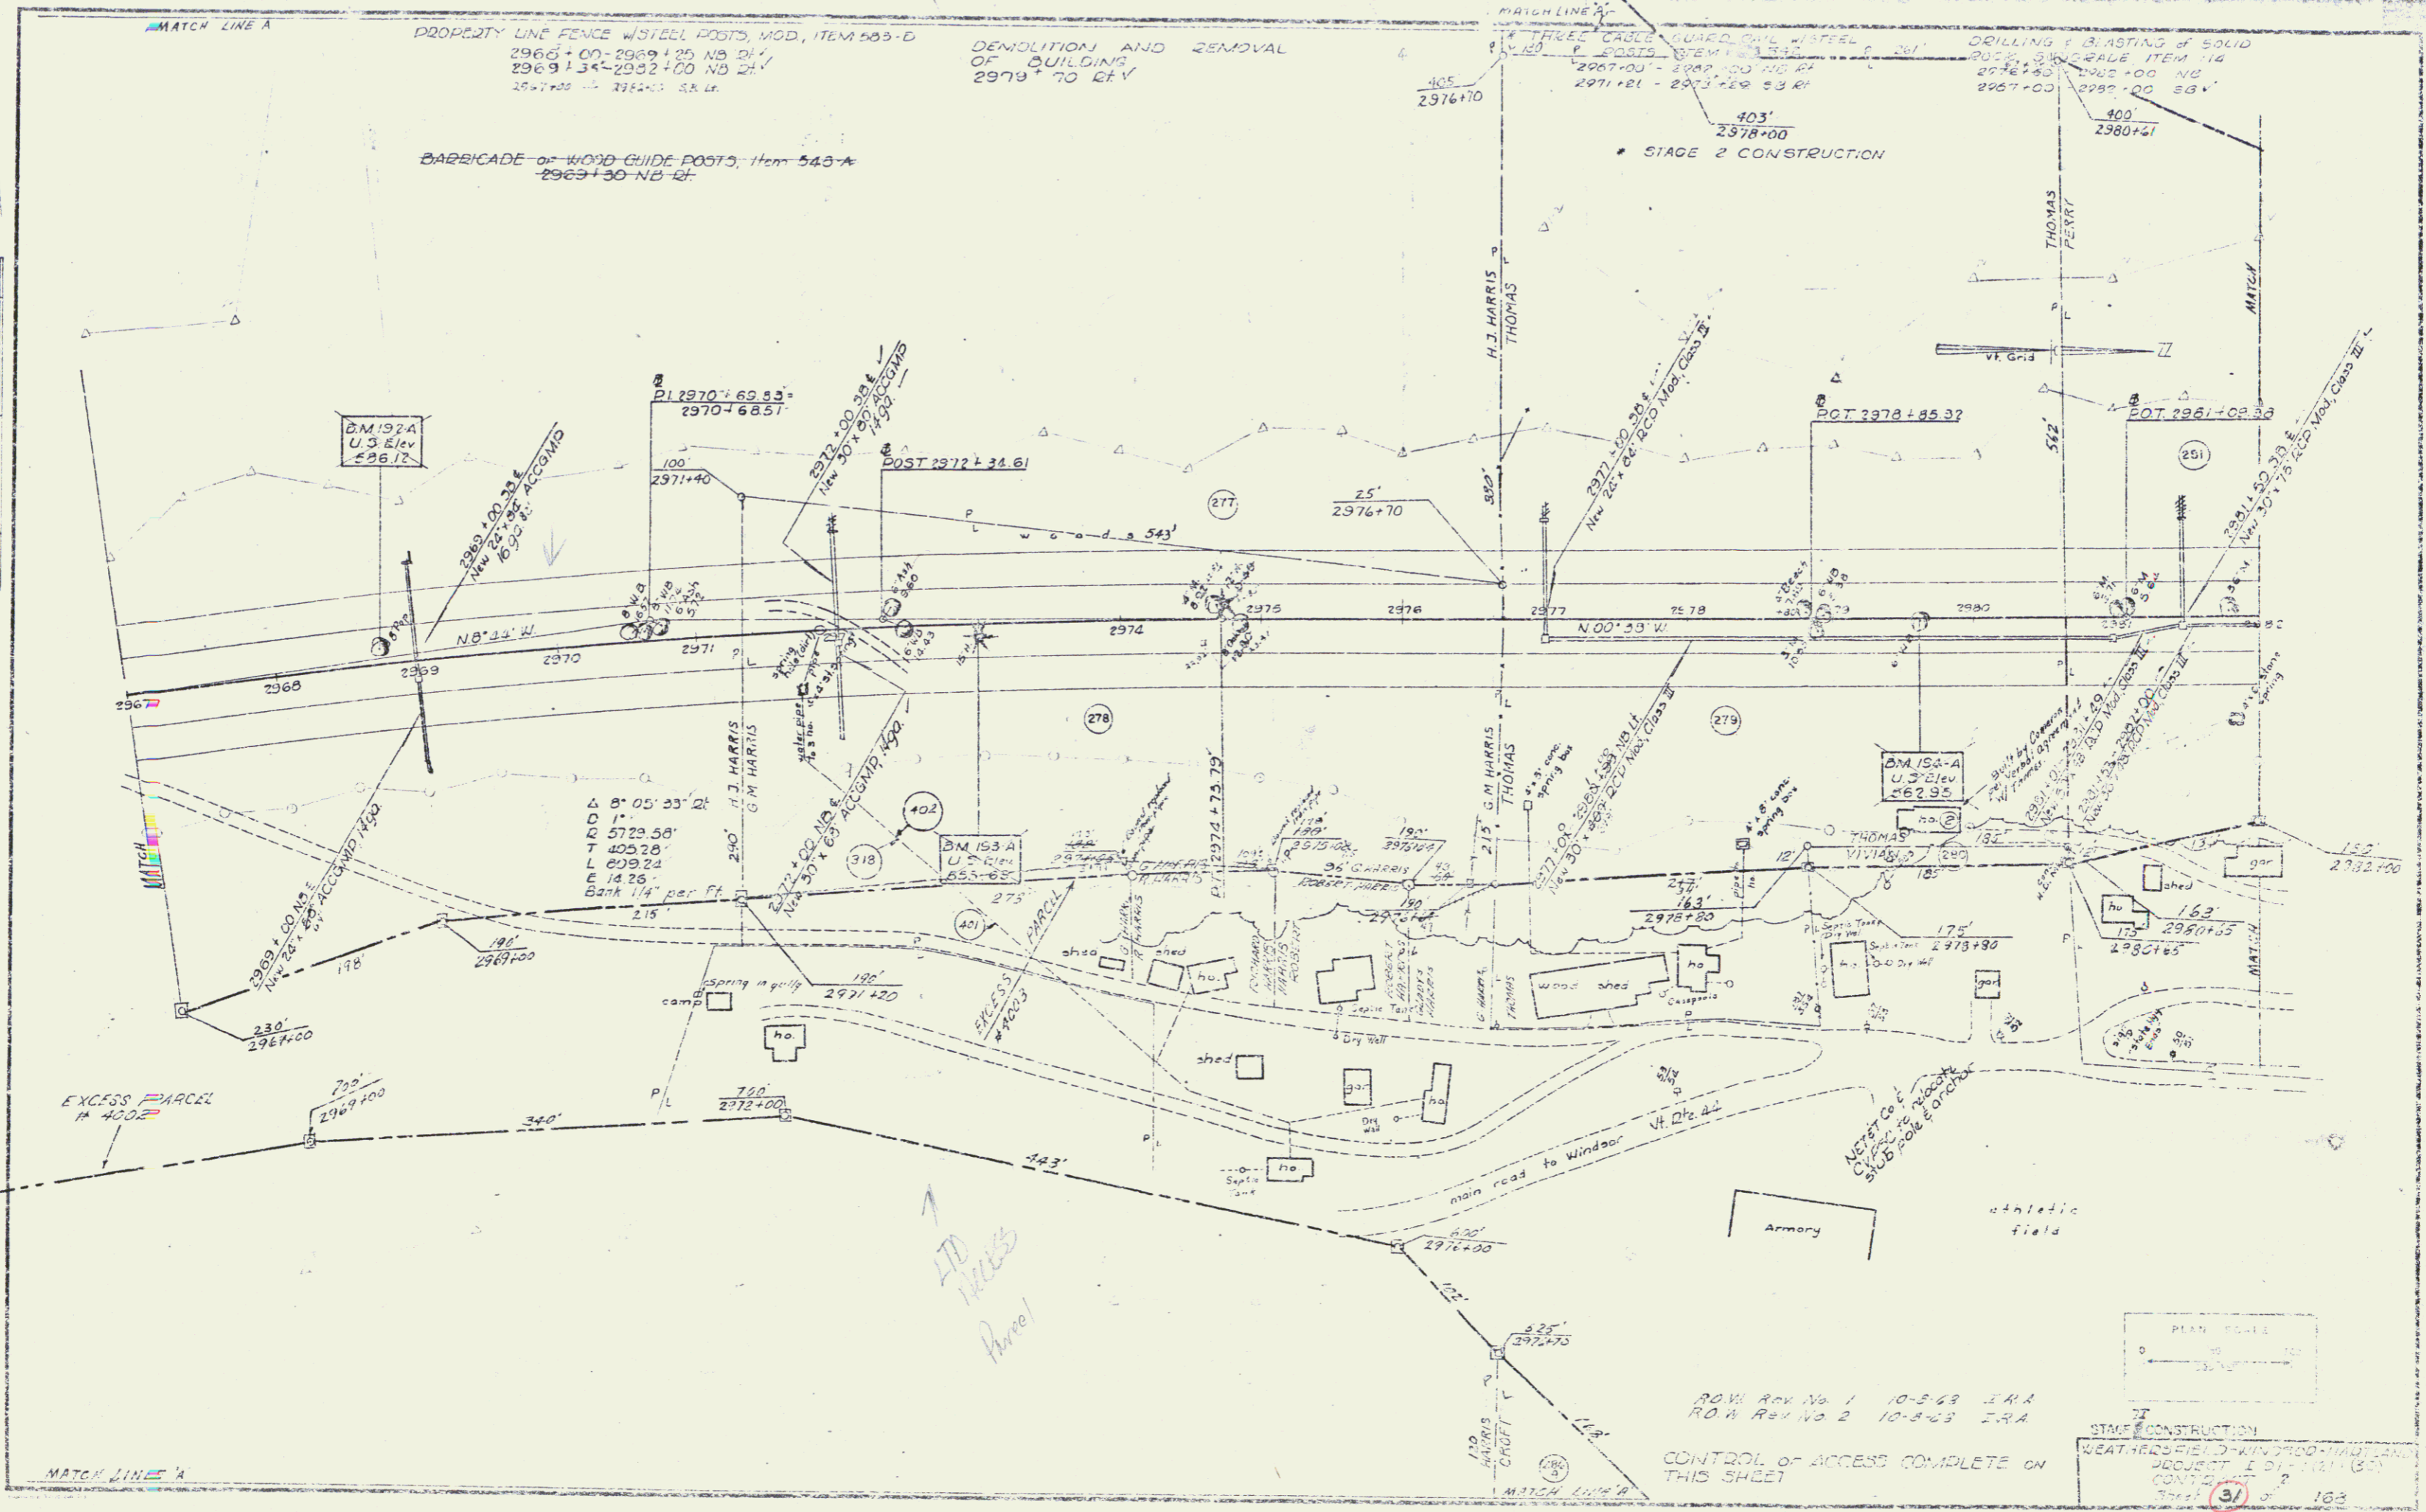