

DATE	
SCALE	
PROJECT	
NO.	
BY	
CHECKED	
DATE	

THREE RAIL GUARD RAIL
W/STEEL POSTS, ITEM 542-A
2982+00 - 2985+50 NB DT

BITUMINOUS CONCRETE CURB
TYPE I, ITEM 555
2986+00 - 2988+50 NB DT

DRILLING & BLASTING of SOLID ROCK
ITEM 114-B
2982+00 - 2983+50 NB
2982+00 - 2983+50 SB


PROPERTY LINE FENCE w/STEEL POSTS, ITEM 583-B
SB LT NB DT
2984+00 - 2985+50 V 2982+00 - 2987+45 V
2987+60 2988+50

BARRICADE of WOOD GUIDE POSTS, ITEM 548-A -
2987+50 NB DT

DEMOLITION AND REMOVAL OF
BUILDING
2988+30 DT

STAGE 2 CONSTRUCTION

EXCESS PARCEL
4004

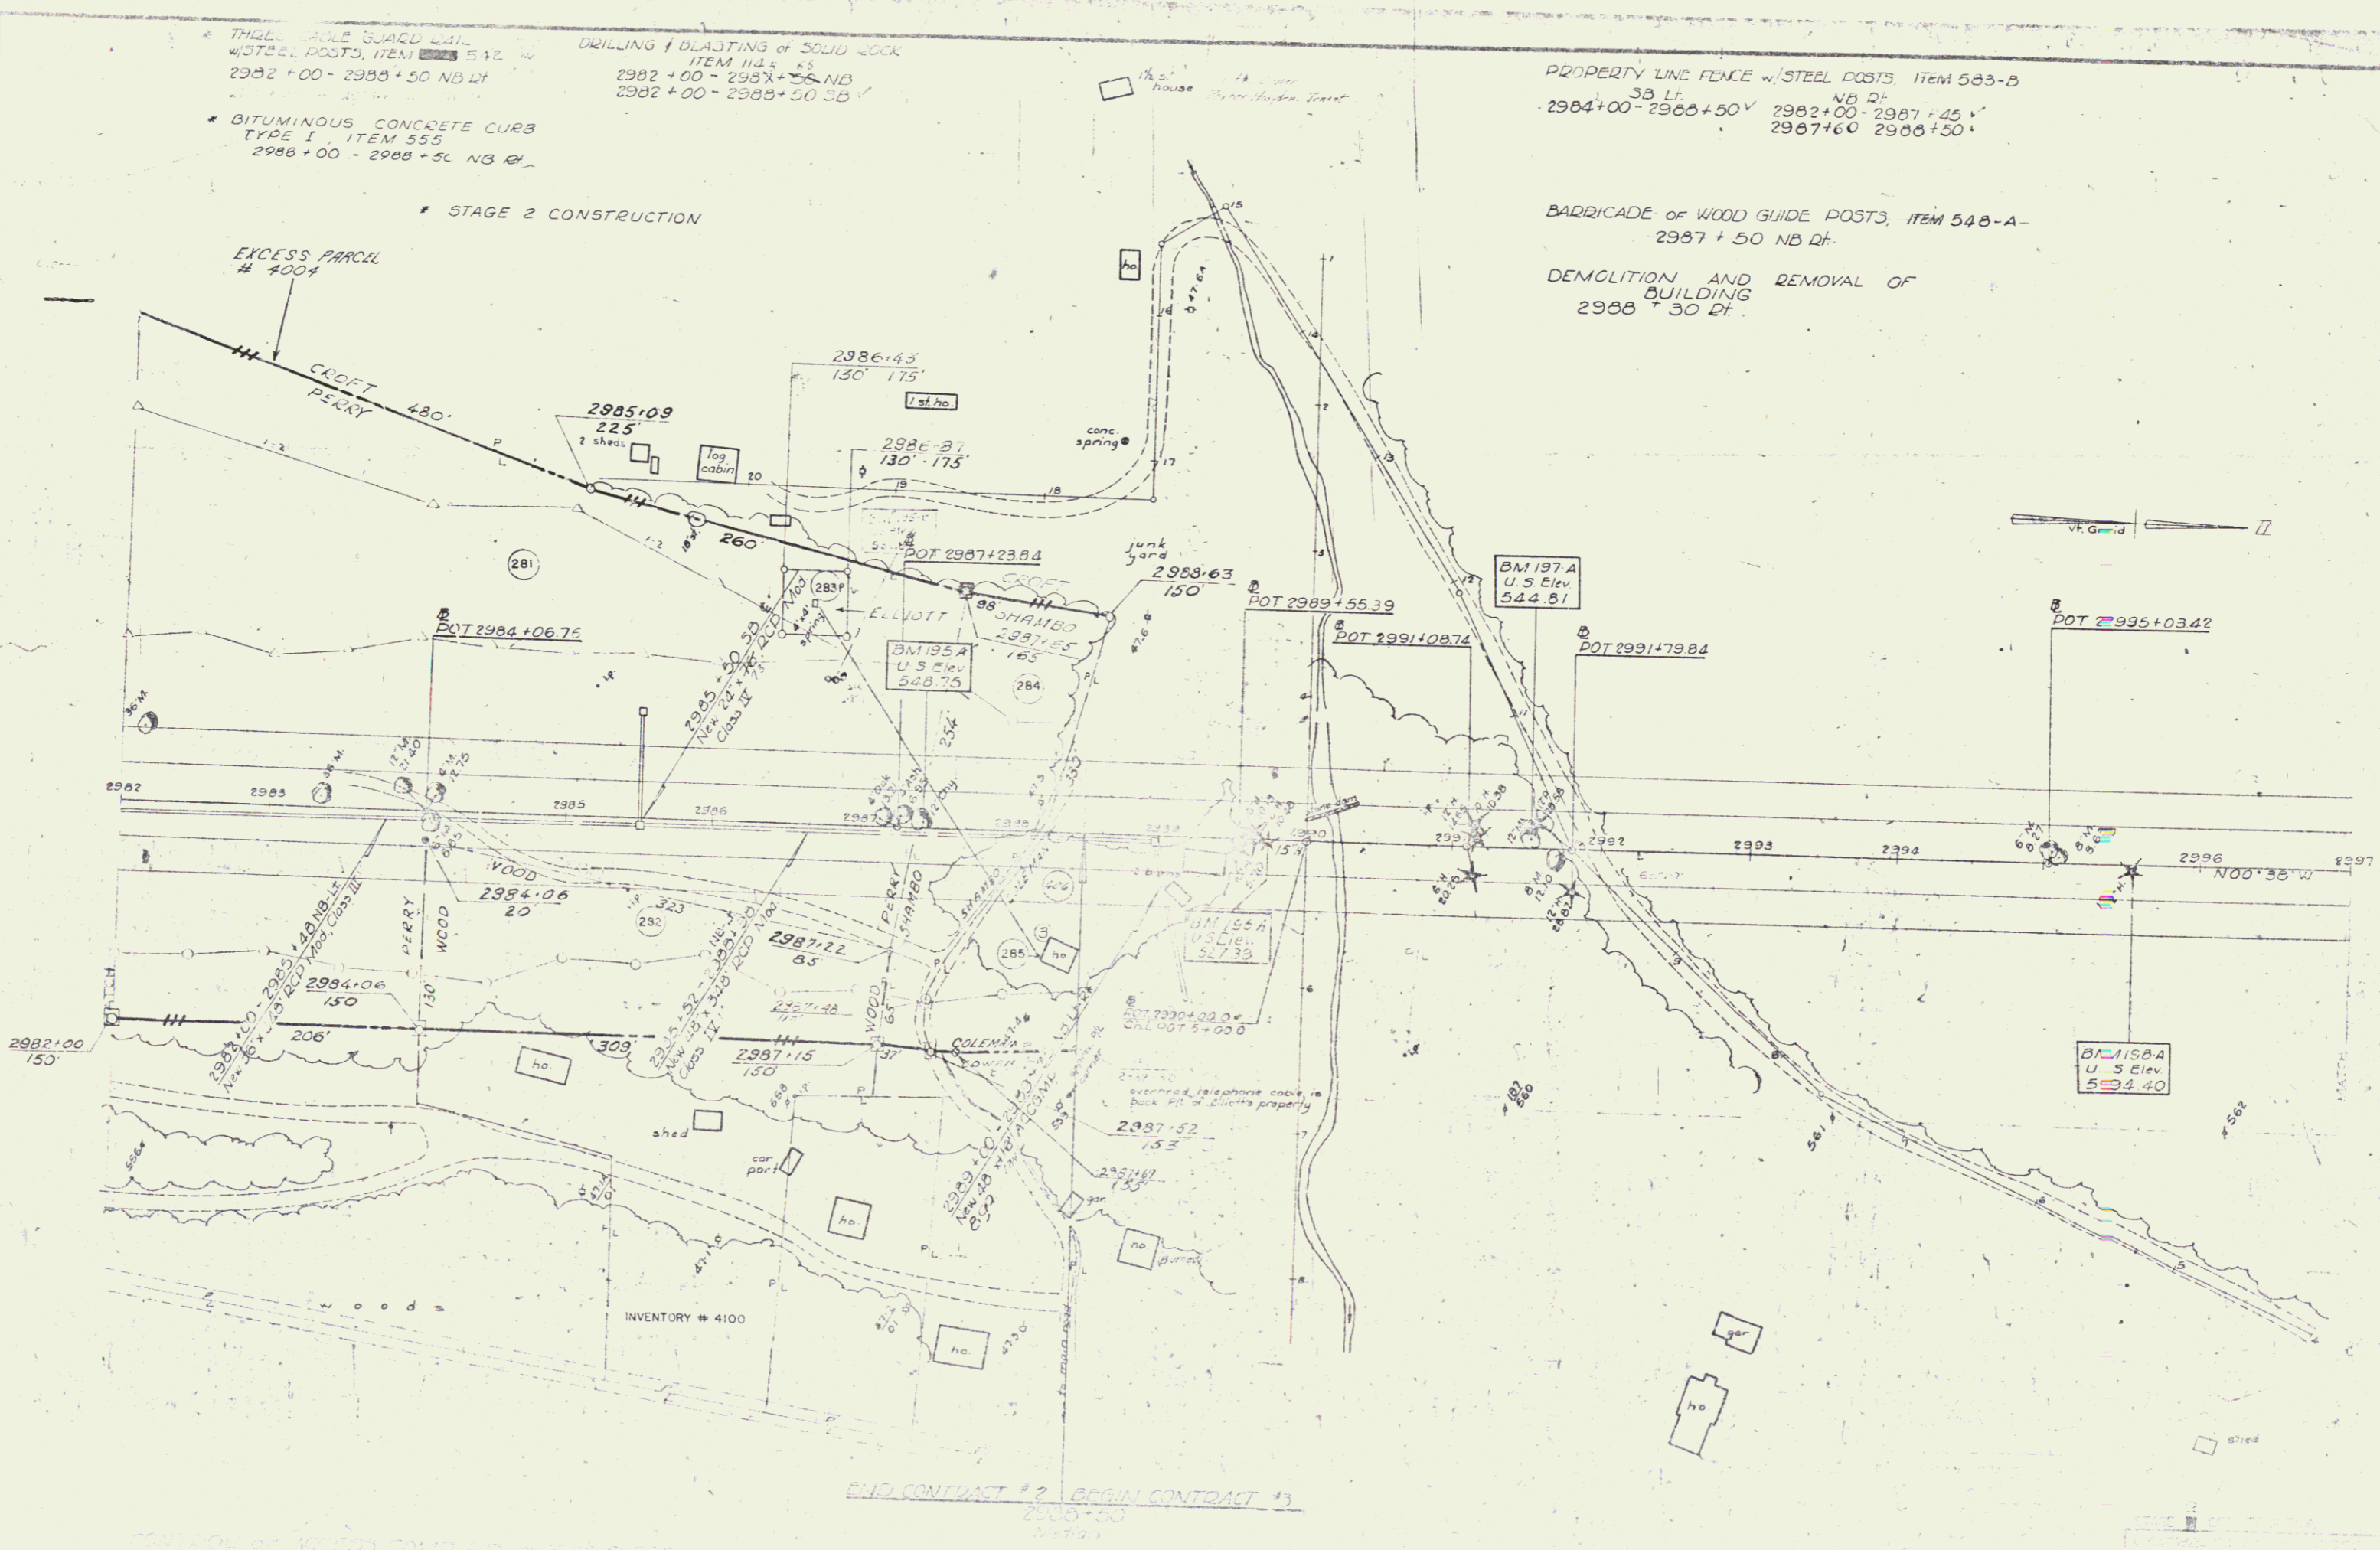

END CONTRACT # 2 BEGIN CONTRACT # 3
2985+50

33