


|             |           |
|-------------|-----------|
| DATE        | 7.6.02    |
| BY          | J. Strain |
| REVISION    |           |
| NO.         |           |
| DESCRIPTION |           |
| DATE        |           |
| BY          |           |
| REVISION    |           |
| NO.         |           |
| DESCRIPTION |           |

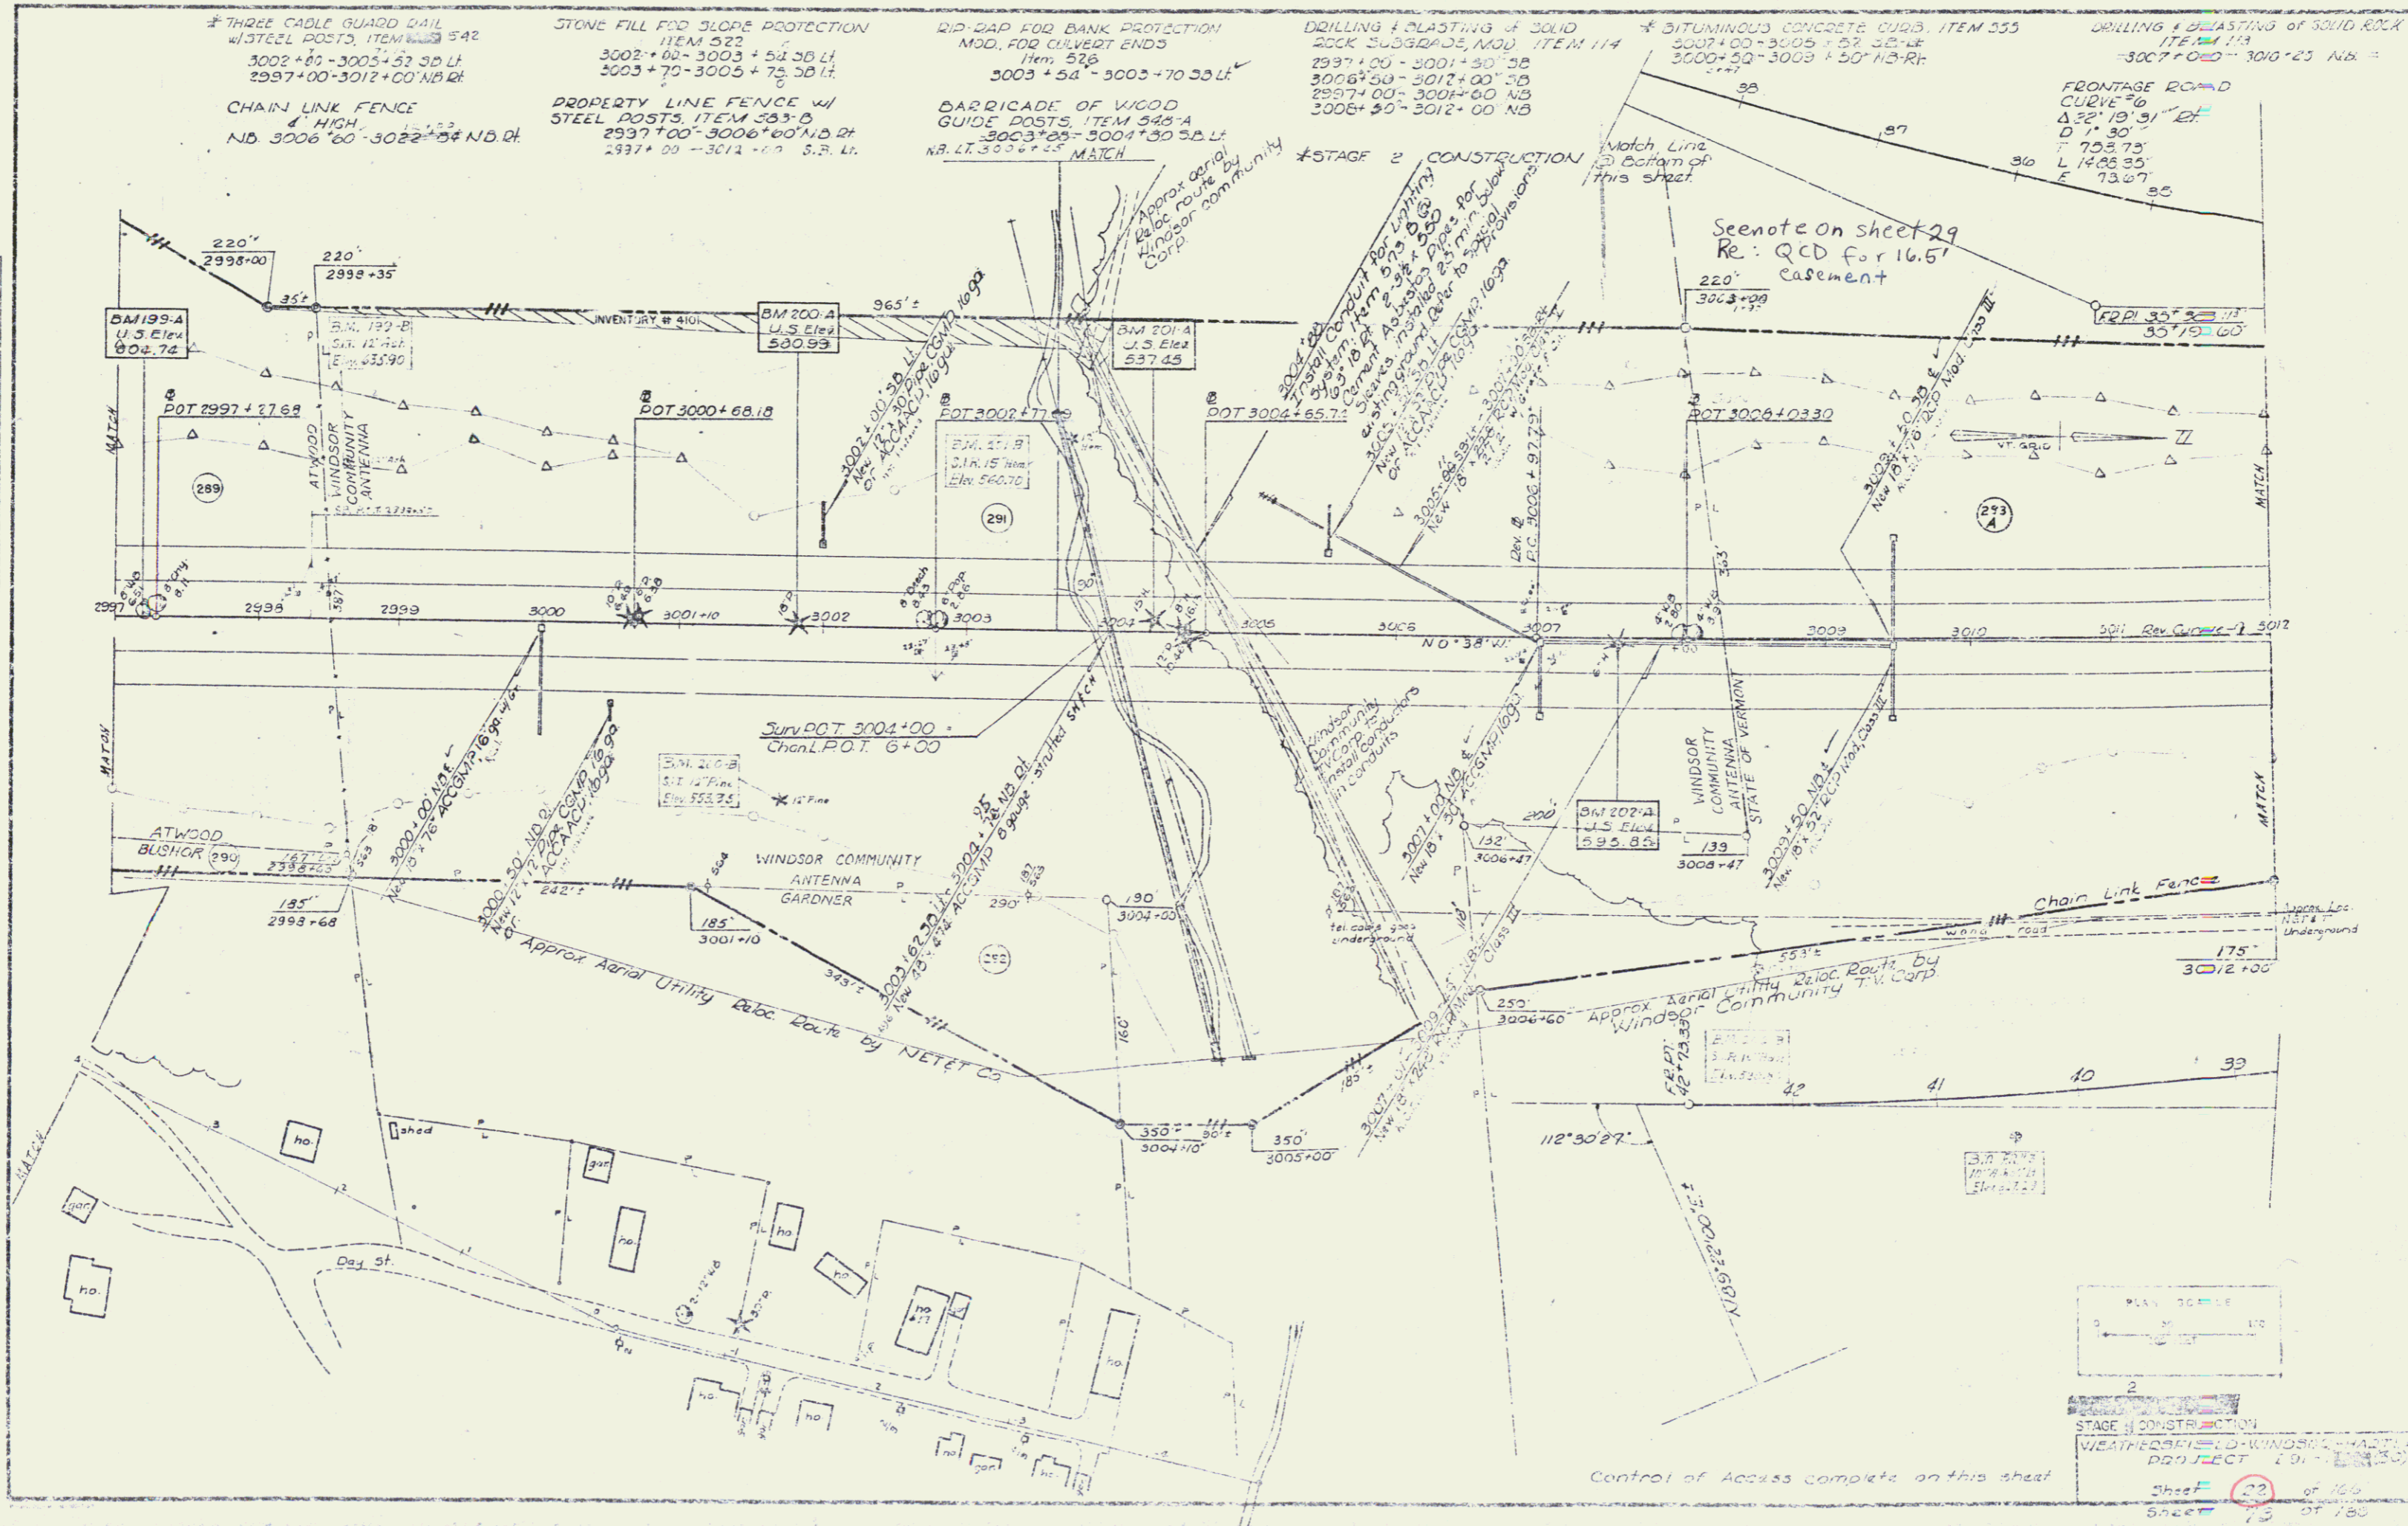

STAGE 2 CONSTRUCTION  
 WEATHER STATION - WINDSOR COMMUNITY  
 PROJECT 191-1-10000  
 Sheet 23 of 160  
 Sheet 15 of 180

Control of Access complete on this sheet