


PLAN	DATE	BY	CHECKED
WEATHERS FLD-WINDOOR-HAWPLAND PROJECT (S1-1108130)	7/20/11	W. J. ...	...

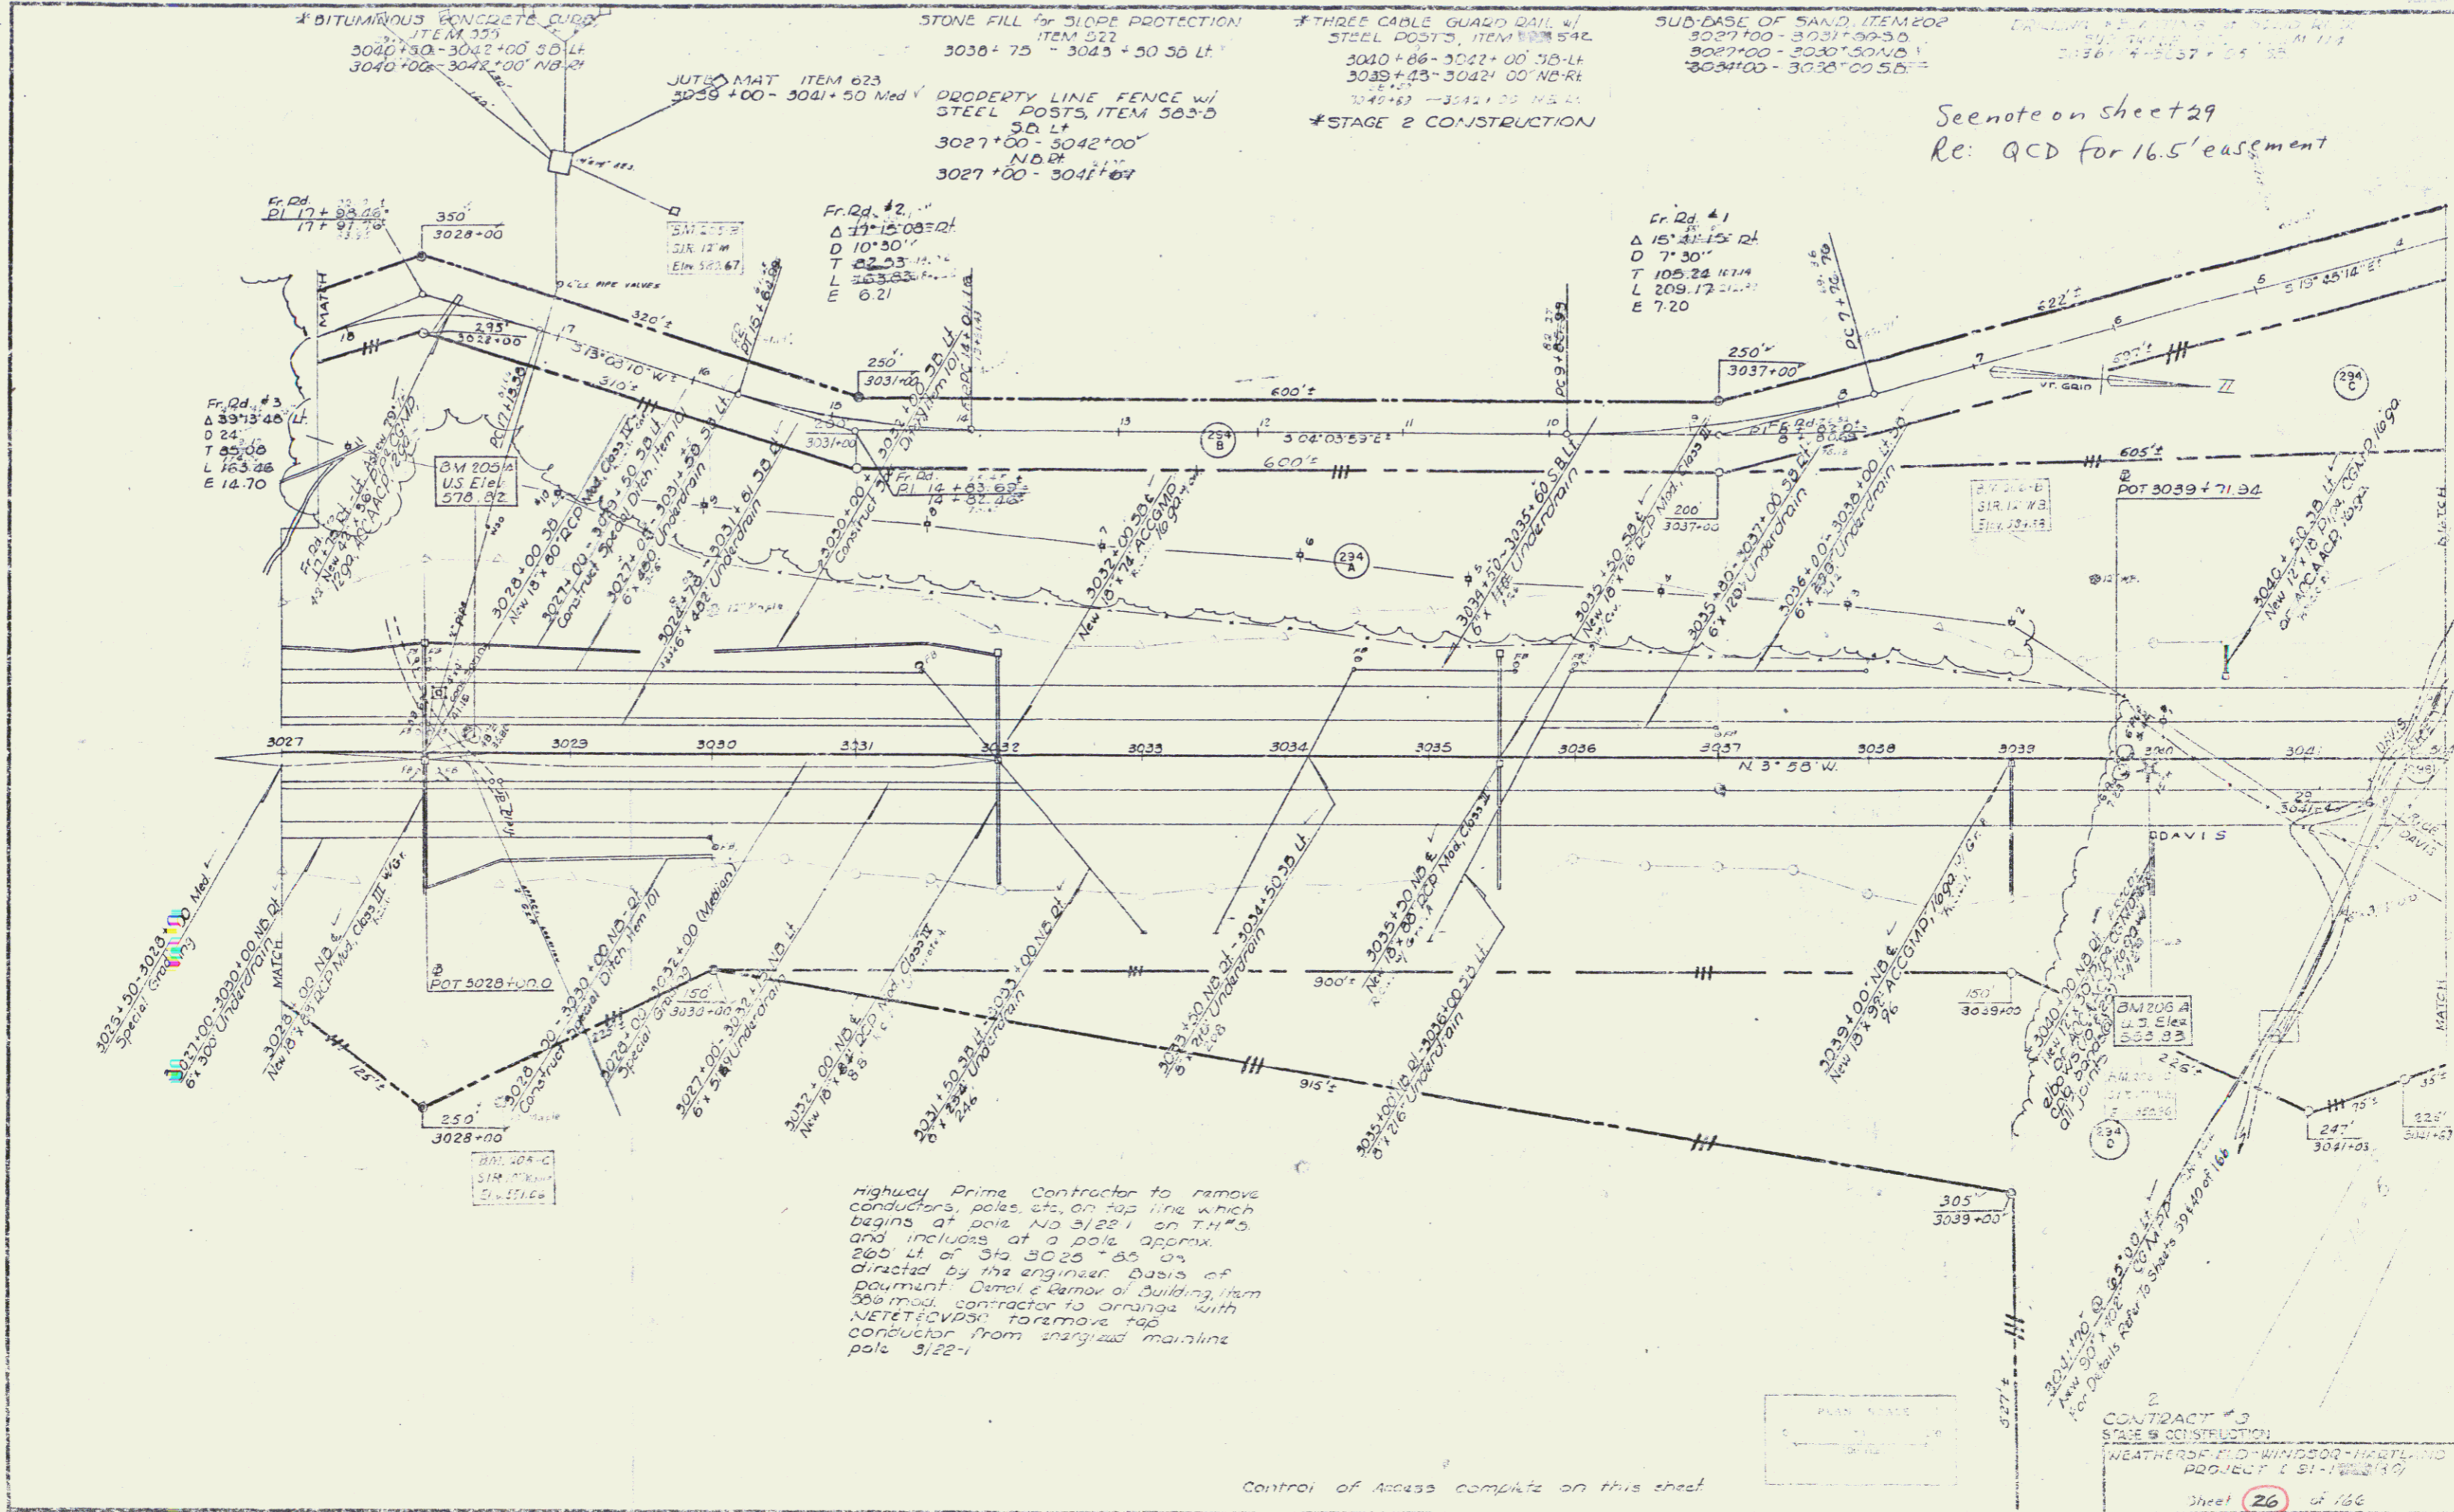

See note on sheet 29  
Re: QCD for 16.5' easement