


| | | |
|------|----|----------|
| DATE | BY | REVISION |
| | | |
| | | |
| | | |

16.5' easement for ingress & egress Sta. 3008+00 to 3045+15
 State of VT to Village of Windsor
 Pauline H Davis
 Windsor Cemetery Assn.
 Windsor Community Antenna Corp.
 by individual QCD's 9/29/04
 Bk 79 Pages 1 - 8 Windsor Land Records

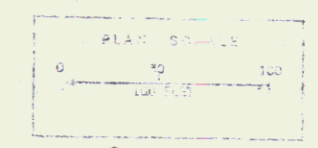

STAGE 2 CONSTRUCTION
 WEATHERSDORF FLD - WINDSOR - 400' WIDE
 PROJECT 1811 (18130)
 Sheet 29 of 40
 Sheet 54 of 180