

PROPERTY LINE FENCE w/ STEEL POSTS ITEM 5B3 E
 3223+00 - 3228+50 S.B. LI
 3223+00 - 3224+78 N.B. RI
 3225+74 - 3228+20 N.B. RI


SUB BASE of SAND, ITEM 201
 3223+00 - 3228+50
 3225+00 - 3228+50

Construct Turn-around on Town Road
 3224+15 ±, 125' to 170' N.B. RI
 3228+50 Max.

JUTE MATTING, ITEM 823
 3224+00 - 3225+50 N.B. RI
 3225+25 - 3227+75 S.B. LI

* PLANK GUARD RAIL w/ PRESERVATIVE TREATMENT, ITEM 5+0
 3225+62 - 3225+74 N.B. RI

* Stage Two Construction
 3225+37 - 3227+61 S.B. LI

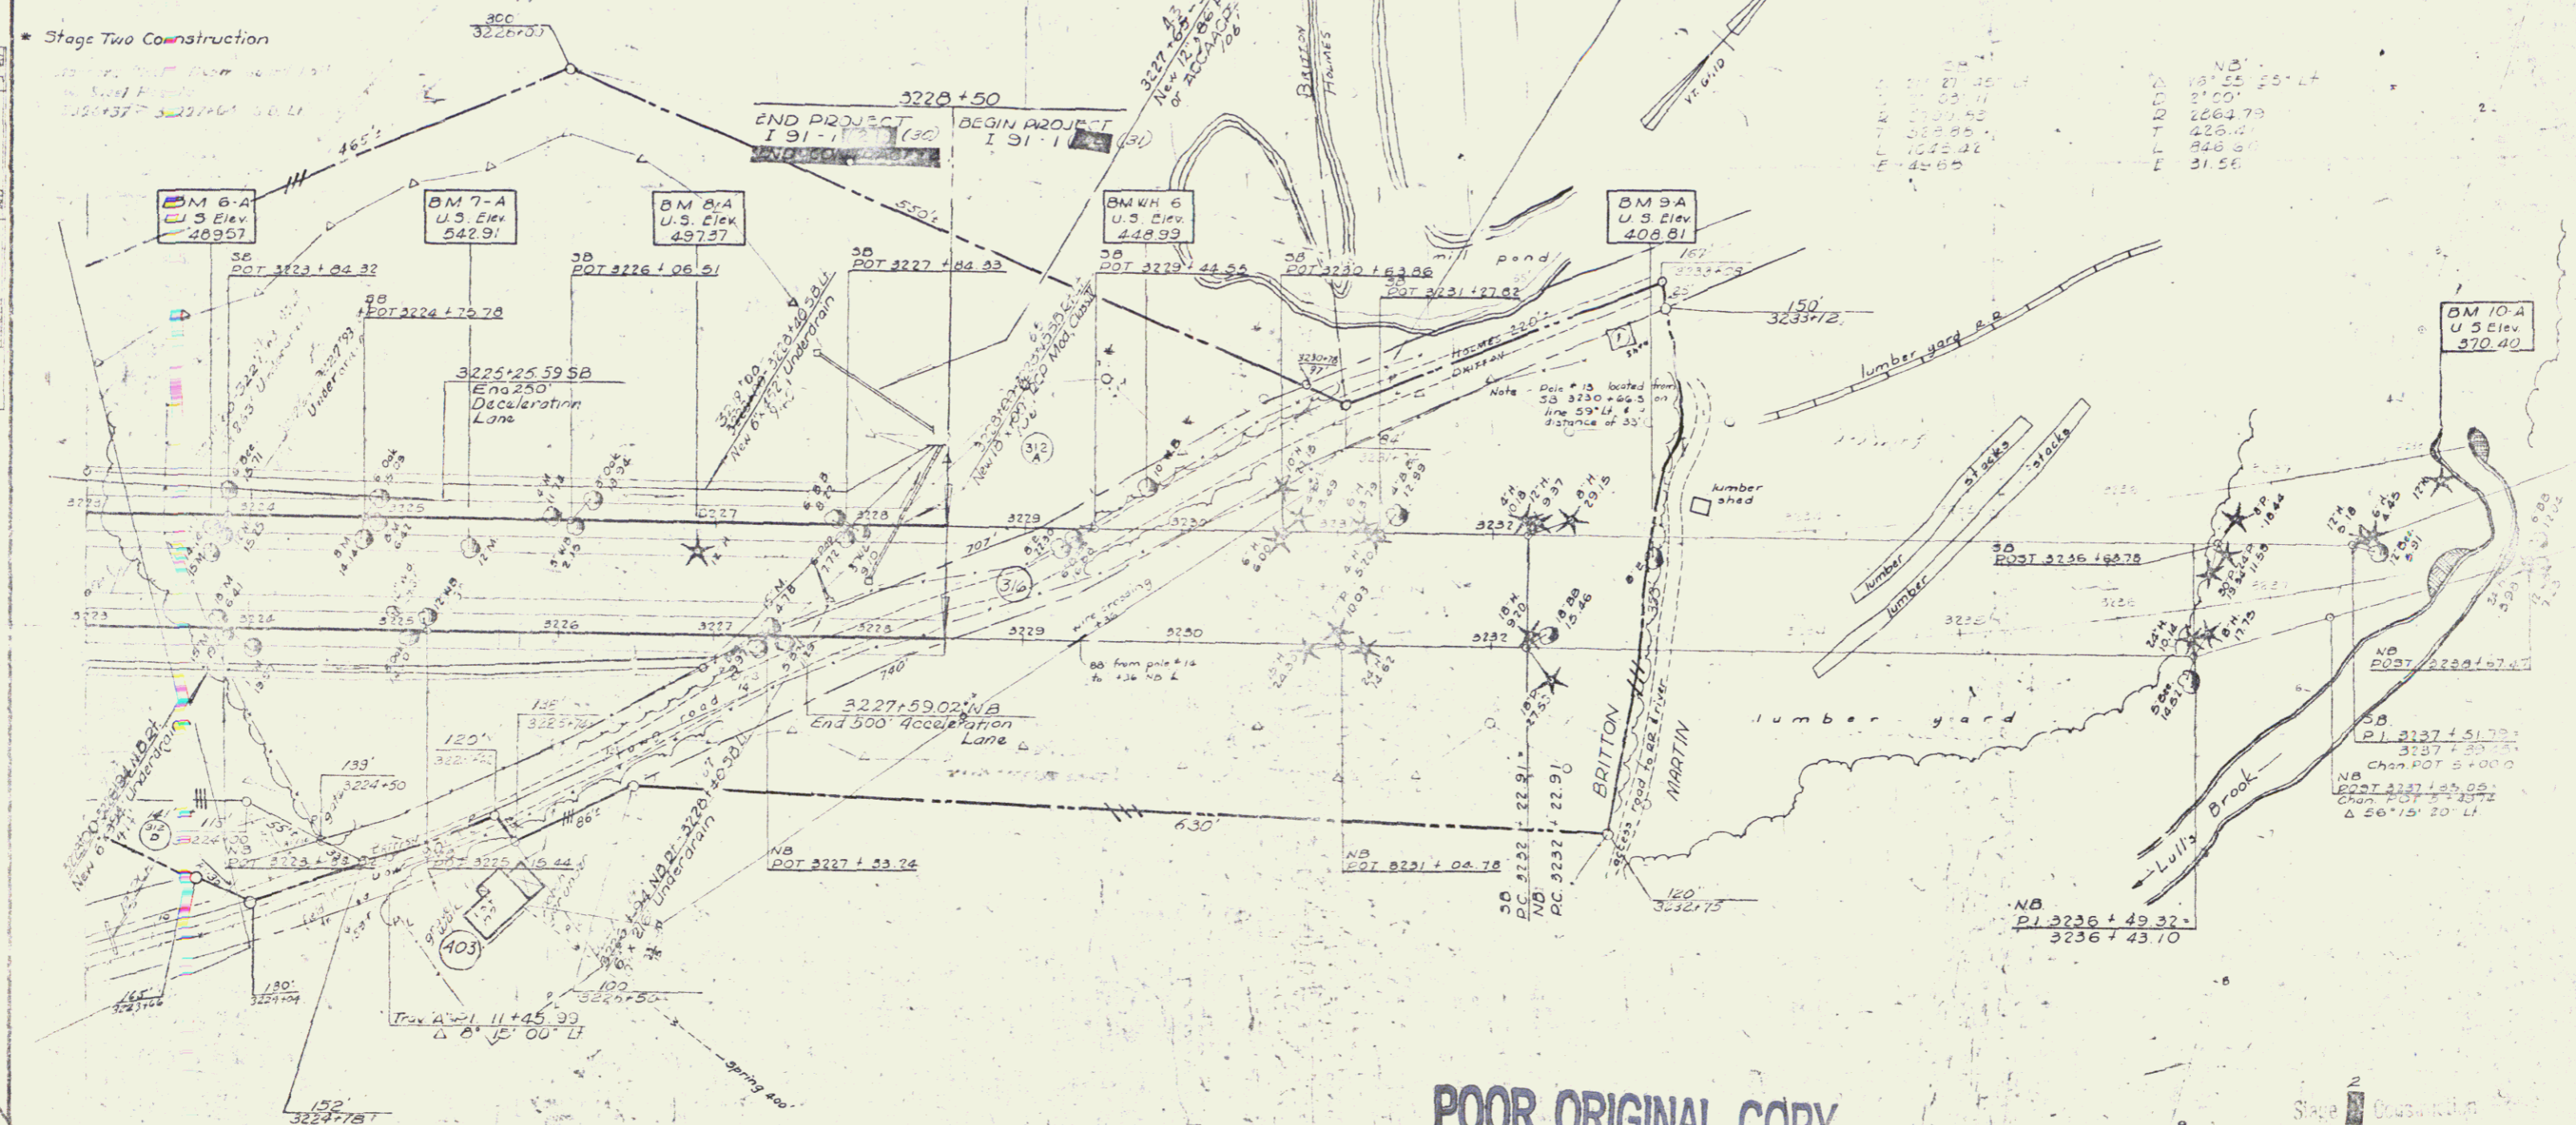

Station	U.S. Elev.
3223+00	426.00
3223+25	426.00
3223+50	426.00
3224+00	426.00
3224+25	426.00
3224+50	426.00
3225+00	426.00
3225+25	426.00
3225+50	426.00
3226+00	426.00
3226+25	426.00
3226+50	426.00
3227+00	426.00
3227+25	426.00
3227+50	426.00
3228+00	426.00
3228+25	426.00
3228+50	426.00

POOR ORIGINAL COPY

WEATHERSFIELD-WINDSOR-MARTLAND
 PROJECT 19-1127
 Contract 4
 Sheet 37 of 38

Control of Access is Complete on this sheet