

STATE OF VERMONT  
DEPARTMENT OF HIGHWAYS  
RIGHT-OF-WAY PLANS  
(DETAIL SHEET)

TABLE OF PROJECT PROPERTY ACQUISITION


PARCEL	OWNER	SHEET NO.	STATION	STATION	TAKING	REP	RIGHTS	TITLE TAKER	DATE	TOWN OR CITY RECORDED	REMARKS
323	ERNEST W. MARTIN		3232+75 NB	3243+07 SB	21.5A 1A	235.7A	DRAINAGE DRAINAGE DRAINAGE DITCH				SANMILL, SHED
329 A	TOWN OF HARTLAND		3220+50 SB	3243+35 NB	NONE	NA	ALL RTES IN 0.55A1 TR 41 ALL RTES IN 0.6A1 TR 43 ALL RTES IN 0.35A1 TR 42 ALL RTES IN 0.1A1 TR 43 ALL RTES IN 0.1A1 TR 76 ALL RTES IN 0.45A1 TR 78 ALL RTES IN 0.8A1 TR 79 ALL RTES IN 1.0A1 TR 11 ALL RTES IN 0.35A1 TR 15				
B			3262+65 NB	3264+13 SB	NONE						
C			3100+78 42	17+00 RT 5	NONE						
D			21+28 RT	22+10 TR 43	NONE						
E			3367+45 SB	3368+53 SB	NONE						
F			5+49 RT	0+00 TR 78	NONE						
G			3414+00 NB	3415+78 SB	NONE						
H			5+67 RT	3302+78 NB	NONE						
I			3517+81 NB	3518+43 NB	NONE						
J			3536+00 NB	3537+07 NB	NONE						
K			3568+00 NB	3569+18 NB	NONE						
330A	JOHN G. & PAULINE M. PERRON		3218+50 NB	3219+00 SB	10.8A 1A	11.0A	DRAINAGE DRAINAGE DITCH				
B			3264+50 NB	3265+00 NB	0.2A						
332A	J. KINGSLEY STEVENS		3271+00	3272+30 NB	7.2A 1A	8.8A	DRAINAGE ALL RTES IN 12' ROW				HOUSE
B			3265+72	3271+00 NB	1.0A						
C			17+00 RT 5	3272+40 SB	0.5A						
333	HENRIETTA L. FLESC		3277+00 SB	3278+00 NB	NONE	46.0A	SPRING				
334	HAROLD W. & LETA F. BARBOUR		3279+00	3280+00 NB	NONE	1.0A	SPRING				
335	EARL E. & BEATRICE HUBBARD		3279+00	3280+00 NB	NONE	2.0A	SPRING				
336	RALPH D. & VELMA STILSON		3278+30	3281+53 NB	2.5A 1A	1.3A	DRAINAGE				
			3278+50 NB				DRAINAGE				
337	RICHARD D. & ETHEL B. SYKES		17+00 RT 5	3200 RT 5	0.4A	14.6A					
338	DONALD A. & EUGENIA M. FRAIL		0+20 TR 5	3100 TR 5	0.5A	0.6A	DRIVE 21'90" LT TR 42				
339	THOMAS E. & MARLENE A. FOLEY		12+74 NB	18+23 TR 43	1.1A	1.9A	DRIVE SEWER PIPE CROSSING ALL RTES IN 12' ROW				
340A	CENTRAL VERMONT RAILWAY, INC.		3265+72	3271+00 NB	0.6A	N/A	DITCH				
B			16+02 RT	12+00 TR 43	0.1A 1A	N/A					
C			16+40 RT	12+51 TR 43	0.1A 1A	N/A					
			3283+42	3284+30 NB	0.45A 1A	N/A					
			3359+62	3364+60 NB	0.45A 1A	N/A					
			3357+30	3364+00 NB			SLOPE 0.22 AT SLOPE 200 SF SLOPE 400 SF				
341	JOHN HARRICK & JEANETTE L. GURNEY		3482+40	3482+70 NB	16.3A 1A	118.7A					6 NEW HOUSES
342	VEGA L. EDUARDO & MARCO A. MACHY		3294+93 NB	3299+00 SB	4.5A 1A	7.9A					
343	SEYMOUR R. & LINDA J. MORRIS		3290+60 NB	3303+00 SB	3.5A 1A	4.1A					
344	HARRY K. SHEPARD		3202+70 NB	3204+65 SB	1.5A 1A	0.8A					
345	ESSE MAZE		3204+05 NB	3312+02 NB	7.8A 1A	57.0A					
346	FRANK & BEATRICE MATTIE		3312+61	3316+30 NB	7.9A 1A	7.0A					HOUSE, GARAGE, SHED, WELL LOSS OF ACCESS (6.5A)

TABLE OF REVISIONS

REVISION NO.	SHEET NO.	DESCRIPTION OF REVISION	DATE	MADE BY	APPROVED BY
11		PARCEL 345 CHANGE TRADING LINE BETWEEN STA 3312+00 - 3312+00 TO 3312+00	11-9-04	MWG	
12		PARCEL 346 CHANGE TRADING LINE BETWEEN STA 3312+02 - 3316+31 TO 3312+02	11-9-04	MWG	

POOR ORIGINAL COPY

LEGEND

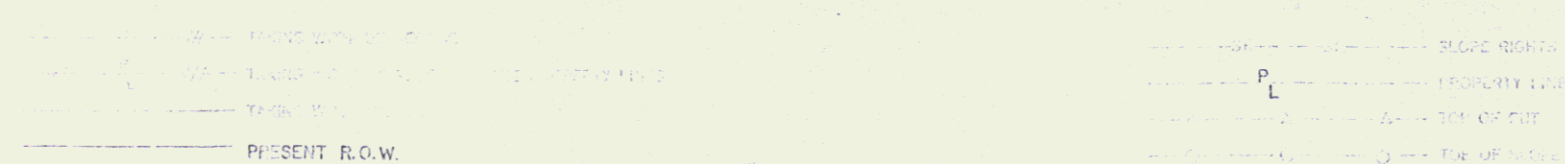

APPROVED: *Robt. C. Will* 8/20/04  
 APPROVED: *Ed. M. Pons* 8/10/02  
 APPROVED: *[Signature]* 8/22/02  
 ROCKINGHAM-WHITE RIVER JCT. 1-31-1(12)  
 HARTLAND-HARTFORD SECTION  
 SHEET 12  
 Contract # F Raw

*M. S. Jones* 8/1/03  
*[Signature]* 8/1/03