

\* THREE-CABLE GUARD RAIL W/  
STEEL POSTS - ITEM 543, 542  
3232+00 - 3239+00 NB RT  
3232+92 - 3239+00 SB-LT

\* BITUMINOUS CONCRETE CURB  
ITEM 555  
3233+50 - 3239+00 SB-LT

DEMOLITION / REMOVAL OF BUILDING  
ITEM 536  
3237+30 SB-LT SHED  
3237+00 SB-LT SAWMILL

SUB-BASE OF SAND, ITEM 207  
3223+00 - 3237+20 NB


PROPERTY LINE FENCE ITEM 563 D  
3220+00 - 3236+00 SB-LT  
3226+00 - 3234+00 NB RT

\* STAGE 2 CONSTRUCTION

CONTROL OF ACCESS COMPLETE ON THIS SHEET

SB	NB
Δ 21° 27' 45" LT	Δ 16° 55' 55" LT
D 2' 03' 11"	D 2' 00' 0"
R 2750.83	R 2864.79
T 520.00	T 426.41
L 1045.42	L 876.60
E 47.68	E 31.56
Bnk. 1/8 per ft.	Bnk. 1/8 per ft.

Conc. Arch Culvert Designed  
by Bridge Dept.  
See Sheets Br. 100 thru Br. 110  
for Details

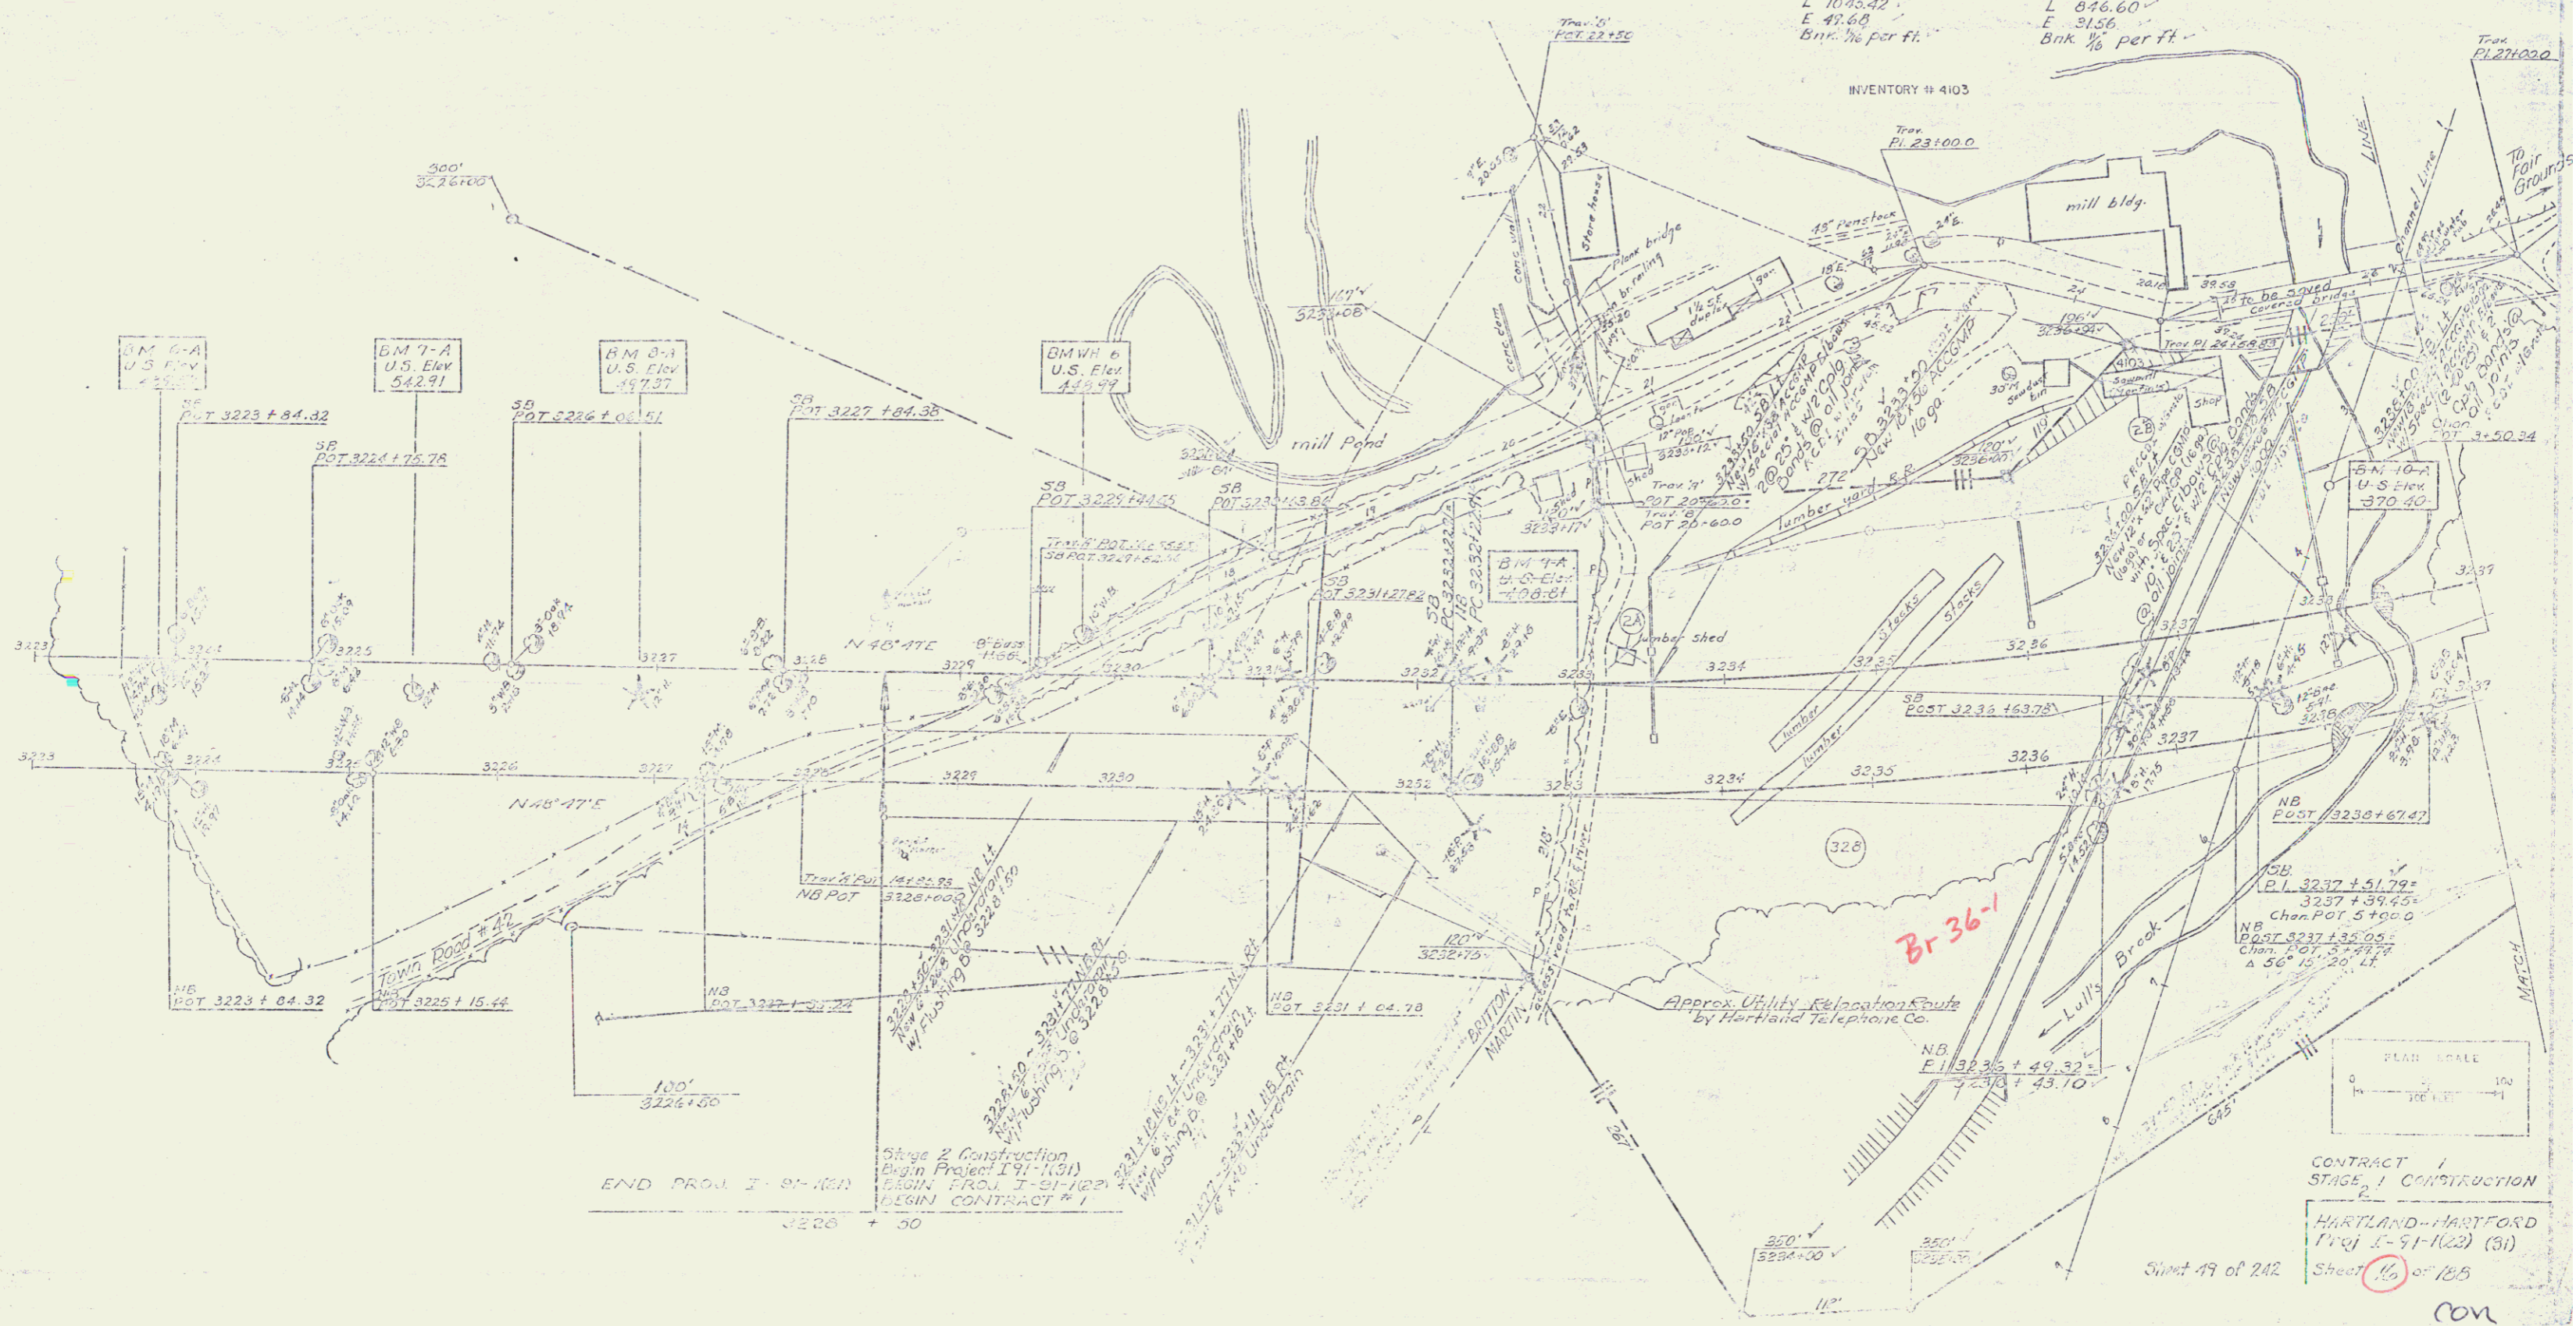

END PROJ. I - 91-102  
3228 + 50

Stage 2 Construction  
Begin Project I 91-102  
Begin Proj. I - 91-102  
Begin Contract # 1

CONTRACT 1  
STAGE 1 CONSTRUCTION

HARTLAND-HARTFORD  
Proj. 91-102 (31)

Sheet 16 of 18B

con

9