


TRILLIS & HENNINGER
 1000 W. MAIN ST. HARTFORD, CT
 NB 3259-4 - 3271-4

CONTROL OF SAND, ITEM 202
 3256+75 - 3259+75 NB
 3258+75 - 3263+75 SB
 3265+75 - 3271+00 NB

MUCK EXCAVATION, ITEM 116
 3250+75 - 3255+75 SB
 3262+75 - 3265+75 NB
 3265+75 - 3269+75 SB

PROPERTY LINE FENCE ITEM 563-B
 3257+00 - 3258+00 SB RT
 3263+00 - 3271+00 SB LT
 3257+00 - 3271+00 NB RT

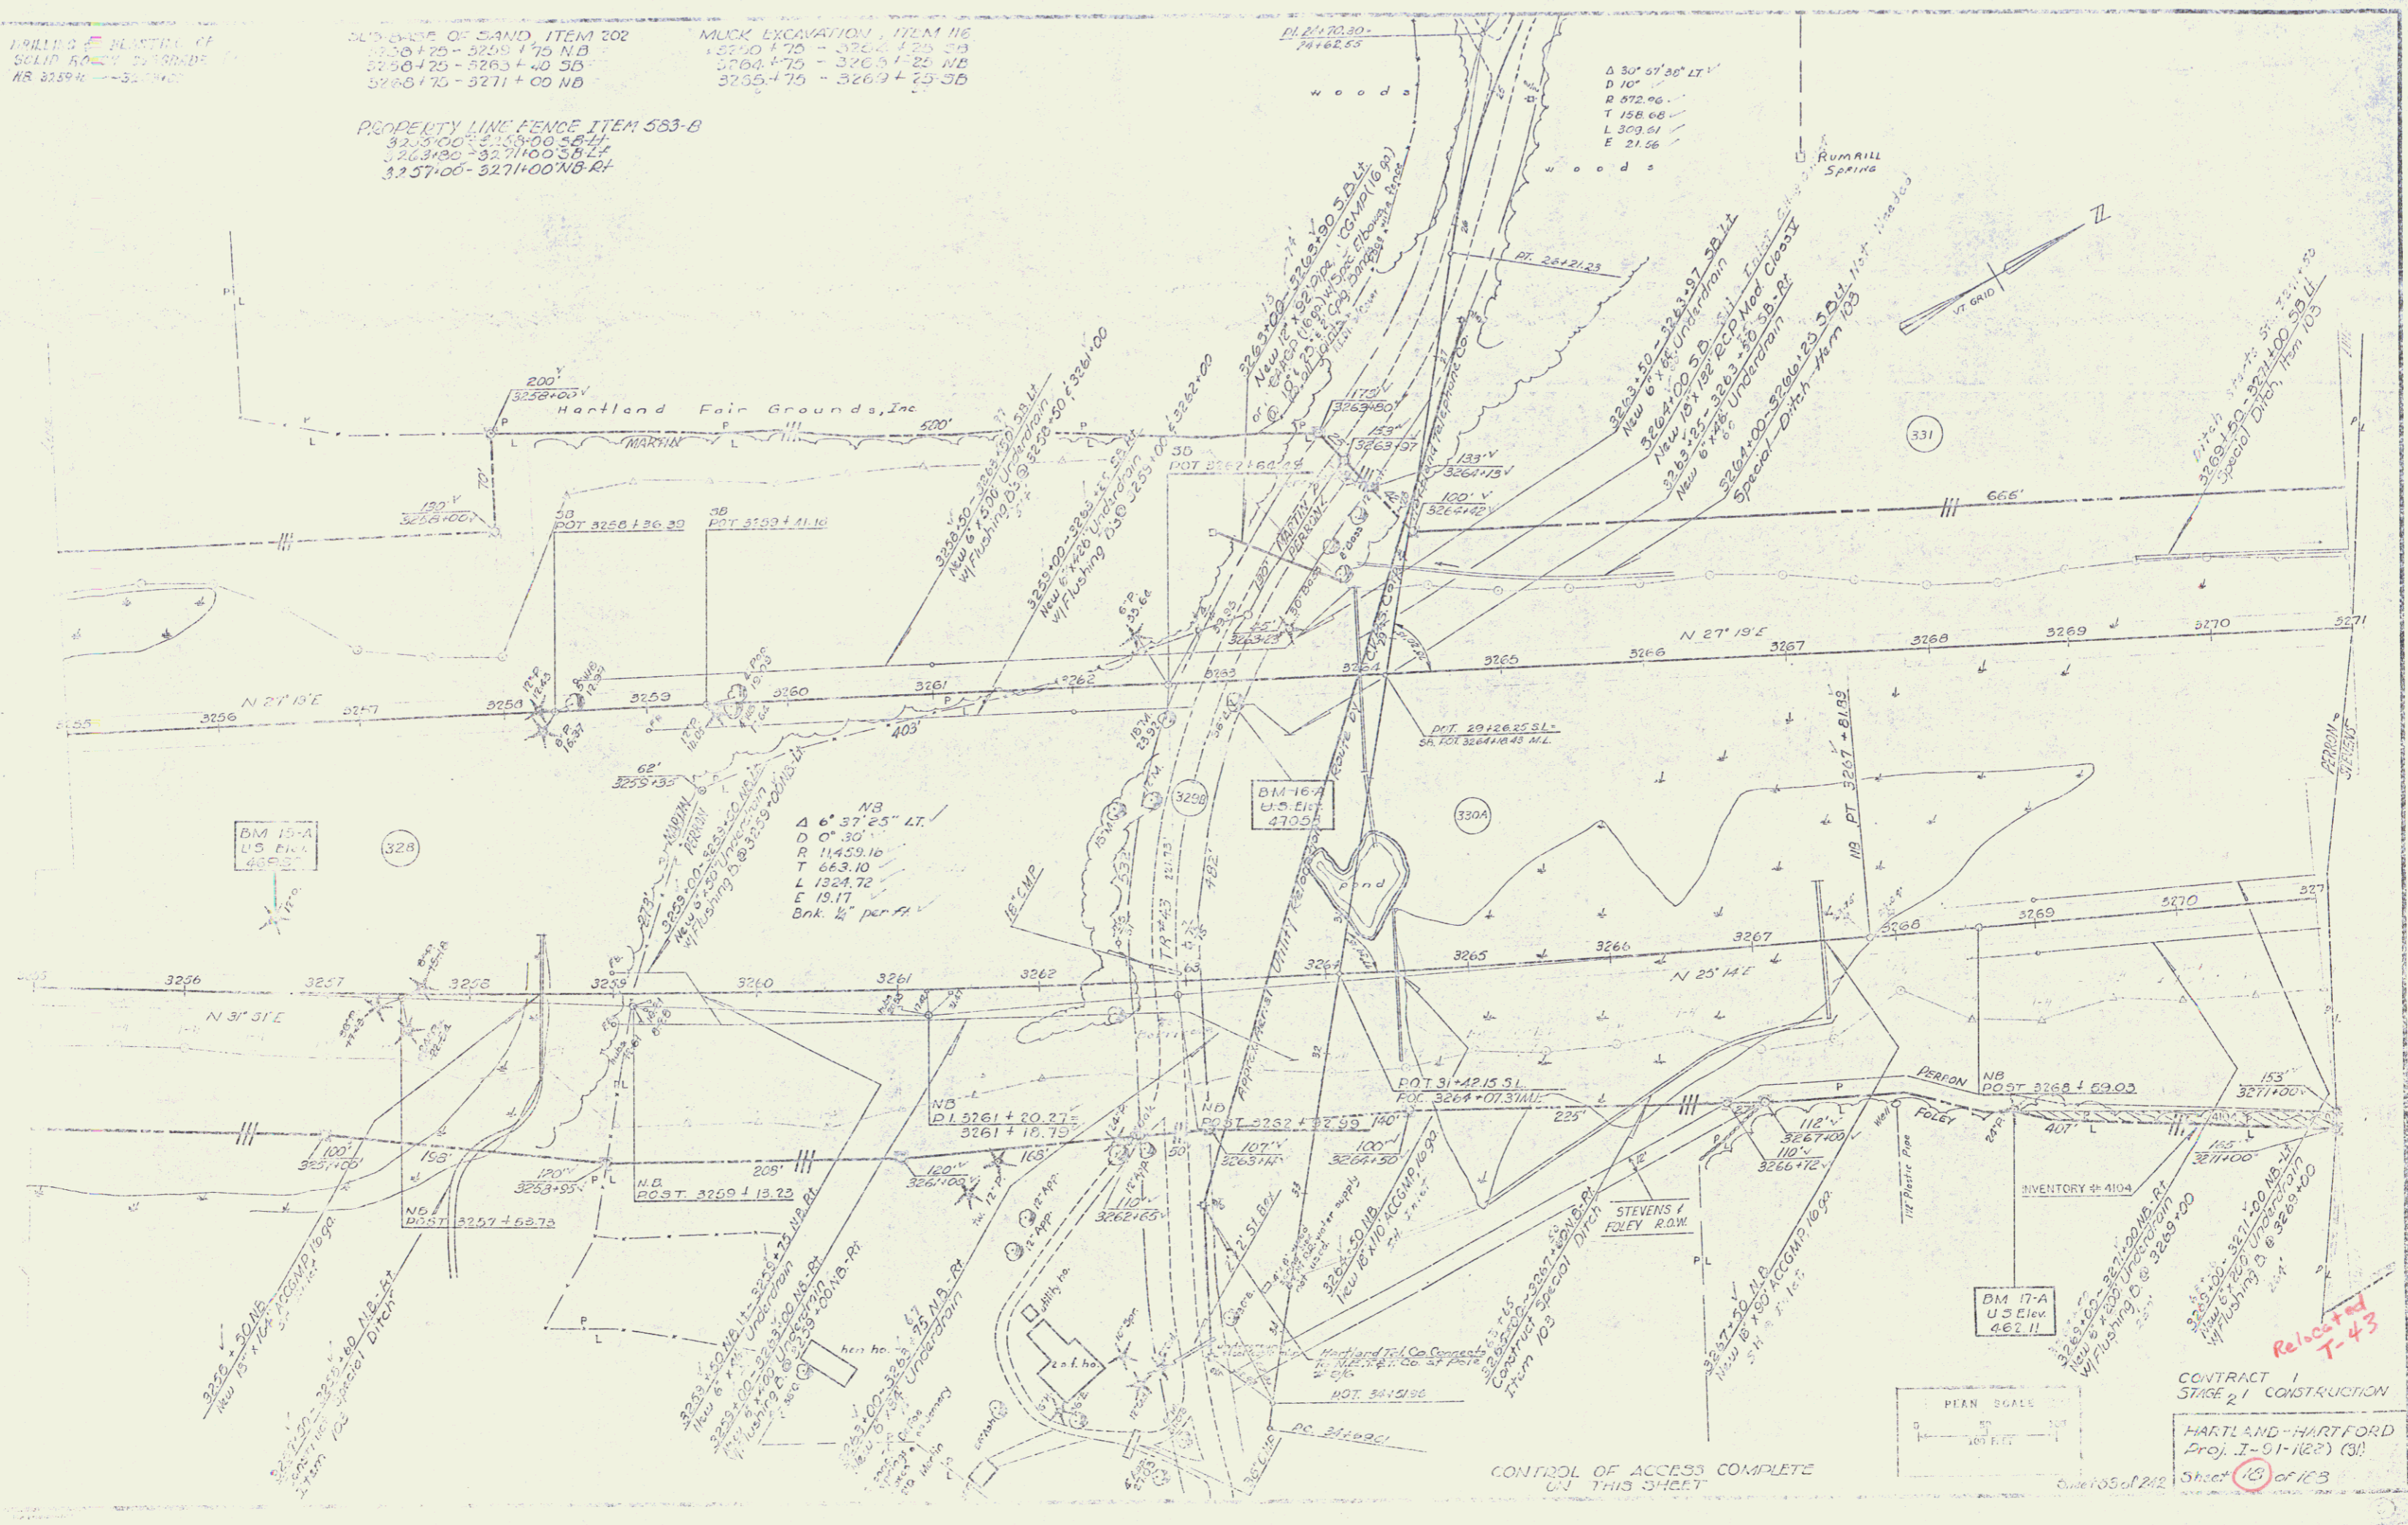

CONTRACT 1
 STAGE 2 CONSTRUCTION
 HARTLAND-HARTFORD
 Proj. I-91-102? (3)
 Sheet 25 of 103