


STONE FILL FOR E.A.W. PROTECTION
 ITEM 522
 3285+43 NB LT - 3285+43 MB LT
 3285+50 NB RT - 3285+50 MB RT

THREE RAIL GUARD RAIL W/
 ITEM 532
 3287+00 - 3282+75 NB - RT
 3289+45 - 3281+05 NB - LT
 3289+24 - 3280+60 SB - RT


PROPERTY LINE FENCE ITEM 563-B
 3287+00 - 3303+00 SB - LT
 3287+00 - 3287+00 NB - RT

* BITUMINOUS CONCRETE CURB
 ITEM 533
 3289+50 - 3291+00 NB - LT

* STAGE 2 CONSTRUCTION

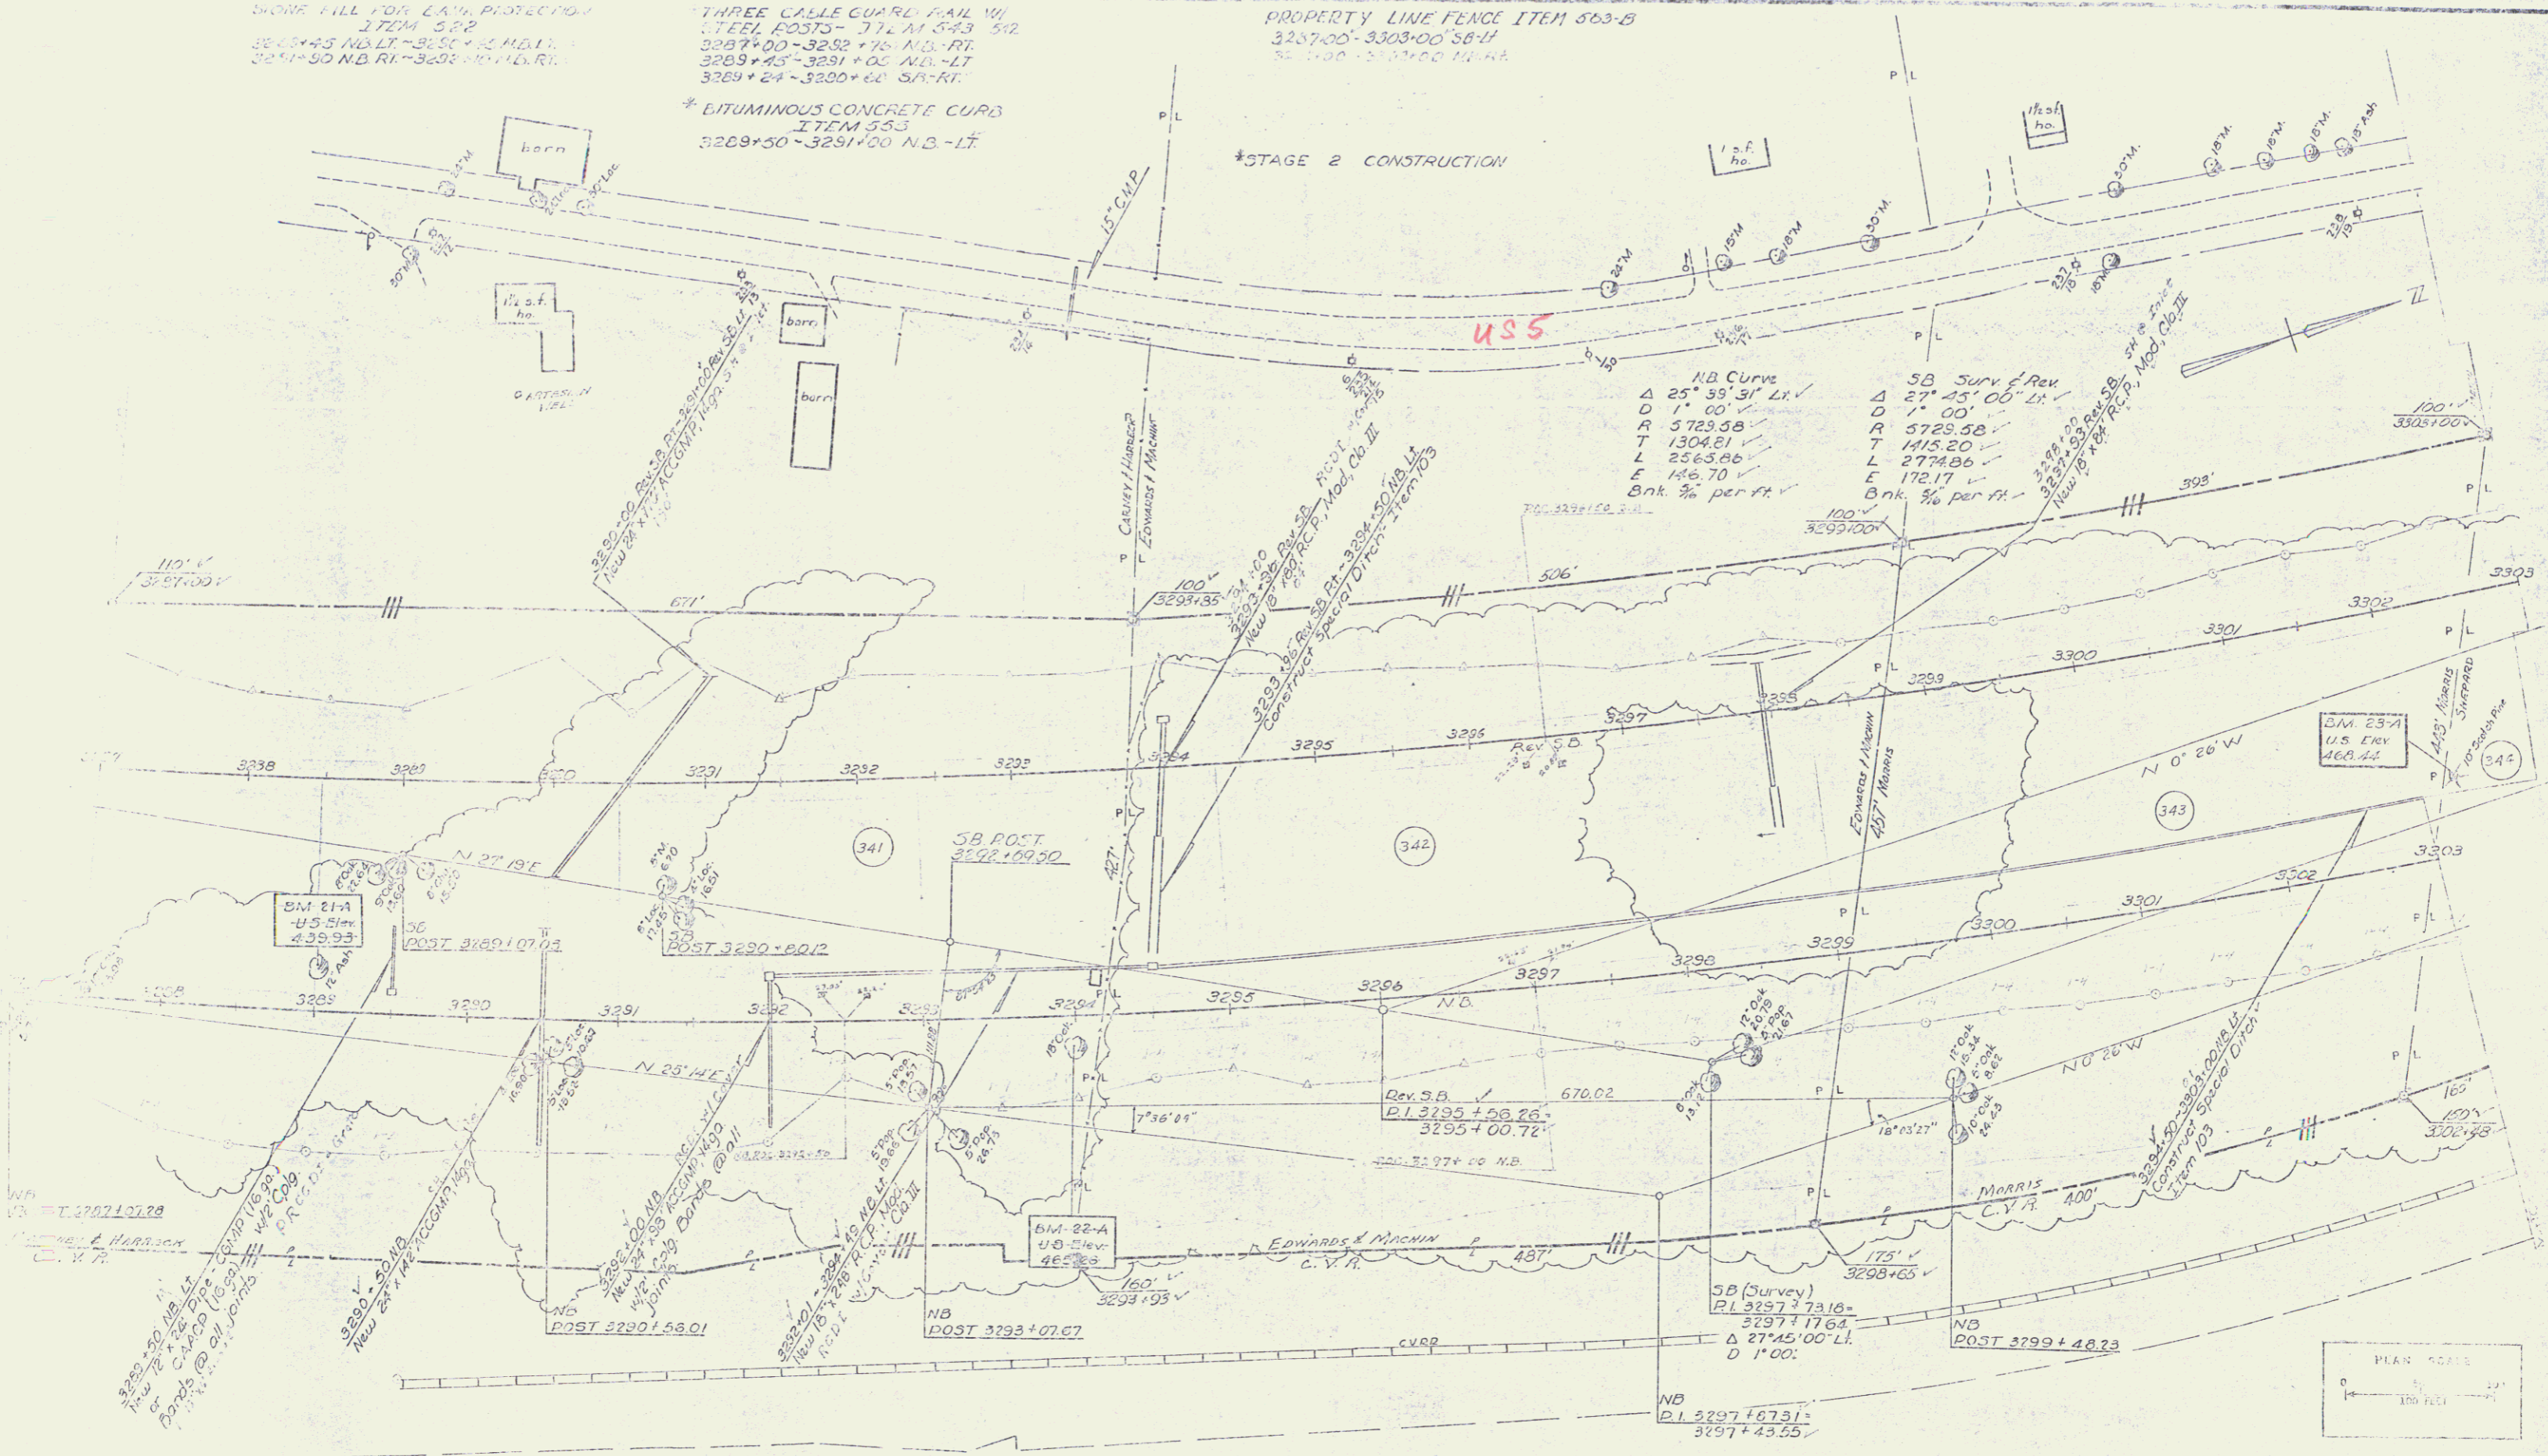

W.P.
 V.S. T. 220210728
 HARRISON
 C.V.P.

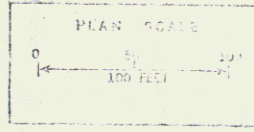

CONTRACT 1
 STAGE 1 CONSTRUCTION
 HARTLAND-HARTFORD
 Proj. I-91-(22) (01)
 Sheet 20 of 188
 Sheet 57 of 212

CONTROL OF ACCESS COMPLETE
 ON THIS SHEET