


* THREE CASLS GUARD RAIL
w/STEEL POSTS, ITEM 513 542
NB 3307+00-3311+66 (ahead) DI

* STAGE 2 CONSTRUCTION

PROPERTY LINE FENCE
w/STEEL POSTS, ITEM 583-B
SB 3307+00'- 3319+00' L
NB 3307+00'- 3318+00' R
S.D. Curve Data NB Curve Data
Δ 27° 45' 00" L Δ 25° 53' 31" L
D 1' D 1'
R 5729.58 T 1304.81
L 1415.20 T 2345.86
L 2774.86 E 146.58
Cnt. % 111. Cnt. % 111.

JUTE MATTING, ITEM 623
NB 3312+55- 3313+45 74'

DEMOLITION and REMOVAL of
BUILDING, ITEM 596
NB 3313+70

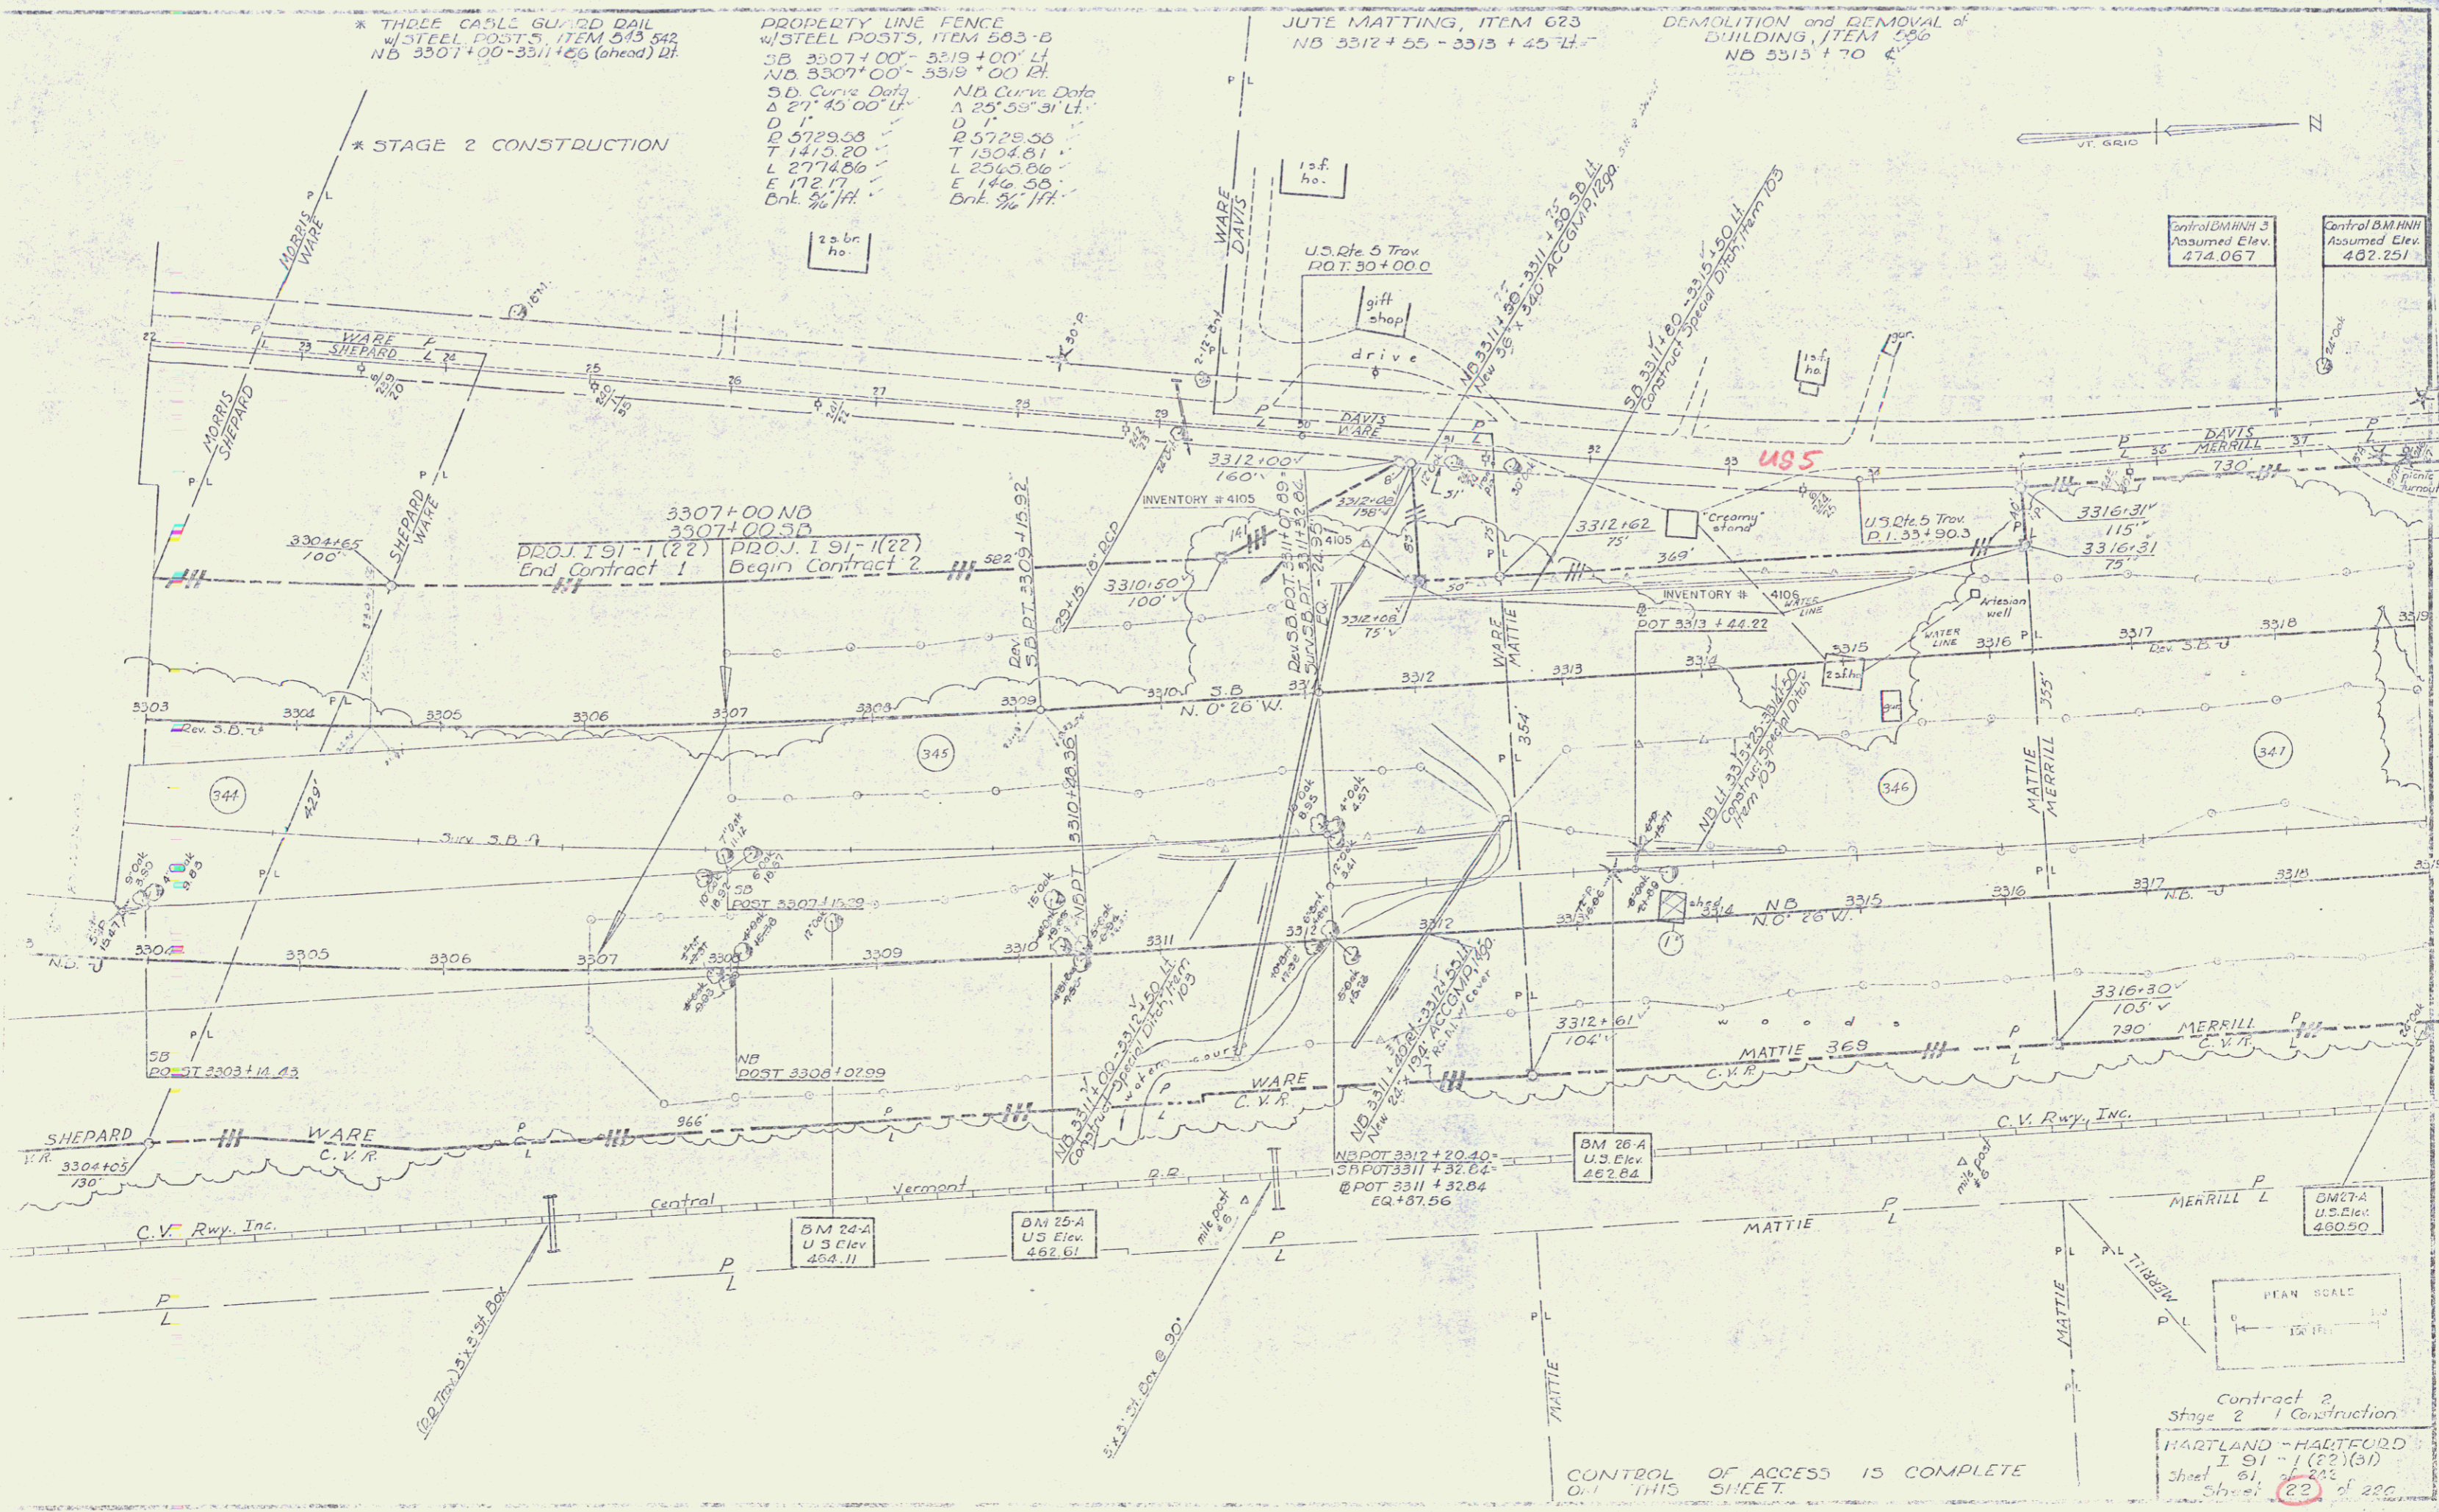

CONTROL OF ACCESS IS COMPLETE
D-1 1115 SHEET.

Contract 2
Stage 2 Construction
HARTLAND - HARTFORD
I 91-1(22)(31)
Sheet 61 of 222
Sheet 22 of 222