

PROPERTY LINE FENCE
W/ STEEL POSTS, ITEM 533-D
3351+00 - 3366+00 S.B. Lt.
3351+00 - 3366+00 N.B. Rt.

STANDARD STEEL BEAM GUARD
RAIL W/ STEEL POSTS, ITEM 547-A 515-A
3366+53' - 3367+00 S.B. Lt.
437+50

DEMOLITION and REMOVAL
of BUILDING, ITEM 500
N.B. 3361+75 Lt.
S.B. 3362+80 Lt.
S.B. 3363+30 Lt. - sold

BITUMINOUS CUTTER, USING
ITEM 534
3363+50 - 3367+00 S.B. Rt.
3364+50 - 3364+50 N.B. Lt.

JUTE MATTING, ITEM 623
3363+50 - 3367+00 N.B. Lt.

*STAGE 2 CONSTRUCTION
440+00
75'

3351
3352
3353

N.E.P. Co.

Central Vermont Railroad

C.V. Rwy., Inc.

N.E.P. Co.

CONTROL OF ACCESS IS COMPLETE
ON THIS SHEET.

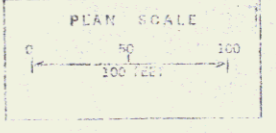

Contract 2
Stage 2 Construction
HARTLAND - HARTFORD
I-91-102(31)
Sheet 25 of 220
Sheet 67 of 712