


N.B.  
 P.I. 3403 + 28.88'  
 5471 + 04.35'  
 04.76'

(356)

wooded

GOODWIN  
 C. V. Rwy. INC.

concrete tower  
 signal post

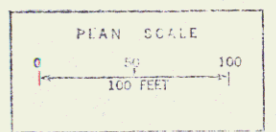

CONTROL OF ACCESS IS COMPLETE  
 ON THIS SHEET.

Contract 2  
 Stage 21 Construction  
 HARTLAND - HARTFORD  
 I-91-1(22) (51)  
 Sheet 35 of 220  
 Sheet 72 of 222

24