

STONE FILL FOR SLOPE PROTECTION, ITEM 522
NB 3447+00 - 3448+50 LT
SB 3451+24 - 3451+55 LT

HYDRANT CONCRETE CURB, ITEM 555
NB 3447+00 - 3448+50 RT
SB 3451+24 - 3451+55 LT

DRILLING AND BLASTING OF SOLID ROCK SUB-GRADE, ITEM 114
3452+50 - 3458+80 LT

THREE CABLE GUARD RAIL RAIL WITH STEEL POSTS, ITEM 1542
NORTHBOUND
3447+00 - 3448+60 RT
SOUTHBOUND
3450+55 - 3451+85 RT



JUTE MATTING, ITEM 623
3448+00 - 3449+85 MED
3451+70 - 3453+50 MED
3458+25 - 3460+00 MED
3462+00 - 3463+00 MED
3451+75 - 3453+50 RT NB
3451+75 - 3453+50 LT SB

PROPERTY LINE FENCE WITH STEEL POSTS, ITEM 683-0
NORTHBOUND
3454+50 - 3463+00
SOUTHBOUND
3456+50 - 3463+00

GRANULAR BORROW, ITEM 102-A
3450+50 - 3453+25

DRILLING AND PREFRUITING OF SOLID ROCK, ITEM 125
SB 3454+00 - 3454+80 RT


DRILLING AND PREFRUITING OF SOLID ROCK, ITEM 125
3454+00 - 3454+80 RT

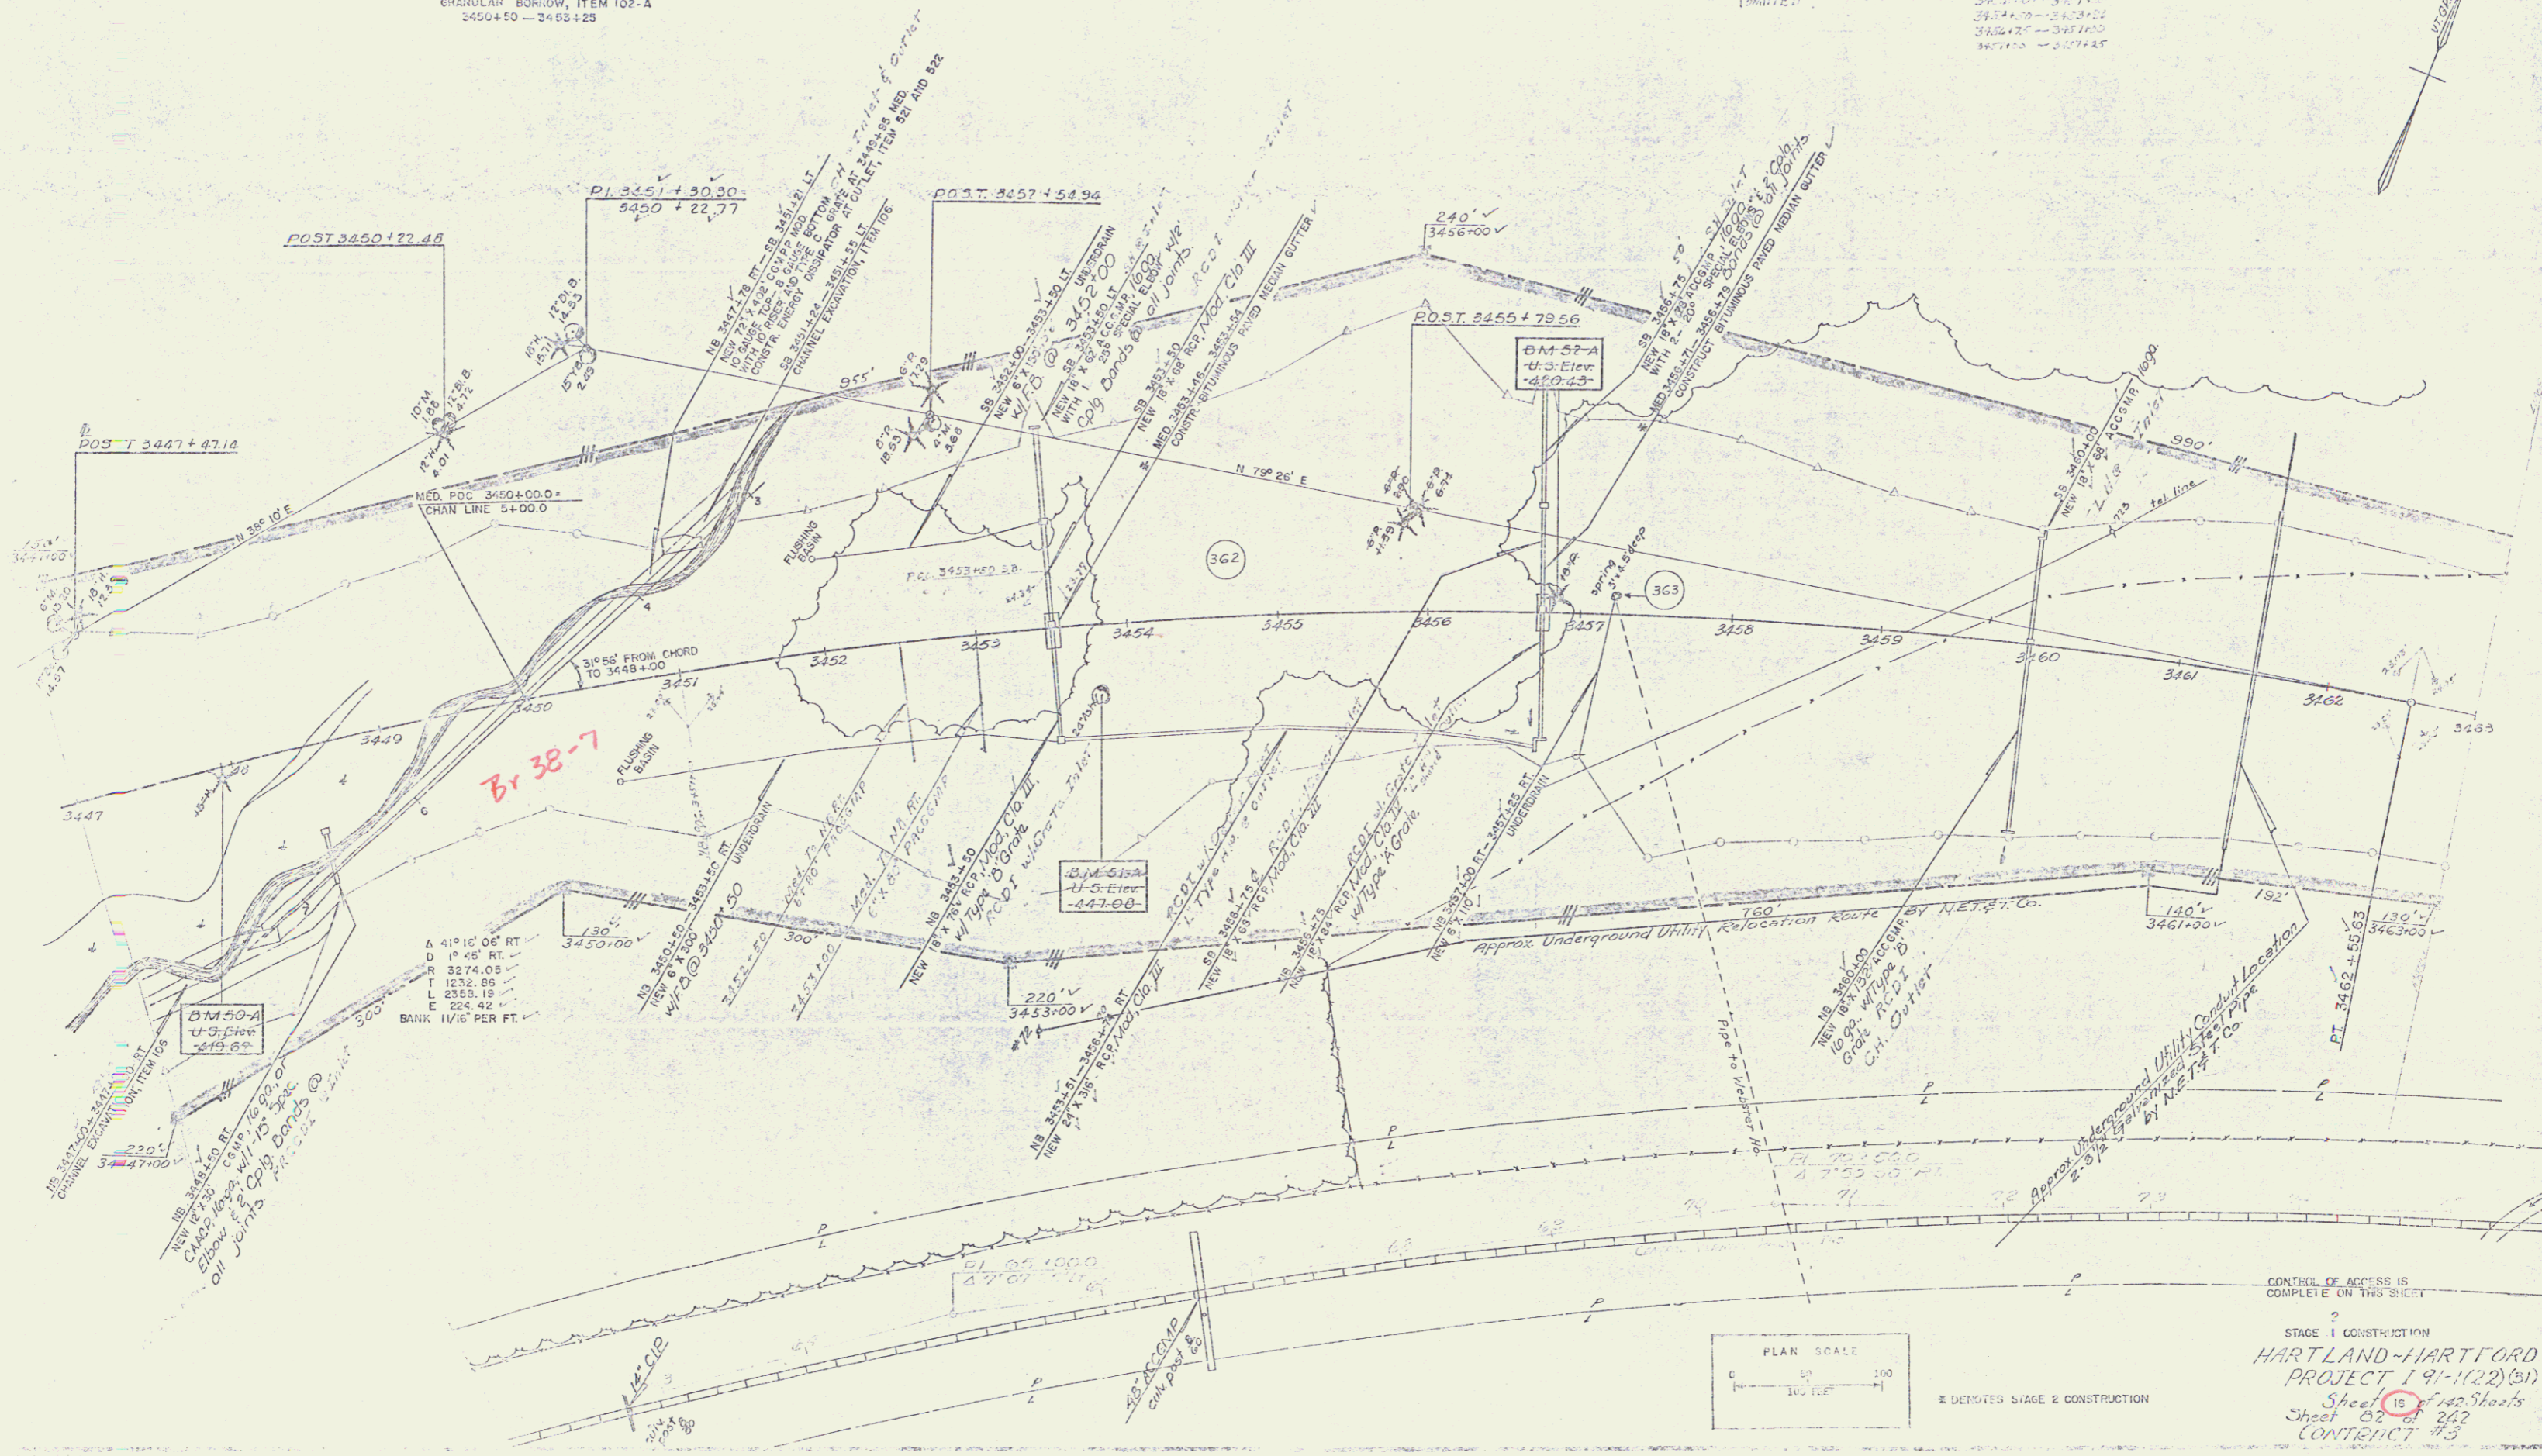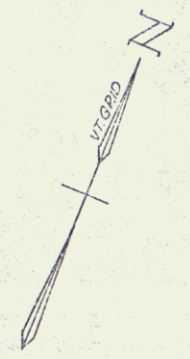

DM 50-A
U.S. Elev.
449.87

DM 50-A
U.S. Elev.
447.00

DM 57-A
U.S. Elev.
450.43

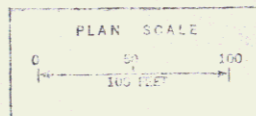

DEPOTES SVAGE & CONSTRUCTION

CONTROL OF ACCESS IS COMPLETE ON THIS SHEET
STAGE 1 CONSTRUCTION
HARTLAND-HARTFORD PROJECT 191-1(22)(B1)
Sheet 16 of 42 Sheets
Sheet 02 of 242
CONTRACT 193