


HARTLAND Vol Fire Dept  
 I 91 Emergency Access Agreement  
 March 9, 1994 BK 99 Pg 409-412

POOR ORIGINAL COPY

PROPERTY LINE FENCE WITH STEEL POSTS, ITEM 583  
 3503+00 RT SOUTHBOUND 3495+00-3711+00  
 DEMOLITION AND REMOVAL OF BUILDINGS, ITEM 584  
 3503+00 RT 3503+00 RT 2 R.R. HOUSE SOLD

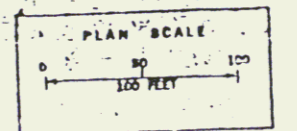

CONTROL OF ACCESS IS COMPLETE ON THIS SHEET  
 2  
 STAGE 1 CONSTRUCTION  
 HARTLAND-HART  
 PROJECT I 91-11  
 Sheet 37 of 42  
 CONTRACT 87-2  
 SHEET 37 OF 42

8 DENOTES STAGE 2 CONSTRUCTION