
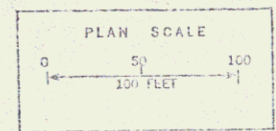


PROPERTY LINE FINISHED WITH STAKE POSITIONS, ITEM #15
NORTHBOUND 3511+00 - 3516+00
SOUTHBOUND 3511+00 - 3516+00

THREE-GRADE CHANGING RAIL WATERL. POSITIONS, ITEM #16 & 17
SOUTHBOUND 3514+77 - 3519+00

STONE FILL FOR SLOPE PROTECTION, ITEM #22
NORTHBOUND 3513+00 - 3516+00 ST.

Top of last	Bottom	Date	Drawn
Markings	Markings	10-26-74	50/10/10

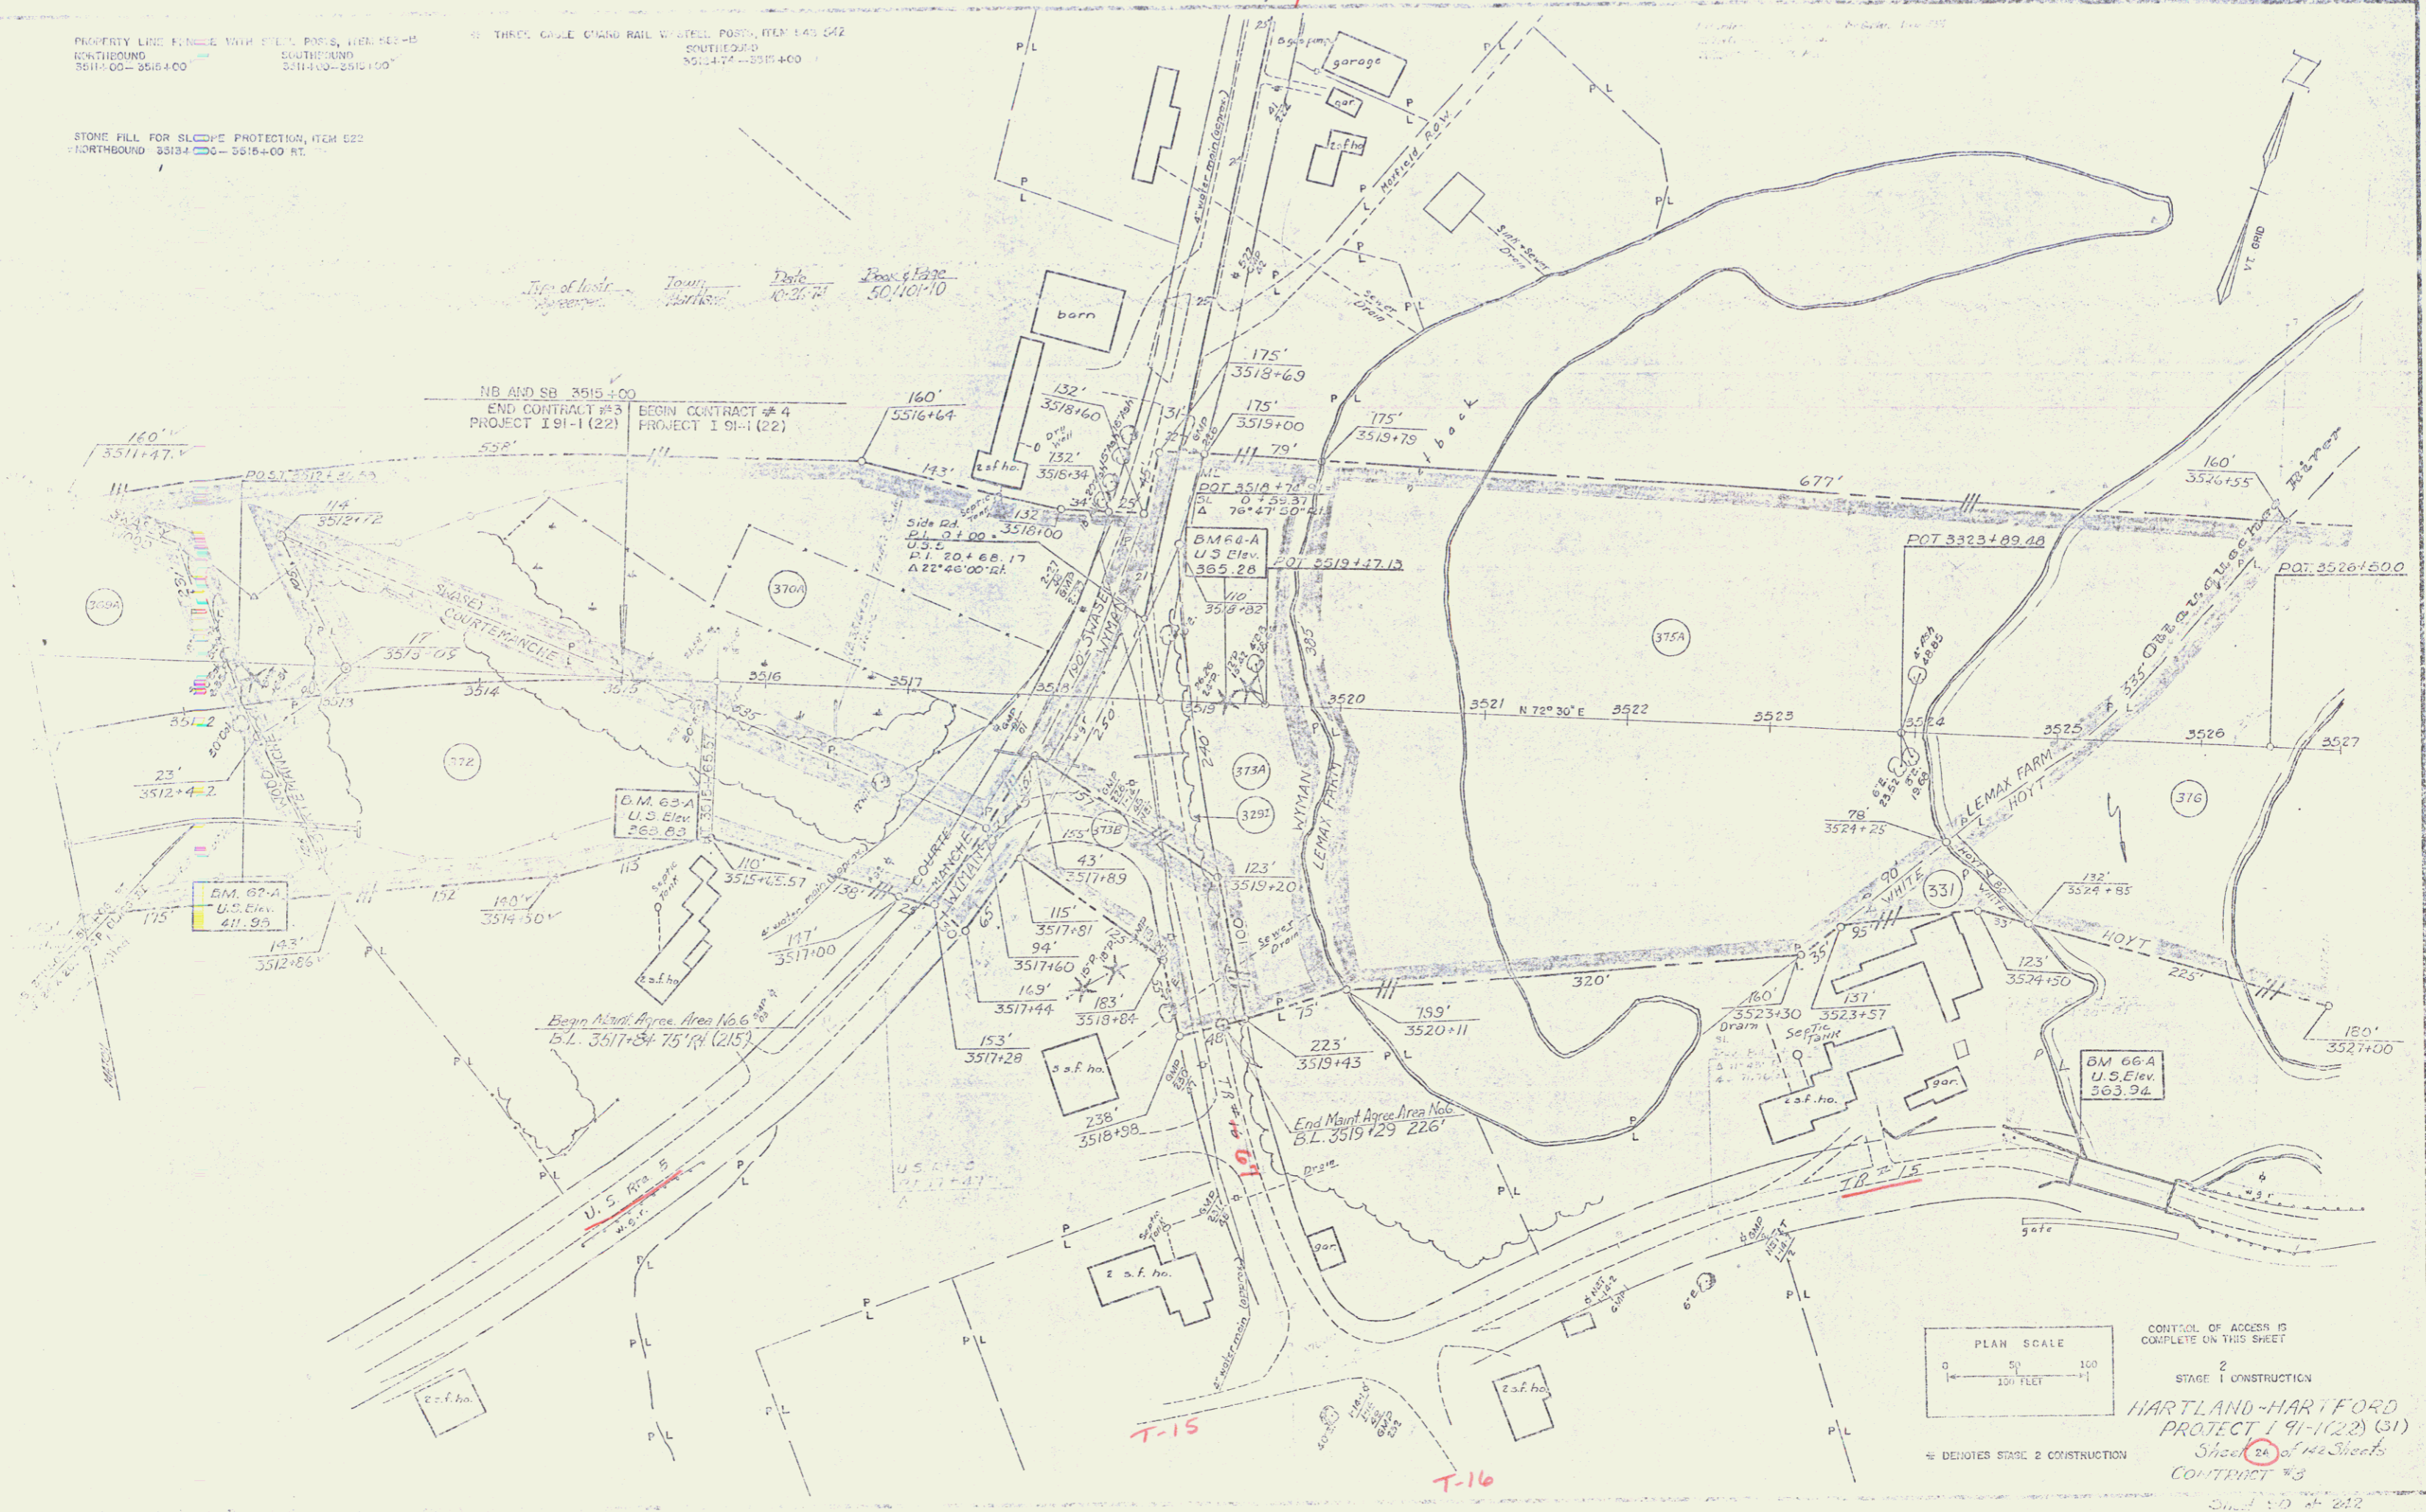

CONTROL OF ACCESS IS COMPLETE ON THIS SHEET
STAGE 1 CONSTRUCTION
HARTLAND-HARTFORD PROJECT 191-1(22) (31)
Sheet 24 of 142 Sheets
CONTRACT #3
SHEET NO. 24