

\* THESE CABLE GUARD RAIL, RAIL POSTS  
ITEM 523-524

NB 3514+07 - 3516+00 LT  
SB 3516+00 - 3517+30 LT  
NB 3517+30 - 3518+00 LT

NB 3510+72 - 3512+20 LT  
SB 3512+20 - 3513+10 LT  
SB 3513+10 - 3514+20 LT  
NB 3522+20 - 3524+20 LT

STANDARD STEEL BEAM GUARD  
RAIL, 4" STEEL POSTS, ITEM 523-A

THIS 0" x 5" L - SB 3518+65 LT  
NB 3518+65 LT - SB 3517+47 LT  
NB 3516+71 LT - SB 3514+06 LT  
NB 3524+20 LT - SB 3524+20 LT

PROPERTY LINE TOWER TOWER POSTS  
ITEM 525


SB 3515+00 - 3517+00 LT  
NB 3515+00 - 3517+10 LT  
NB 3518+00 - 3519+30 LT  
SB 3518+65 - 3524+20 LT  
NB 3526+50 - 3527+00 LT  
SB 3527+00 - 3528+10 LT

\* BITUMINOUS CONCRETE CURB  
ITEM 525

NB 3515+00 - 3516+00 LT  
NB 3516+70 - 3518+70 LT  
BOUNDARY MARKERS  
ITEM 567  
Med. 3521+00 (203' LH)

CONDUIT ATTACHMENT  
0.5" x 6" 19# RS 61  
Side line @ 53.17'

\* JUTE MATTING, ITEM 623  
Med. 3519+00 - 3523+00

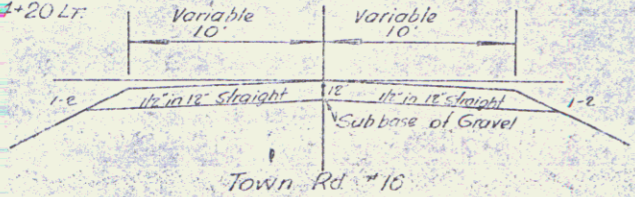

SPIRAL CURVE DATA		CIRCULAR CURVE DATA	
Δ	27°01'55" RT	Δ	35°31'55" LH
D	3° 00' 00"	D	3° 00' 00"
R	38' 10' 00"	R	1909.06'
L	250.00'	T	611.96'
T	737.95'	L	1107.43'
P	1.50'	E	95.64'
X	127.00'		
Y	249.00'		
Z	5.65'		
LT	168.10'		
ST	60.37'		
LC	0.95'		
Lc	0.54 10'		
Bank	4% to 12%		

Contract 4  
Stage 2 Construction  
HARTLAND-HARTFORD  
I 91-1-100  
Sheet 92 of 102  
Indicates Stage 2 Construction Sheet 9 of 102