

* THREE CHAIN CURVE DATA
ITEM 342
SB 3527+00 - 3530+00 LT
SB 3527+10 - 3533+10 RT
NB 3527+70 - 3539+54 PL
NB 3536+06 - 3540+00 LT

* STANDARD STEEL BEAM GUARD RAIL
* STEEL POSTS, ITEM 543-A
NB 3527+00 - SB 3527+70 PL

PENNY LANE SIDE 4" STEEL PIPES
ITEM 500-B
NB 3527+00 - 3540+00 PL
SB 3527+06 - 3540+02 LT


* BITUMINOUS CONCRETE CURB
ITEM 300
SB 3527+70 - 3540+02 LT

* JUNGLE MATING
ITEM 503
MEDIAN 3536+50 - 3540+00

NOTE: CONTROL OF ACCESS IS COMPLETE ON THIS SHEET

CIRCULAR CURVE DATA
Δ 55° 36' 11" LT
D 3' 0" RT
R 1909.66'
T 1007.06'
L 1253.49'
E 249.25'

SPIRAL CURVE DATA
Δ 45° 00' 11" LT
Lc 8° 00' 00"
Cc 3° 45' 00"
Ls 250.00'
Ts 1182.78'
Lc 249.95'
Ls 136'
Xs 124.93'
Ys 249.93'
Zs 5.15'
Lx 1166.70'
Lc 249.95'
Ls 1603.49'
Bank 1/4" in 12"

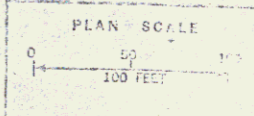

Type of Ins't. Agreement: _____
Town: Hartford
Date: 10-26-74
Book & Page: 50 110-10

Stage 2 Construction
HARTLAND - HARTFORD

* Indicates Stage 2 Construction

3-91-1 (31)
Sheet 11 of 20?
Sheet 11 of 10?