

PLAN
 SHEET NO. 21
 PROJECT NO. 102
 DATE 11/10/00
 DRAWN BY [illegible]
 CHECKED BY [illegible]

DRILLING & BLASTING of SOLID ROCK
 ITEM 113
 NB 3575+00 - 3580+00
 SB 3584+00 - 3590+00
 3584+00 - 3591+00

DRILLING & BLASTING of SOLID ROCK
 SUBGRADE ITEM 114 Mod
 NB 3575+00 - 3579+00 RT
 SB 3584+00 - 3591+00

BITUMINOUS CONCRETE CURB ITEM 565 *
 SB 3582+00 - 3589+00 LT

JUTE MATTING ITEM 623
 * Med 3590+00 - 3591+00

THREE CABLE GUARD RAIL
 w/ STEEL POSTS, ITEM 642 *
 NB 3575+00 - 3579+00 RT
 SB 3582+00 - 3589+00 LT

Note Control of Access is Complete on This Street


DRILLING & BLASTING OF SOLID ROCK, ITEM 115
 NB 3575+00 - 3580+00 SB LT
 SB 3575+00 - 3576+00 NB LT
 SB 3577+36 - 3580+00 NB LT
 SB 3585+60 - 3590+00 NB LT
 SB 3587+25 - 3589+00 SB RT

Spiral Curve Data
 Δc 33°19'30"
 Dc 3'
 Lc 250.00
 Tc 836.27
 Pc 1.36
 Xc 249.89
 Yc 5.45
 LT 166.70
 ST 88.37
 LC 249.95
 Lc 110.83
 bank 1/16" / 12"

Circular Curve Data
 Δ 40°49'30" LT
 D 3'
 Q 1909.86'
 T 710.78'
 L 1360.89'
 Δ 127.98'

PROPERTY LINE FENCE (Steel Posts)
 ITEM 563-B
 NA 3575+00 - 3581+50 RT
 Paid for on stage 1
 To be const. Stage 2
 SB 3585+00 - 3591+00 LT

BOUNDARY MARKERS
 ITEM 567
 NB 3585+00 (215' RT)
 SB 3588+00 (150' LT)
 Above markers to be tied to existing Town Line marker on T.H. 15

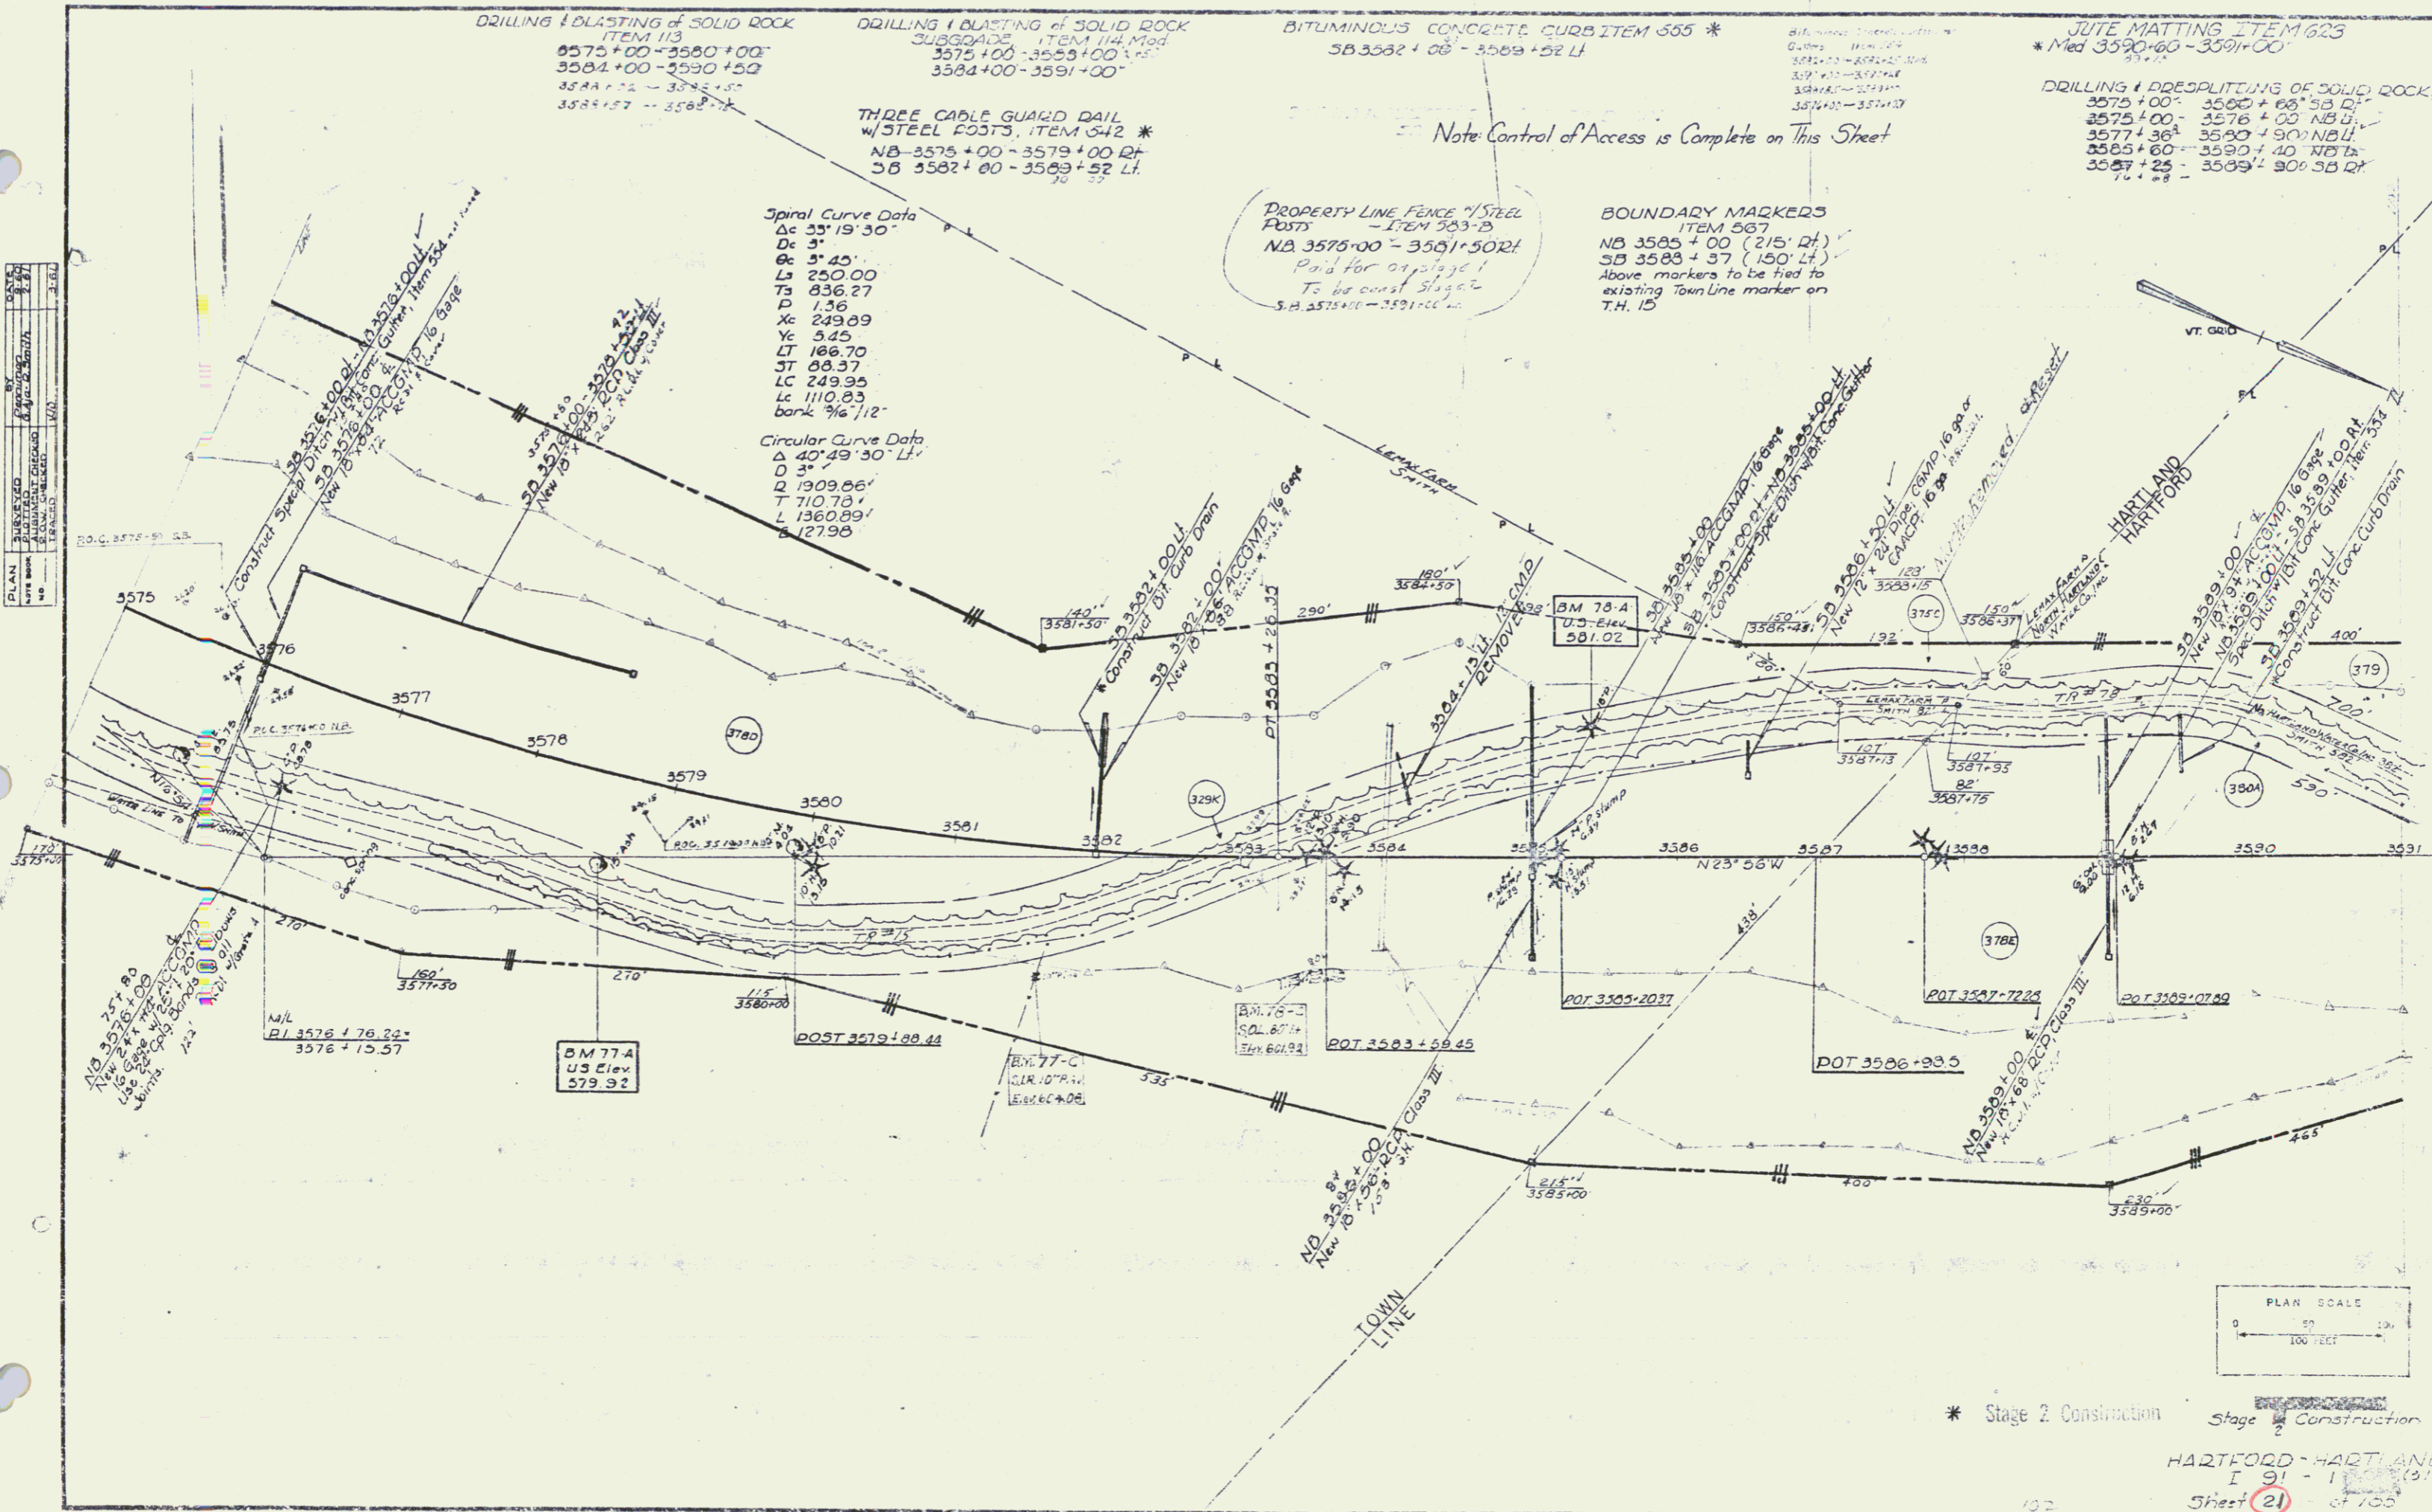

* Stage 2 Construction

HARTFORD-HARTLAND
 I 91 - 1
 Sheet 21 of 31
 Sheet 102 of 302