

DATE	NO.
PLAN	1
REVISIONS	
APPROVED	
BY	
DATE	
NO.	
DATE	
NO.	
DATE	
NO.	

STONE FILL FOR SLOPE PROTECTION
ITEM 322
S.B. 3654+00-3655+00 RT.

*THREE CABLE GUARD RAIL
W/ STEEL POSTS ITEM 342
S.B. 3654+00-3663+00 RT.
S.B. 3654+00-3666+04 LT
N.B. 3659+00-3661+05 LT



DRILLING and BLASTING of SOLID ROCK
SUBGRADE ITEM 114 Mod.
N.B. 3654+00-3657+00
N.B. 3658+50-3661+50
N.B. 3665+50-3669+00
S.B. 3660+50-3669+00

DRILLING and BLASTING of SOLID ROCK
ITEM 113
N.B. 3659+00-3661+20

PROPERTY LINE FENCE w/ STEEL POSTS
ITEM 303-B
S.B. 3654+00-3664+34 LT
N.B. 3654+00-3660+73 RT
S.B. 3655+00-3669+00 LT

Standard Steel Beam Guard Rail
w/ Steel Posts ITEM 342-A
3656+10-3657+75 N.B. RT.

Note: Control of Access is Complete on This Sheet

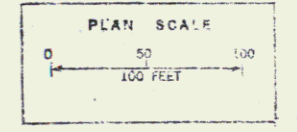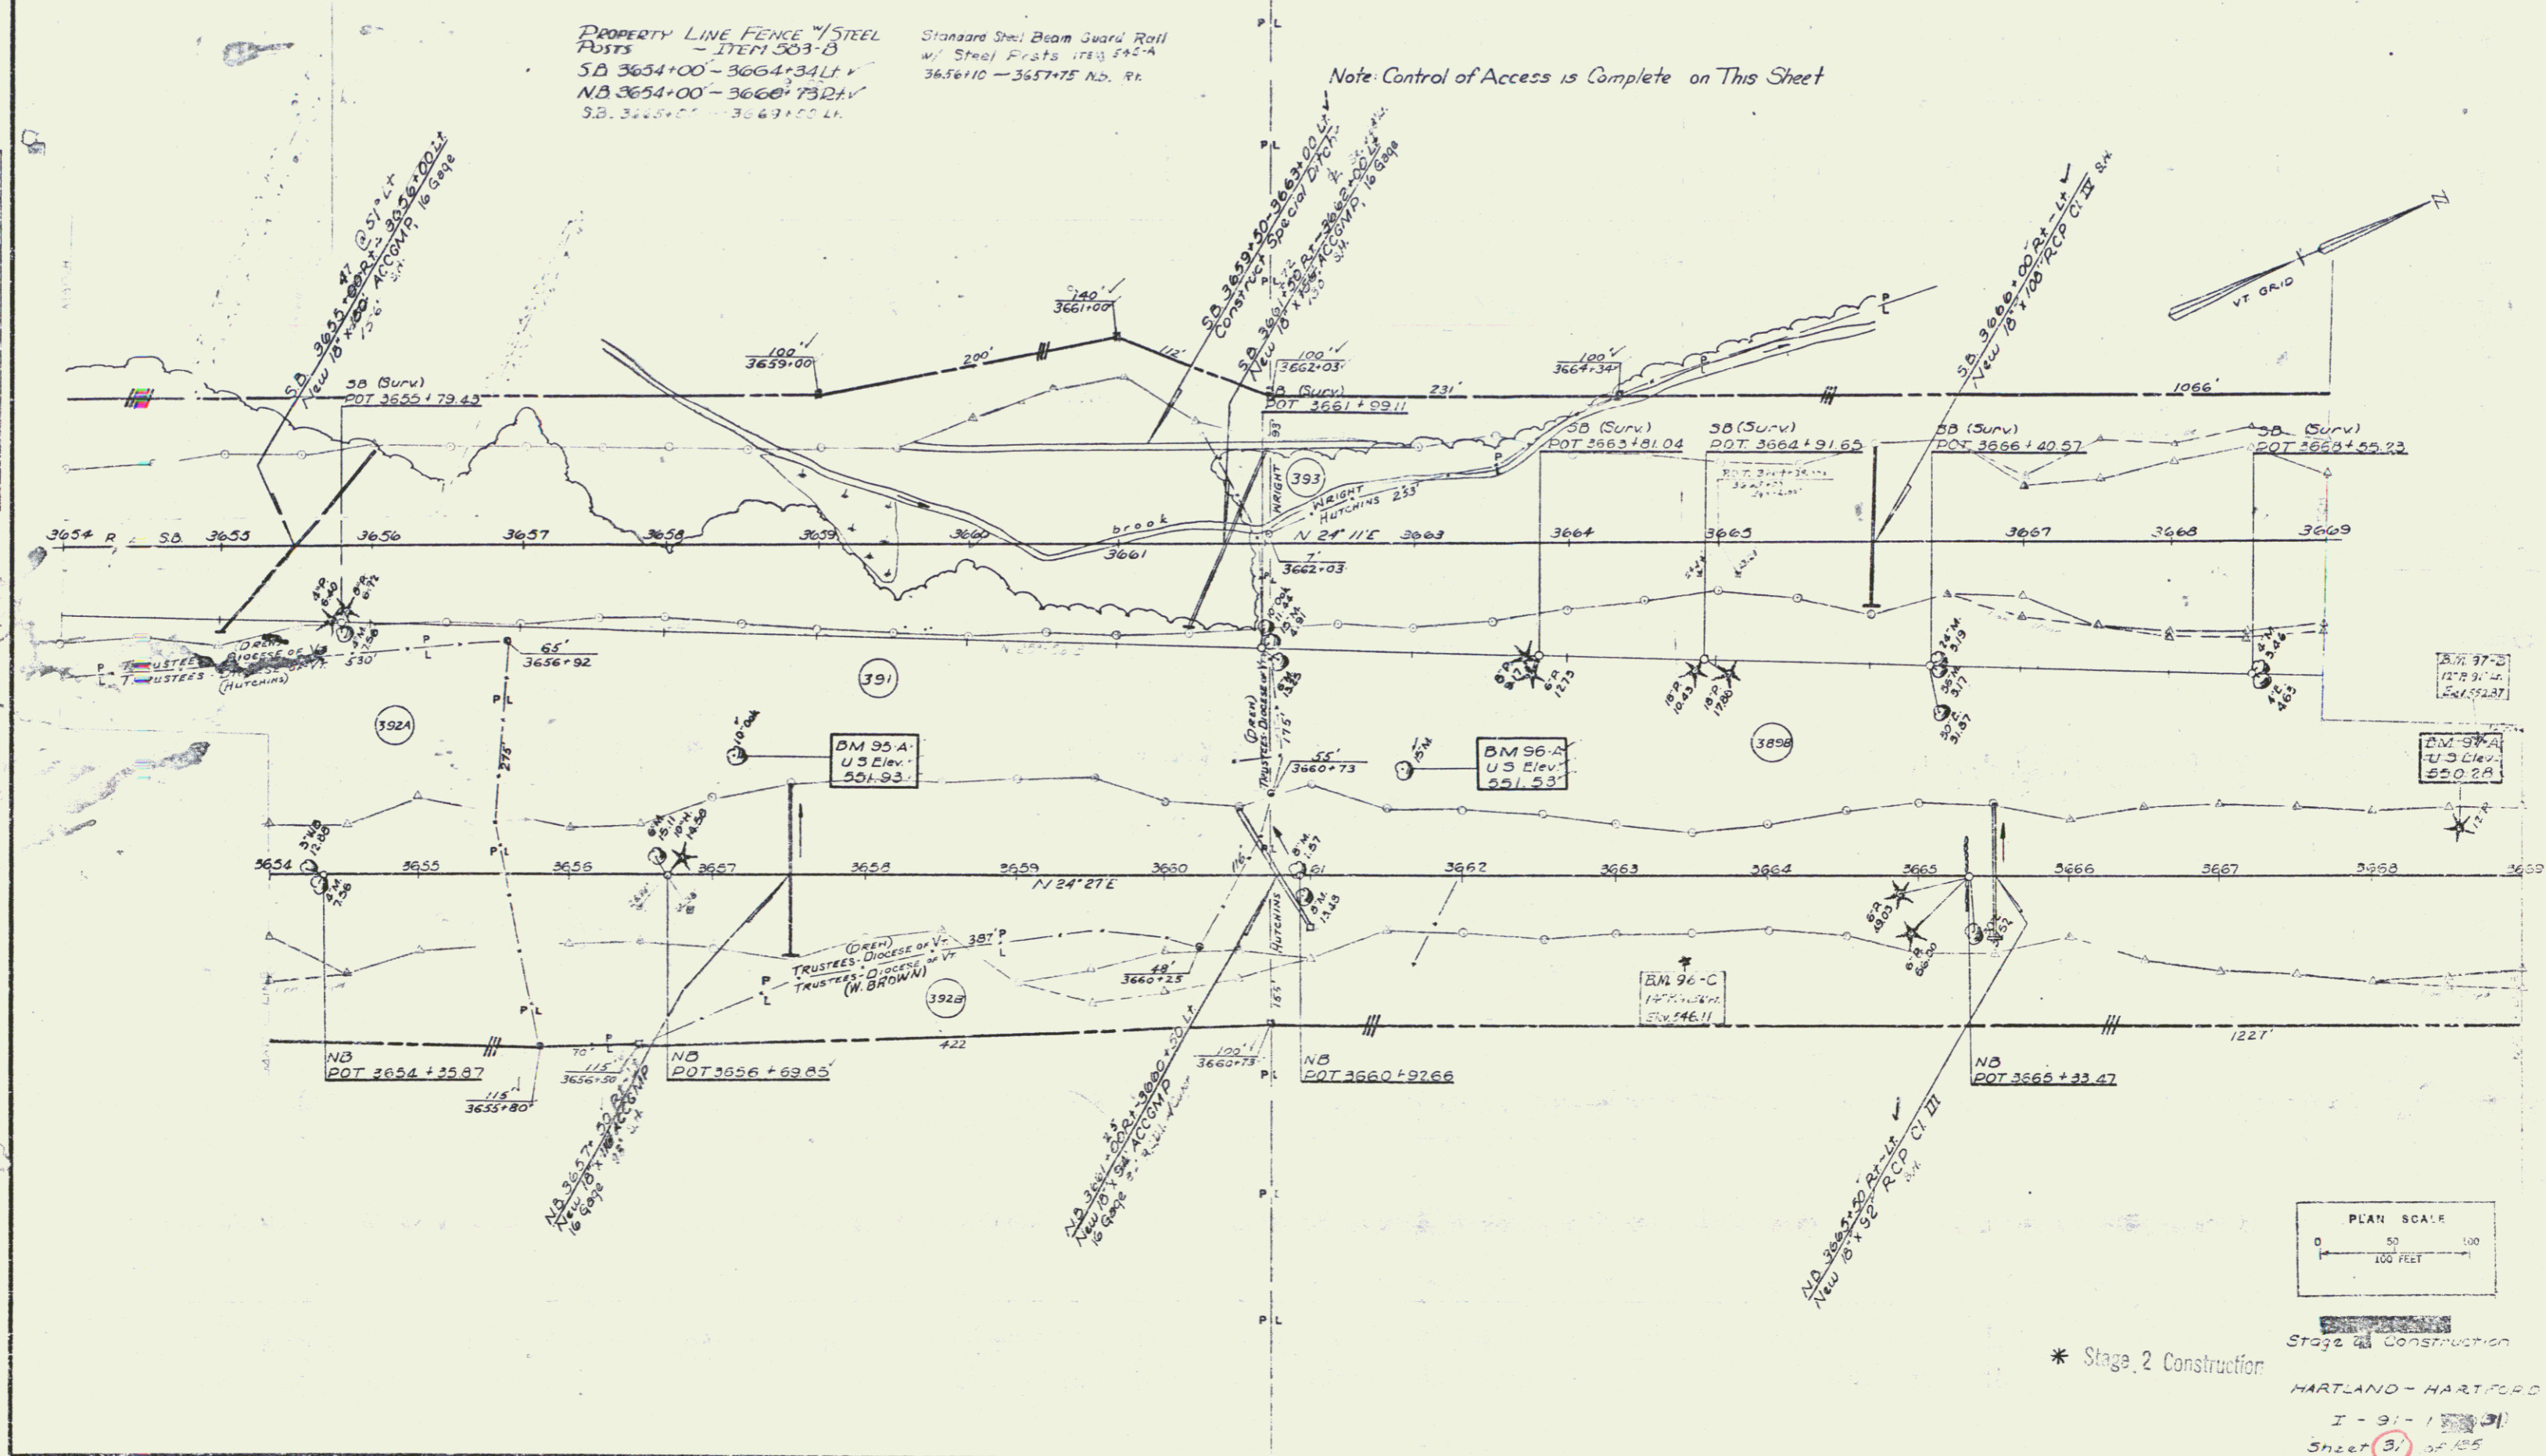

* Stage 2 Construction
Stage 2 Construction
HARTLAND - HARTFORD
I - 91 - 1 - 31
Sheet (31) of 125
Sheet 12 of 222