

NB CURVE No 1
 Δ 18° 55' 55" Lt
 D 7' 0"
 R 1204.73'
 T 426.81'
 L 846.6'
 E 31.56'
 Bnk. 1 1/8" Per Ft.

SB CURVE No 2
 Δ 21° 27' 45" Lt
 D 2' 03' 11"
 R 1790.83'
 T 528.88'
 L 1045.42'
 E 49.65'
 Bnk. 1 1/8" Per Ft.

NB CURVE No 3
 Δ 6° 37' 25" Lt
 D 0° 30"
 R 11439.16'
 T 663.10'
 L 1324.72'
 E 19.17'
 Bnk. 1/4" per ft.


NB CURVE No 4
 Δ 25° 39' 31" Lt
 D 1' 0"
 R 5729.58'
 T 1304.81'
 L 2565.86'
 E 146.55'
 Bnk. 3/8" Per Ft.

SB CURVE No 5 (Rev)
 Δ 27° 45' 00" Lt
 D 1' 0"
 R 5729.58'
 T 1415.20'
 L 2774.86'
 E 172.17'
 Bnk. 3/8" Per Ft.

T.R. #43 CURVE No 6
 Δ 26° 47' 30" Lt
 D 7' 00"
 R 313.51'
 T 194.93'
 L 382.74'
 E 22.89'
 Bnk. 3/4" per ft.

T.R. #43 CURVE No 7
 Δ 64° 00' 00" Rt
 D 10' 00"
 R 572.93'
 T 350.03'
 L 640.00'
 E 102.66'
 Bnk. 3/4" per ft.

T.R. #43 CURVE #8
 Δ 15° 25' 00" Lt
 D 3' 53' 48"
 R 1608.20'
 T 217.67'
 L 432.71'
 E 14.67'
 Bnk. 1/2" per ft.

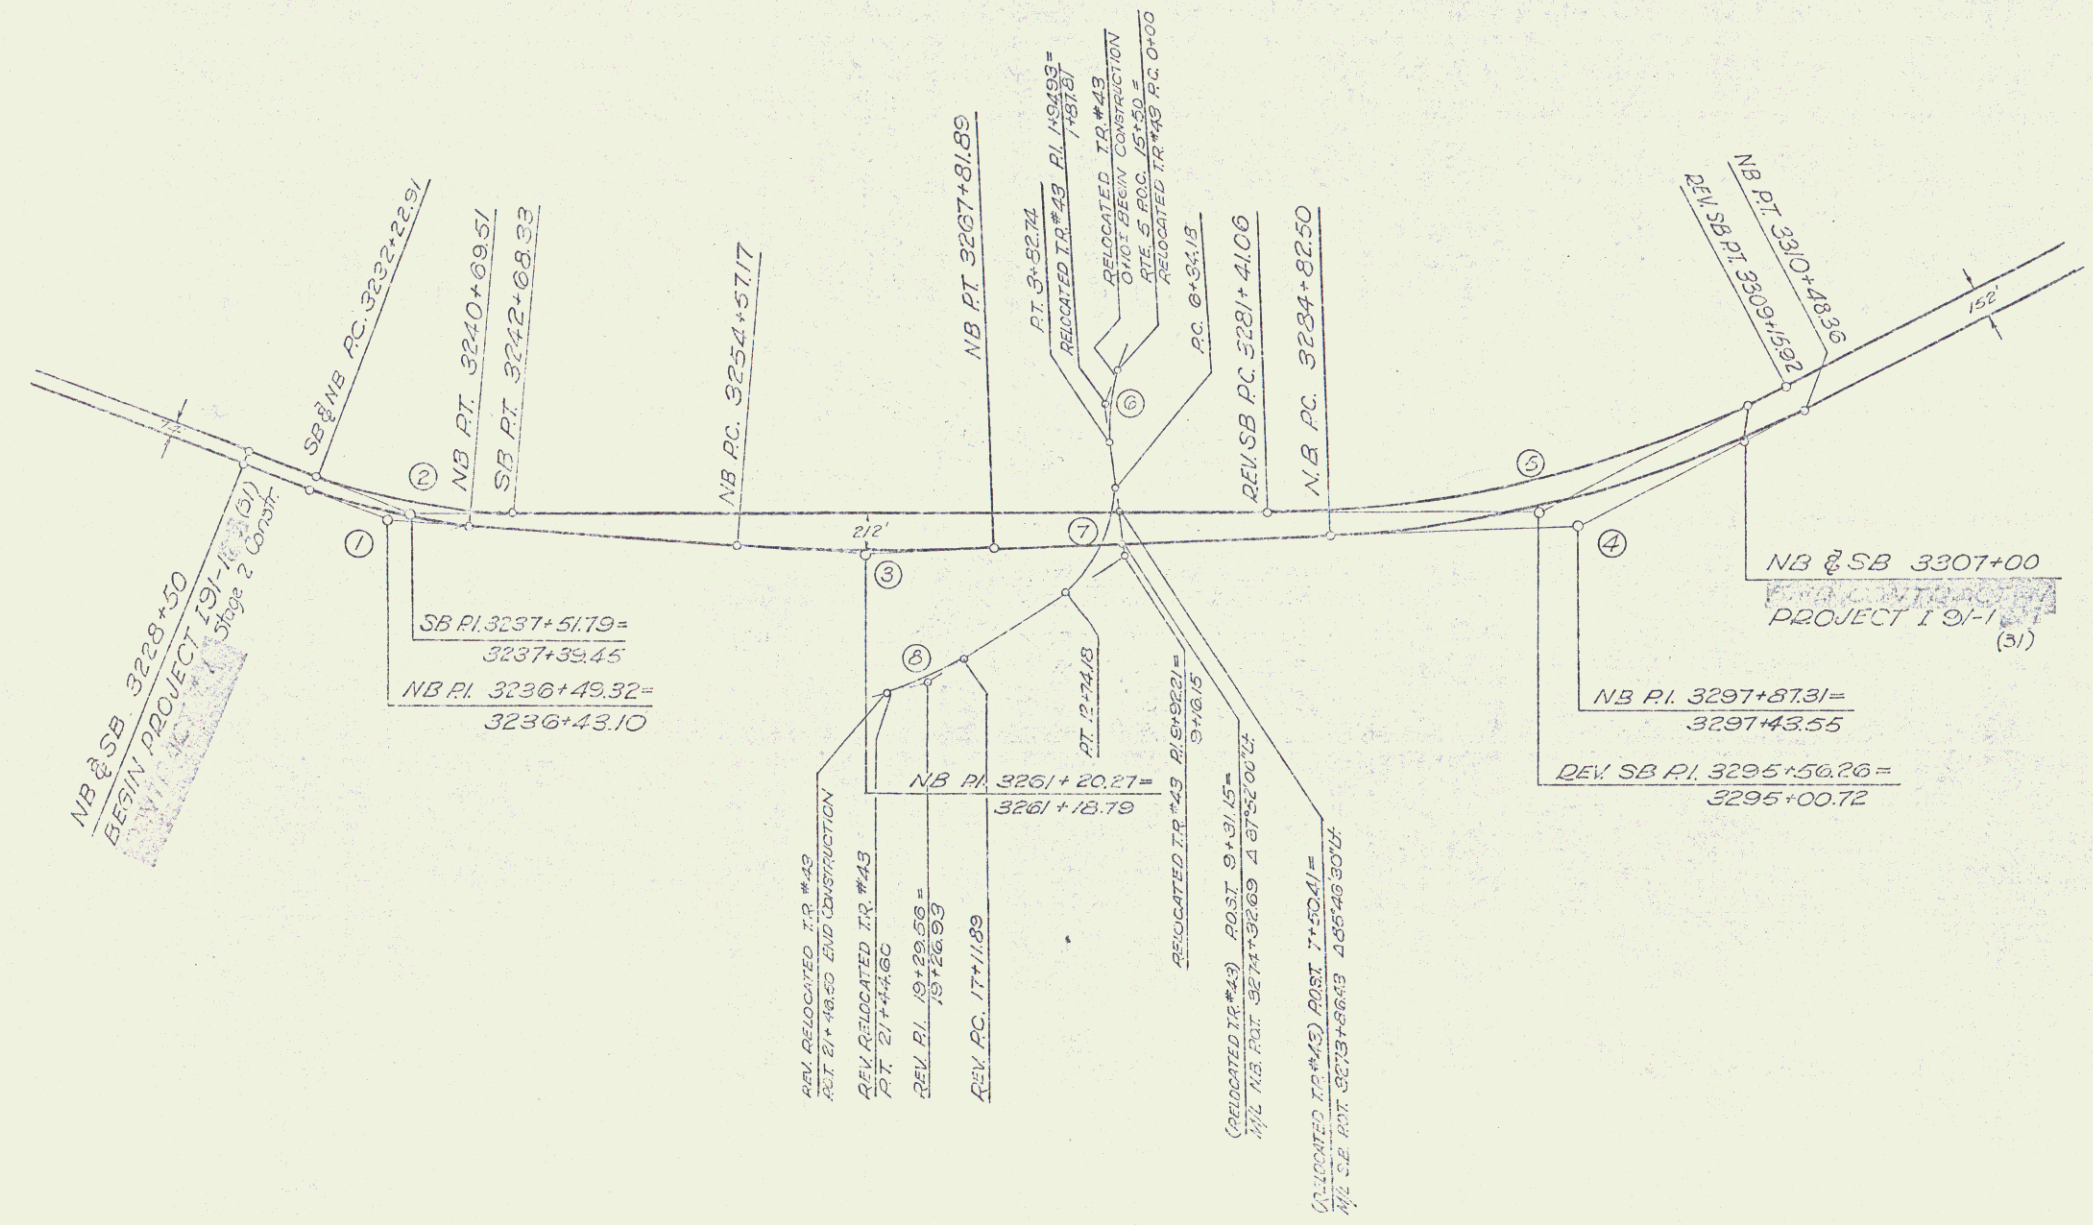

Stage 2 Construction
 ALIGNMENT SHEET
 HARTLAND-HARTFORD
 PROJ. I 9-1
 Jan. 15, '62 Scale, 1"=500'
 Sheet 2 of 232 Sheet 2 of 183